

FEE \$	- 0 -
TCP \$	- 0 -
DRAINAGE FEE \$	- 0 -

BLDG PERMIT NO. 56611
FILE # SPR-96-129

## PLANNING CLEARANCE

(site plan review, multi-family development, non-residential development)  
Grand Junction Community Development Department



\*\* THIS SECTION TO BE COMPLETED BY APPLICANT \*\*

BLDG ADDRESS <u>1340 GARRISON AVE.</u>	TAX SCHEDULE NO. <u>2945-132-00-945</u>
SUBDIVISION _____	SQ. FT. OF PROPOSED BLDG(S)/ADDITION <u>1271</u>
FILING _____ BLK _____ LOT _____	SQ. FT. OF EXISTING BLDG(S) <u>1800</u>
(1) OWNER <u>CITY OF GRAND JUNCTION</u>	NO. OF DWELLING UNITS BEFORE: _____ AFTER: _____ CONSTRUCTION
(1) ADDRESS <u>1340 GARRISON AVE.</u>	NO. OF BLDGS ON PARCEL BEFORE: <u>1</u> AFTER: <u>1</u> CONSTRUCTION
(1) TELEPHONE <u>244-1542</u>	USE OF ALL EXISTING BLDGS <u>PARKS DEPT. ADM. OFFICE</u>
(2) APPLICANT <u>SAME AS ABOVE</u>	DESCRIPTION OF WORK & INTENDED USE: <u>EXPANSION OF</u>
(2) ADDRESS <u>"</u>	<u>EXIST. BLDG. (MAINTAINING FACADE) - OFFICE USE</u>
(2) TELEPHONE <u>"</u>	

✓ Submittal requirements are outlined in the SSID (Submittal Standards for Improvements and Development) document.

\*\* THIS SECTION TO BE COMPLETED BY COMMUNITY DEVELOPMENT DEPARTMENT STAFF \*\*

ZONE <u>PZ</u>	Landscaping / Screening Required: YES <input checked="" type="checkbox"/> NO <input type="checkbox"/> <u>NEW PLANTER</u>
SETBACKS: Front _____ from Property Line (PL) or <u>40</u> from center of ROW, whichever is greater	Parking Req'mt <u>N/A Replacement Offices</u>
Side <u>0' from PL</u> Rear <u>0'</u> from PL	Special Conditions: _____
Maximum Height <u>65'</u>	
Maximum coverage of lot by structures _____	CENS.T. _____ T.ZONE _____ ANNEX # _____

Modifications to this Planning Clearance must be approved, in writing, by the Community Development Department Director. The structure authorized by this application cannot be occupied until a final inspection has been completed and a Certificate of Occupancy has been issued by the Building Department (Section 307, Uniform Building Code). Required improvements in the public right-of-way must be guaranteed prior to issuance of a Planning Clearance. All other required site improvements must be completed or guaranteed prior to issuance of a Certificate of Occupancy. Any landscaping required by this permit shall be maintained in an acceptable and healthy condition. The replacement of any vegetation materials that die or are in an unhealthy condition is required by the G.J. Zoning and Development Code.


Four (4) sets of final construction drawings must be submitted and stamped by City Engineering prior to issuing the Planning Clearance. One stamped set must be available on the job site at all times.

I hereby acknowledge that I have read this application and the information is correct; I agree to comply with any and all codes, ordinances, laws, regulations, or restrictions which apply to the project. I understand that failure to comply shall result in legal action, which may include but not necessarily be limited to non-use of the building(s).

Applicant's Signature <u>[Signature]</u>	Date <u>5-28-96</u>
Department Approval <u>[Signature]</u> <u>CP 12/4/96</u>	Date <u>6/18/96</u>
Additional water and/or sewer tap fee(s) are required: YES _____ NO <input checked="" type="checkbox"/> W/O No. <u>N/A</u>	
Utility Accounting <u>Millie Fowler</u>	Date <u>6-18-96</u>

VALID FOR SIX MONTHS FROM DATE OF ISSUANCE (Section 9-3-2C Grand Junction Zoning & Development Code)

(White: Planning)      (Yellow: Customer)      (Pink: Building Department)      (Goldenrod: Utility Accounting)

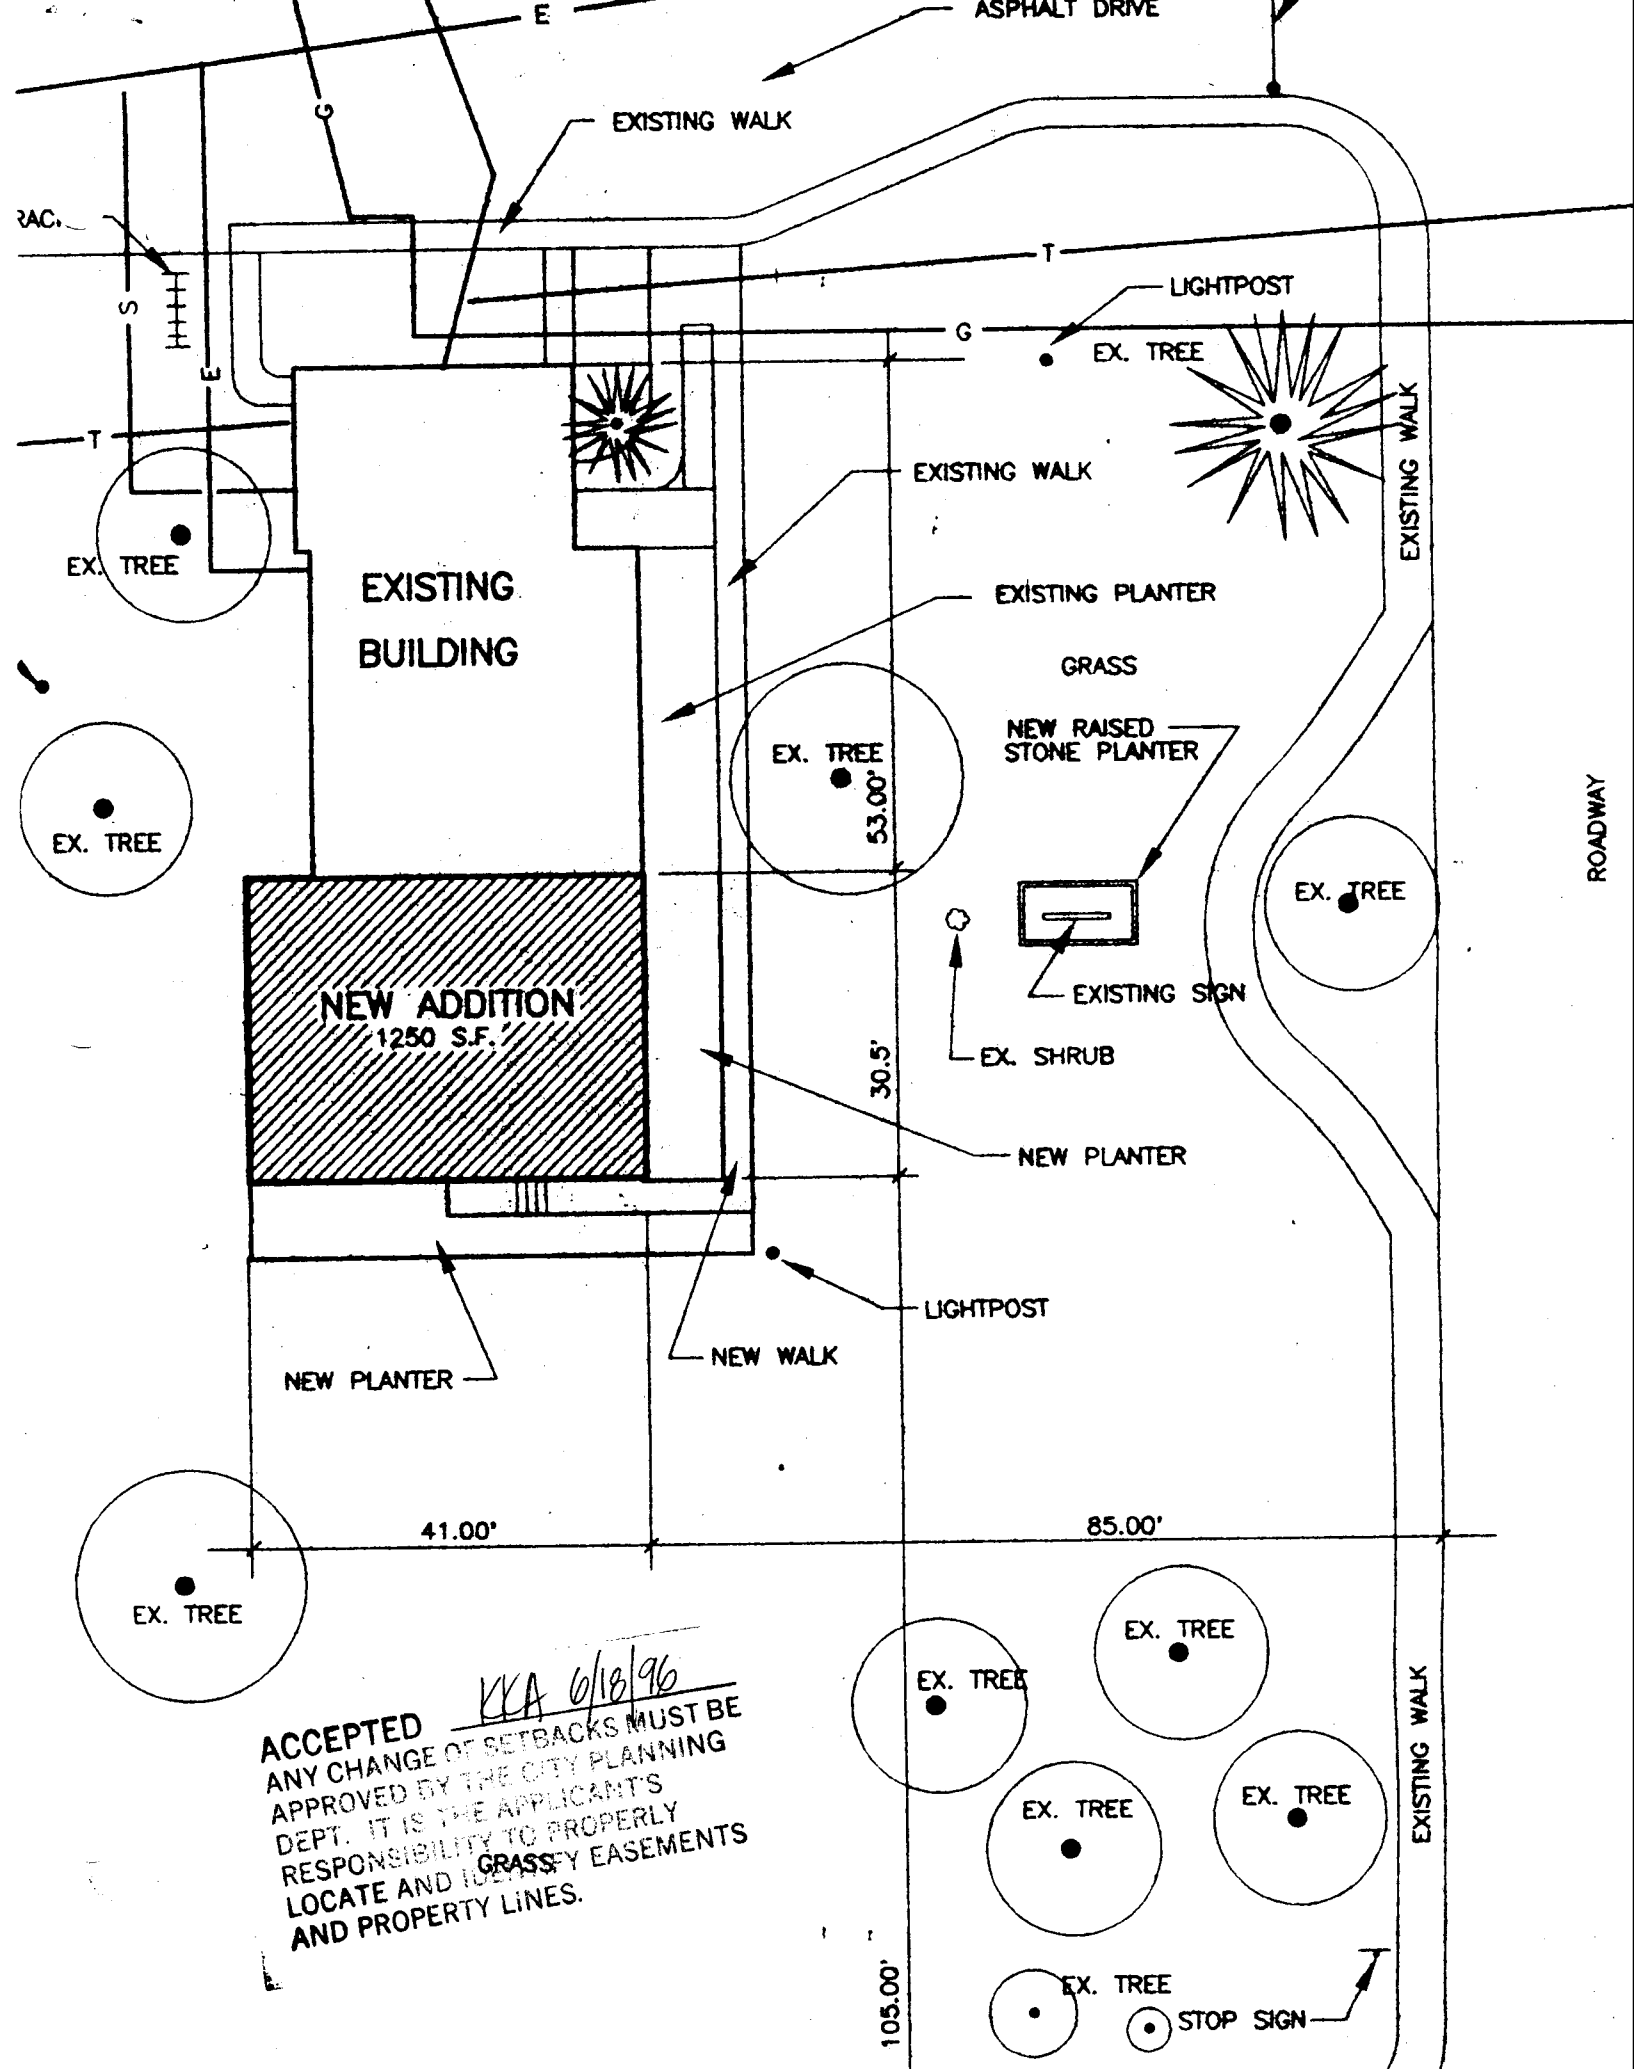

*KYA 6/18/96*

**ACCEPTED**

ANY CHANGE OF SETBACKS MUST BE APPROVED BY THE CITY PLANNING DEPT. IT IS THE APPLICANT'S RESPONSIBILITY TO PROPERLY LOCATE AND IDENTIFY EASEMENTS AND PROPERTY LINES.