FEE\$ 1000	BLDG PERMIT NO. 55 315	
(Single Family Residenti	CLEARANCE ial and Accessory Structures)	
IN THIS SECTION TO BE COMPLETED BY APPLICANT 18		
BLDG ADDRESS 2104 Linda Lane T.	AX SCHEDULE NO. 2945-121-20-010	
SUBDIVISION Linda Lane Subdivisions	Q. FT. OF PROPOSED BLDG(S)/ADDITION	
FILING BLK LOT S	Q. FT. OF EXISTING BLDG(S)	
	O. OF DWELLING UNITS EFORE:AFTER:THIS CONSTRUCTION	
	O. OF BLDGS ON PARCEL EFORE: AFTER: THIS CONSTRUCTION	
(2) APPLICANT Matthew L. Lucas U	SE OF EXISTING BLDGS Carport & storage	
12 ADDRESS 2104 Linda Lans D	ESCRIPTION OF WORK AND INTENDED USE: enclose corpor	
(2) TELEPHONE 970 241-0839 #	out wall on south side a garage door on from	
REQUIRED: Two (2) plot plans, on 8 1/2" x 11" paper, showing all existing and proposed structure location(s), parking, setbacks to all property lines, ingress/egress to the property, and all easements and rights-of-way which abut the parcel.		
🖙 THIS SECTION TO BE COMPLETED BY COMMUNITY DEVELOPMENT DEPARTMENT STAFF 🐲		
ZONE RSF-8	Maximum coverage of lot by structures $45\%$	
SETBACKS: Front from property line (PL) or from center of ROW, whichever is greater	Parking Req'mt	
Side <u>3</u> from PL Rear <u>3</u> from PL	Special Conditions	
Maximum Height 32 '	CENS.T. 6_ T.ZONE 28 ANNX#	

Modifications to this Planning Clearance must be approved, in writing, by the Director of the Community Development Department. The structure authorized by this application cannot be occupied until a final inspection has been completed and a Certificate of Occupancy has been issued by the Building Department (Section 305, Uniform Building Code).

I hereby acknowledge that I have read this application and the information is correct; I agree to comply with any and all codes, ordinances, laws, regulations or restrictions which apply to the project. I understand that failure to comply shall result in legal action, which may include but not necessarily be limited to non-use of the building(s).

Applicant Signature 122011111	Date 3/8/96
Department Approval	Date 3-8-94
Additional water and/or sewer tap fee(s) are required: YES NO	WIONO 36132150-043
Utility Accounting Detter Acces	Date 3/8/96

VALID FOR SIX MONTHS FROM DATE OF ISSUANCE (Section 9-3-2C Grand Junction Zoning & Development Code)

(White: Planning)

(Yellow: Customer)


(Pink: Building Department)

(Goldenrod: Utility Accounting)

2104 Linda Lane Grand Junction, CO 81501

France

90 × 145

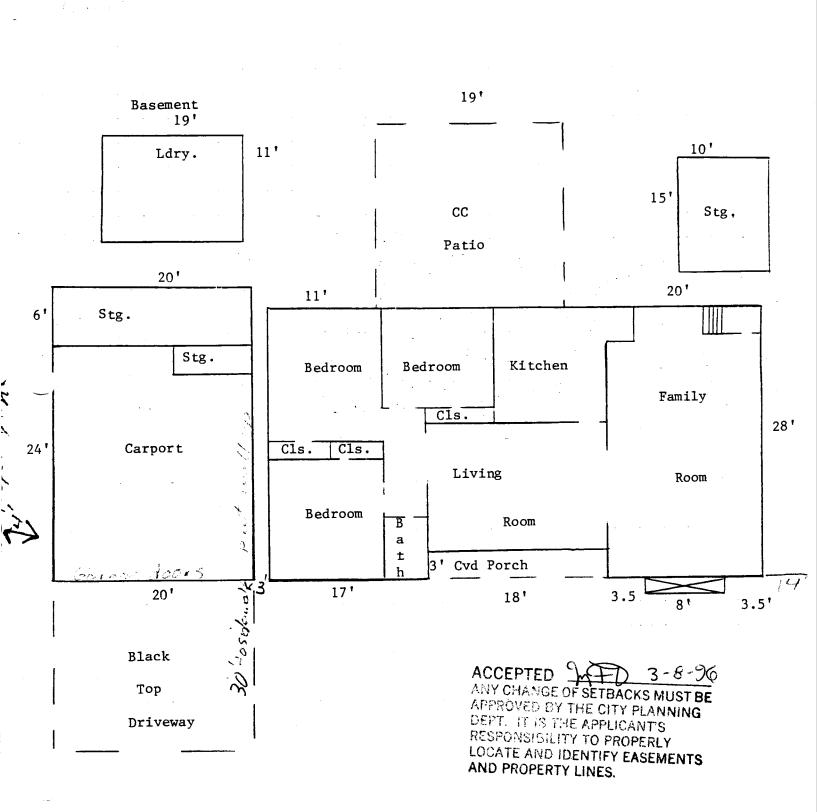

- z