•	<u> </u>	
-	FEE\$	1000
	TCP\$	D

3129-4160

(White: Planning)

(Yellow: Customer)

BLDG PERMIT NO.	5	7565

(Goldenrod: Utility Accounting)

## PLANNING CLEARANCE


(Single Family Residential and Accessory Structures)


<u>Grand Junction Community Development Department</u>

## ™ THIS SECTION TO BE COMPLETED BY APPLICANT 🖘

BLDG ADDRESS 724 MONUMENT VIEW D.	TAX SCHEDULE NO. 2701 - 334 - 19 - 203			
	SQ. FT. OF PROPOSED BLDG(S)/ADDITION			
FILING 2 BLK 3 LOT 4	SQ. FT. OF EXISTING BLDG(S)			
(1) OWNER PACE ENTERPRISES INC. (1) ADDRESS PO. BOX 40572 G.J. 815	NO. OF DWELLING UNITS  BEFORE: ONE THIS CONSTRUCTION			
(1) TELEPHONE <u>434 - 5430</u>	NO. OF BLDGS ON PARCEL BEFORE: AFTER: THIS CONSTRUCTION			
(2) APPLICANT YERNON PACE	USE OF EXISTING BLDGS			
(2) ADDRESS				
(2) TELEPHONE	Single FAMILY RESIDENCE			
	r, showing all existing and proposed structure location(s), parking, erty, and all easements and rights-of-way which abut the parcel.			
zone	OMMUNITY DEVELOPMENT DEPARTMENT STAFF ®  Maximum coverage of lot by structures			
SETBACKS: Front <u>20</u> from property line (PL) or from center of ROW, whichever is greater	Parking Req'mt			
Side 5 from PL Rear 15 from F	Special ConditionsPL			
Maximum Height	census tract 9 traffic zone 9			
Modifications to this Planning Clearance must be approved, in writing, by the Director of the Community Development Department. The structure authorized by this application cannot be occupied until a final inspection has been completed and a Certificate of Occupancy has been issued by the Building Department (Section 305, Uniform Building Code).  I hereby acknowledge that I have read this application and the information is correct; I agree to comply with any and all codes,				
	o the project. I understand that failure to comply shall result in legal			
Applicant Signature // Jane	Date 7-//-/6			
Department Approval Suita f Cos	tella- pate 9/18/96			
dditional water and/or sewer tap fee(s) are required: Y	res NO w/o No 952			
Utility Accounting 105 ft.	121 Date 7-18-96			
VALID FOR SIX MONTHS FROM DATE OF ISSUANCE	(Section 9-3-2C Grand Junction Zoning & Development Code)			

(Pink: Building Department)

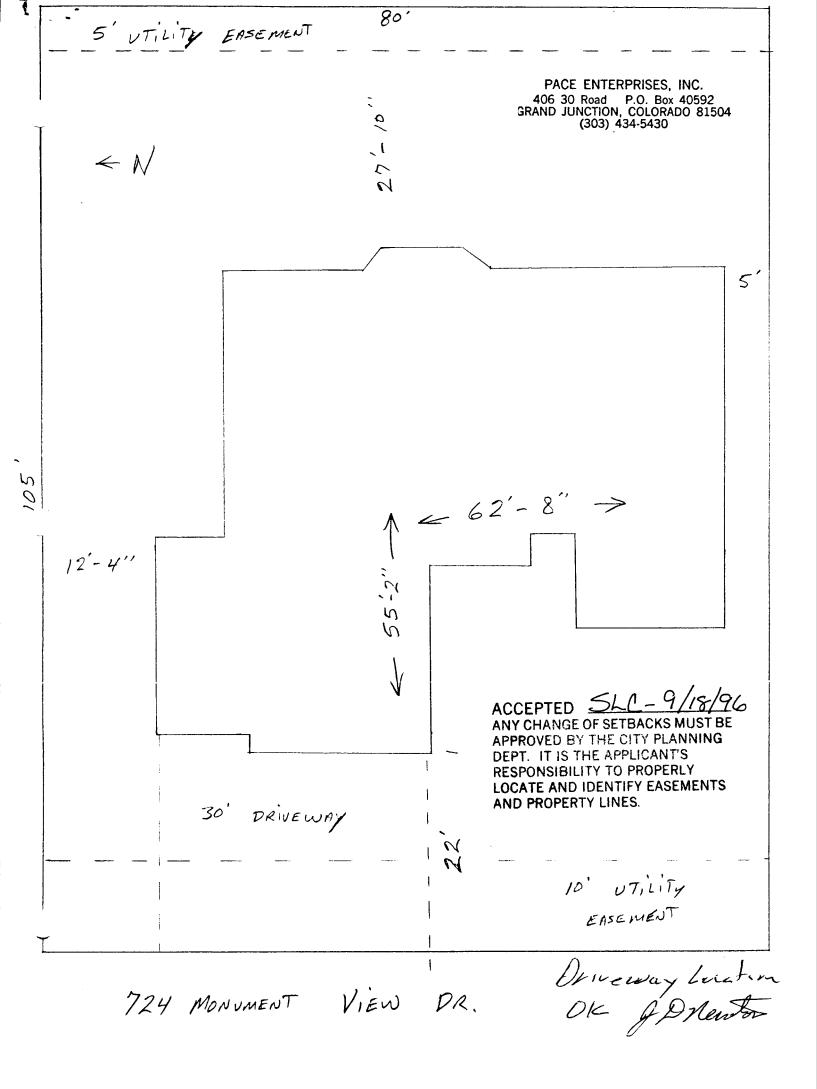

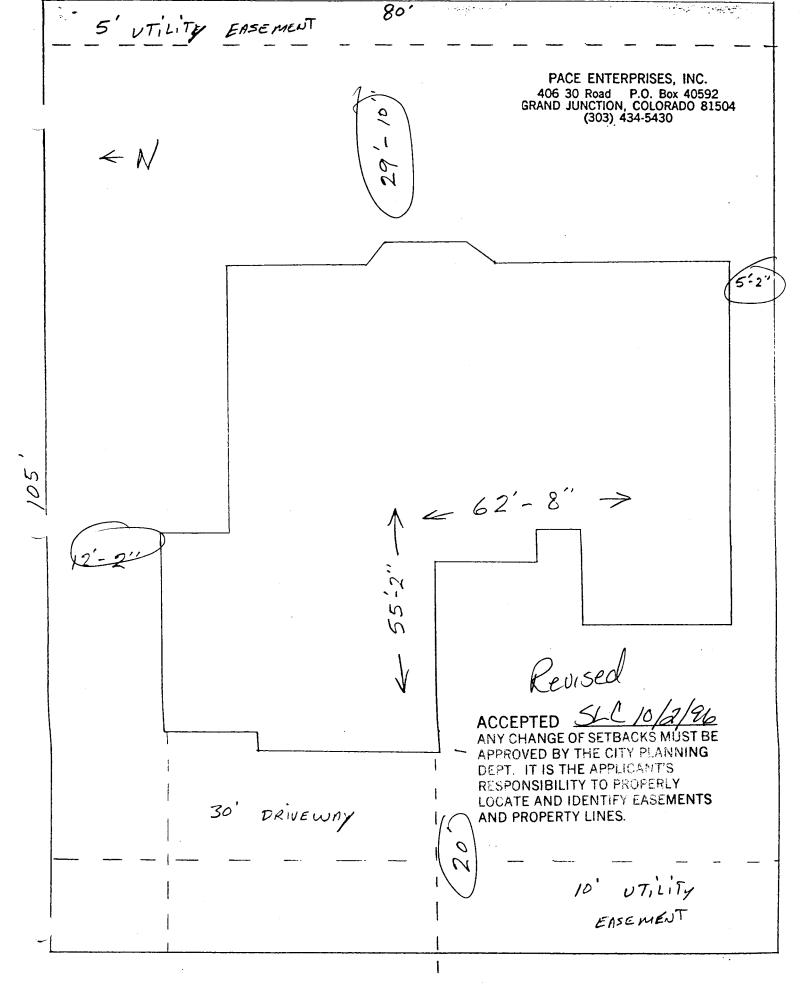

724 MONUMENT VIEW DR.