

Planning \$ <u>500</u>	Drainage \$ <u>—</u>
TCP \$ <u>—</u>	School Impact \$ <u>—</u>

BLDG PERMIT NO. <u>58642</u>
FILE #

## PLANNING CLEARANCE

(site plan review, multi-family development, non-residential development)

**Grand Junction Community Development Department**

\* THIS SECTION TO BE COMPLETED BY APPLICANT \*

BLDG ADDRESS <u>2692 Hwy 50</u>	TAX SCHEDULE NO. <u>2945-261-29-002</u>
SUBDIVISION <u>Mesa Plaza</u>	SQ. FT. OF PROPOSED BLDG(S)/ADDITION _____
FILING <u>—</u> BLK <u>—</u> LOT <u>2</u>	SQ. FT. OF EXISTING BLDG(S) <u>3500<sup>#</sup></u>
(1) OWNER <u>KANSAS City Life</u>	NO. OF DWELLING UNITS BEFORE: _____ AFTER: _____ CONSTRUCTION
(1) ADDRESS <u>PO Box 2206</u>	NO. OF BLDGS ON PARCEL BEFORE: <u>2</u> AFTER: <u>2</u> CONSTRUCTION
(1) TELEPHONE <u>245-6411</u>	USE OF ALL EXISTING BLDGS <u>Shopping Center</u>
(2) APPLICANT <u>Roape Const. Inc</u>	DESCRIPTION OF WORK & INTENDED USE: <u>Retail</u>
(2) ADDRESS <u>105 Canary Ln</u>	<u>Interior Remodel</u>
(2) TELEPHONE <u>241-2063</u>	

✓ Submittal requirements are outlined in the SSID (Submittal Standards for Improvements and Development) document.

\* THIS SECTION TO BE COMPLETED BY COMMUNITY DEVELOPMENT DEPARTMENT STAFF \*

ZONE <u>PB</u>	Landscaping / Screening Required: YES _____ NO _____
SETBACKS: Front _____ from Property Line (PL) or _____ from center of ROW, whichever is greater	Parking Req'mt _____
Side _____ from PL Rear _____ from PL	Special Conditions: <u>1666<sup>#</sup> Retail - Interior Remodel (# office) (#191-94 #26-82)</u>
Maximum Height _____	Census Tract _____ Traffic Zone _____ Annx # _____
Maximum coverage of lot by structures _____	

Modifications to this Planning Clearance must be approved, in writing, by the Community Development Department Director. The structure authorized by this application cannot be occupied until a final inspection has been completed and a Certificate of Occupancy has been issued by the Building Department (Section 307, Uniform Building Code). Required improvements in the public right-of-way must be guaranteed prior to issuance of a Planning Clearance. All other required site improvements must be completed or guaranteed prior to issuance of a Certificate of Occupancy. Any landscaping required by this permit shall be maintained in an acceptable and healthy condition. The replacement of any vegetation materials that die or are in an unhealthy condition is required by the G.J. Zoning and Development Code.

Four (4) sets of final construction drawings must be submitted and stamped by City Engineering prior to issuing the Planning Clearance. One stamped set must be available on the job site at all times.


I hereby acknowledge that I have read this application and the information is correct; I agree to comply with any and all codes, ordinances, laws, regulations, or restrictions which apply to the project. I understand that failure to comply shall result in legal action, which may include but not necessarily be limited to non-use of the building(s).

Applicant's Signature <u>[Signature]</u>	Date <u>12/18/96</u>
Department Approval <u>[Signature]</u>	Date <u>12/18/96</u>
Additional water and/or sewer tap fee(s) are required: YES _____ NO <input checked="" type="checkbox"/> W/O No. _____	
Utility Accounting <u>[Signature]</u>	Date <u>12-23-96</u>

VALID FOR SIX MONTHS FROM DATE OF ISSUANCE (Section 9-3-2C Grand Junction Zoning & Development Code)

(White: Planning)      (Yellow: Customer)      (Pink: Building Department)      (Goldenrod: Utility Accounting)

Page - 244-0616

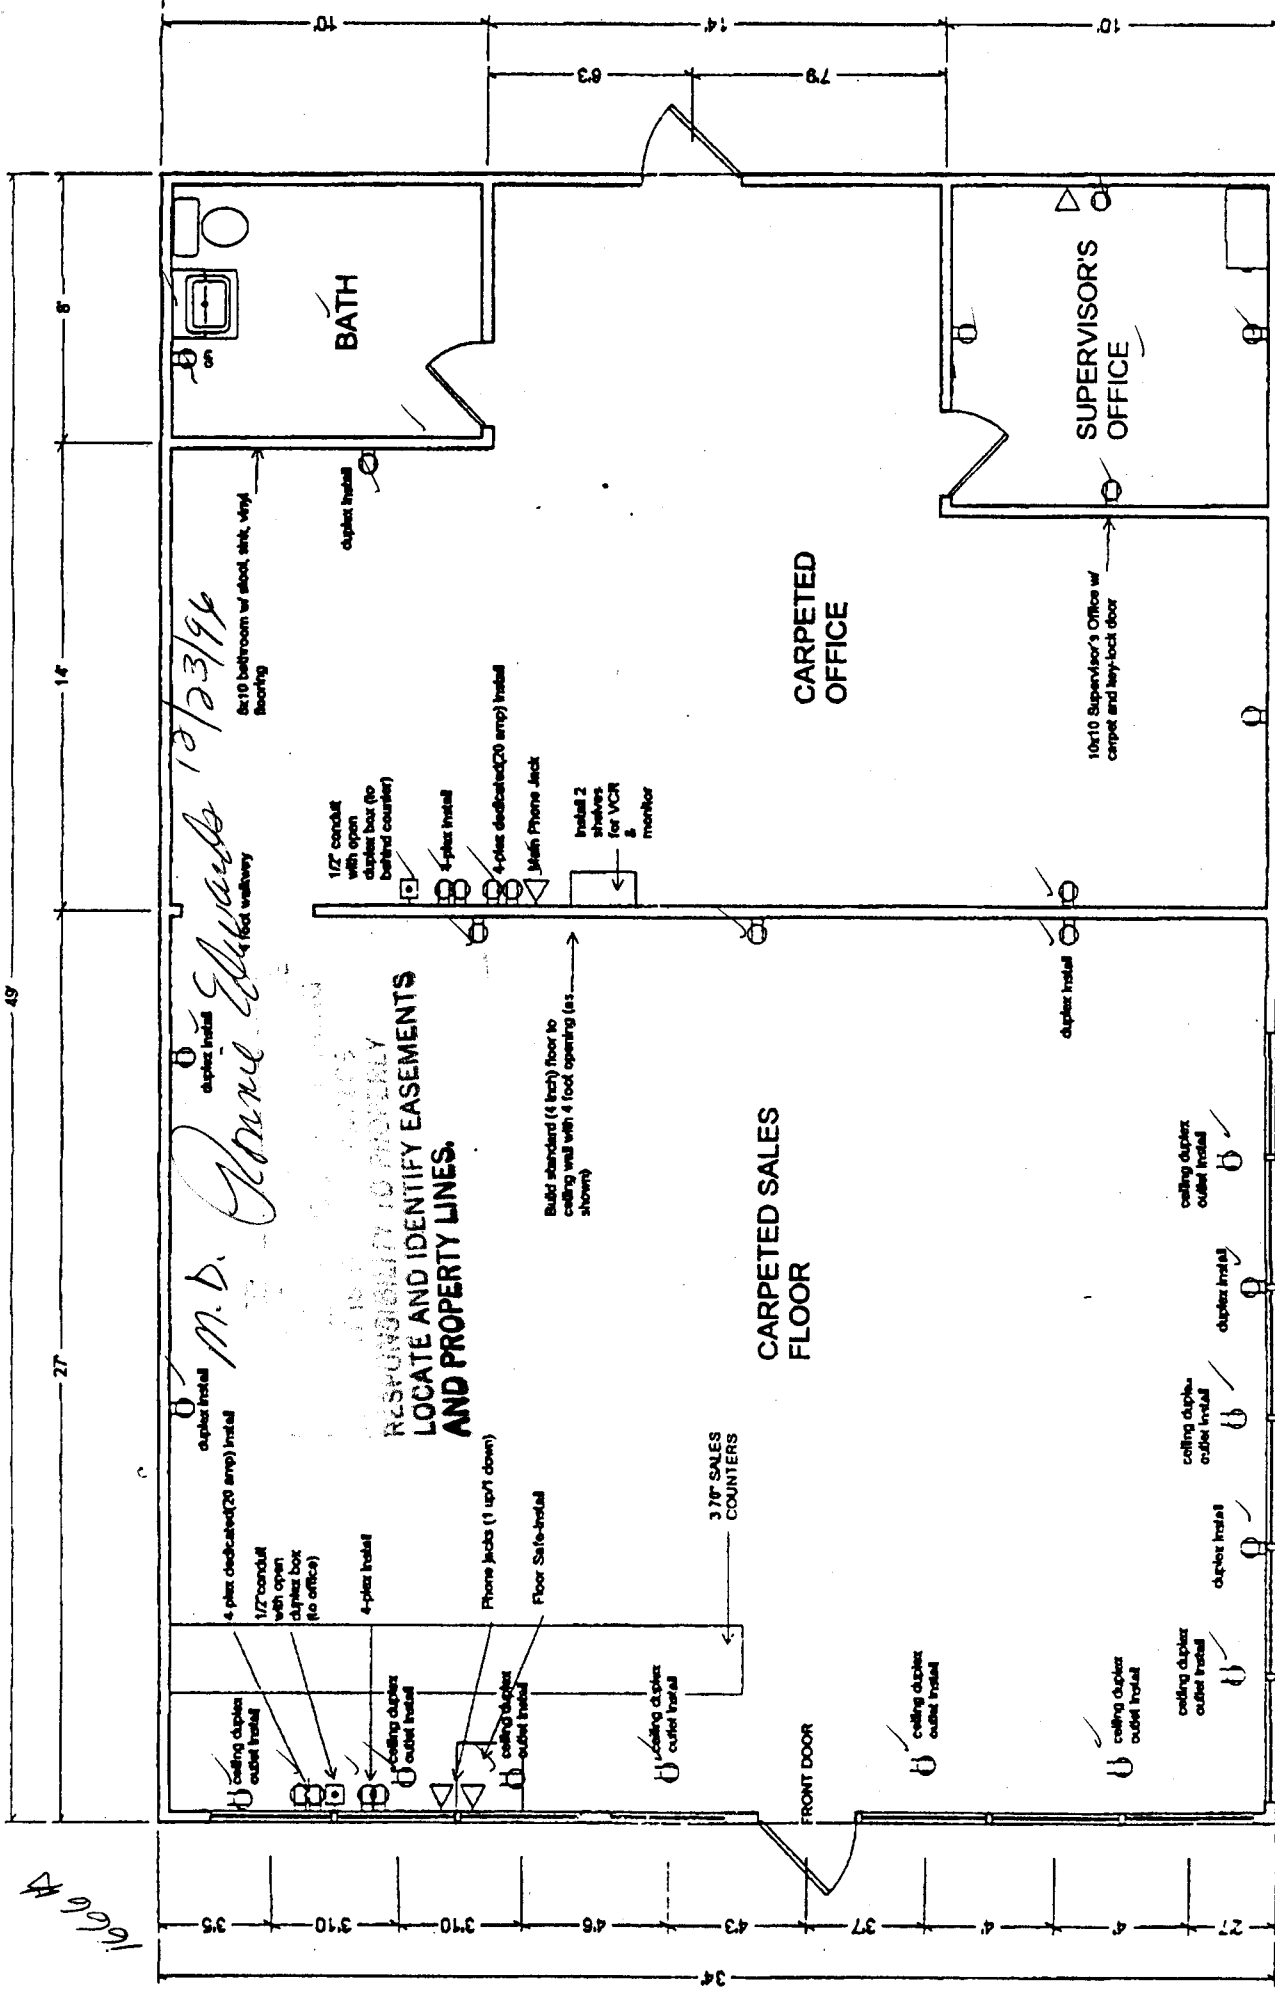

1666A 34 27 4 4 37 43 46 310 310 310 35

14 8 10 14 10 78 83 14 10


*M.D. Gene Edwards 10/23/96*

**RESPONSIBILITY TO PROPERLY LOCATE AND IDENTIFY EASEMENTS AND PROPERTY LINES.**

*2692 Hwy 50 previously was insurance office*

27 Road

B 3/4 Road

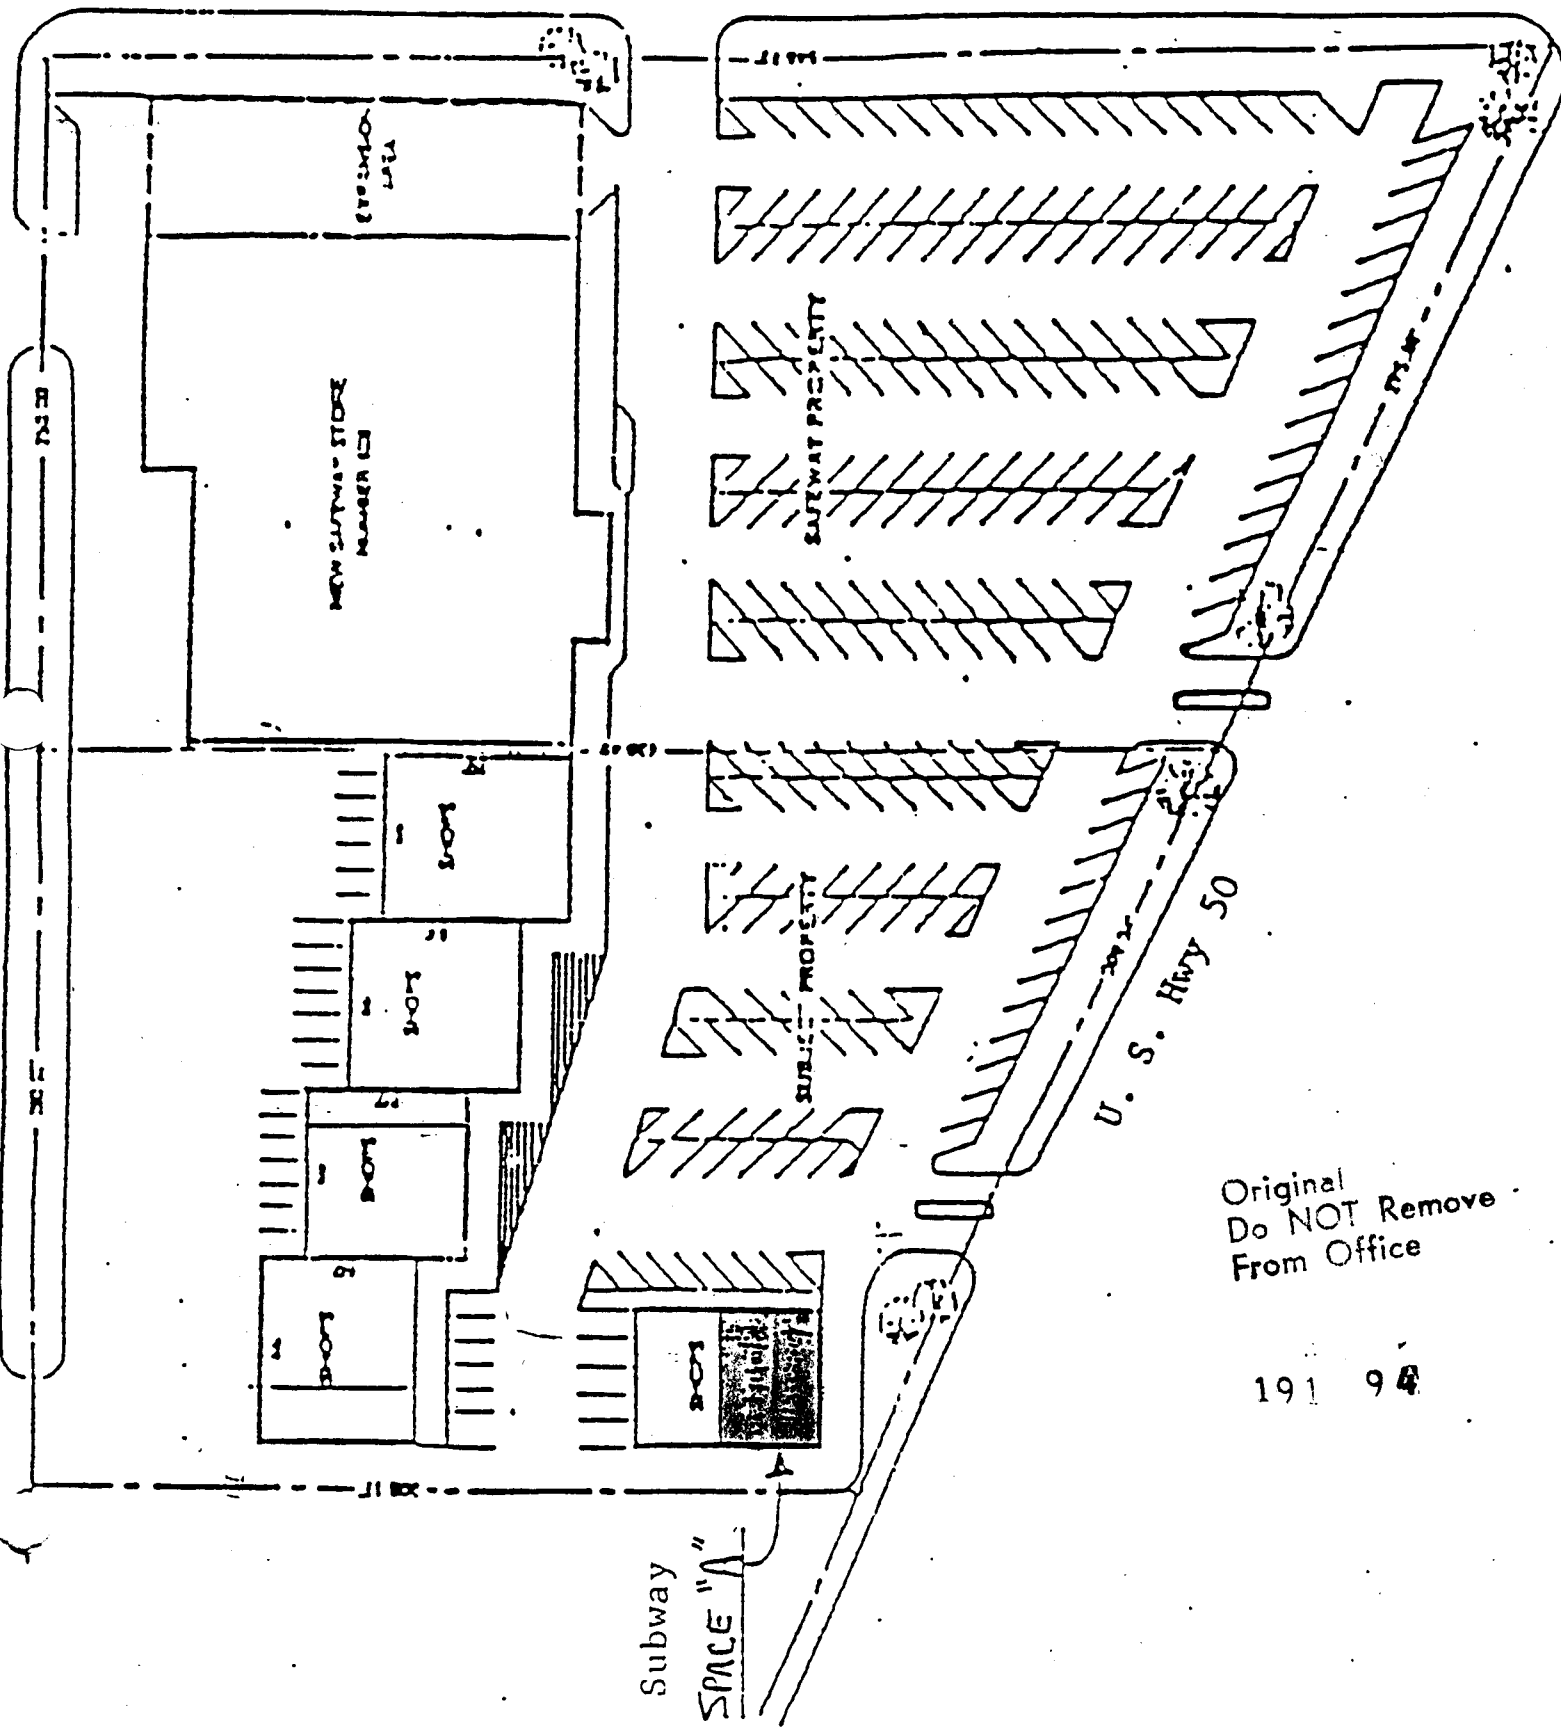

Original  
Do NOT Remove  
From Office

191 94