

FEE \$	10
TCP \$	500

BLDG PERMIT NO. 55392

PLANNING CLEARANCE
 (Single Family Residential and Accessory Structures)
 Grand Junction Community Development Department



THIS SECTION TO BE COMPLETED BY APPLICANT

BLDG ADDRESS 587 Pioneer TAX SCHEDULE NO. 2943-081-00-045
 SUBDIVISION Cody SQ. FT. OF PROPOSED BLDG(S)/ADDITION 1409
 FILING 4 BLK 2 LOT 11 SQ. FT. OF EXISTING BLDG(S) _____
 (1) OWNER John Davis NO. OF DWELLING UNITS
 BEFORE: 0 AFTER: 1 THIS CONSTRUCTION
 (1) ADDRESS _____
 (1) TELEPHONE 243-7711 NO. OF BLDGS ON PARCEL
 BEFORE: 0 AFTER: 1 THIS CONSTRUCTION
 (2) APPLICANT CASTLE CONST USE OF EXISTING BLDGS _____
 (2) ADDRESS 3068 Dupont Cir CO 81504 DESCRIPTION OF WORK AND INTENDED USE: _____
 (2) TELEPHONE 248-4638 Single Family

REQUIRED: Two (2) plot plans, on 8 1/2" x 11" paper, showing all existing and proposed structure location(s), parking, setbacks to all property lines, ingress/egress to the property, and all easements and rights-of-way which abut the parcel.

THIS SECTION TO BE COMPLETED BY COMMUNITY DEVELOPMENT DEPARTMENT STAFF

ZONE PR4.4 Maximum coverage of lot by structures _____
 SETBACKS: Front 20 from property line (PL) Parking Req'mt _____
 or _____ from center of ROW, whichever is greater
 Side 5 from PL Rear 10 from PL Special Conditions _____
or easements
 Maximum Height _____ CENS.T. 11 T.ZONE 51 ANN# _____

Modifications to this Planning Clearance must be approved, in writing, by the Director of the Community Development Department. The structure authorized by this application cannot be occupied until a final inspection has been completed and a Certificate of Occupancy has been issued by the Building Department (Section 305, Uniform Building Code).


I hereby acknowledge that I have read this application and the information is correct, I agree to comply with any and all codes, ordinances, laws, regulations or restrictions which apply to the project. I understand that failure to comply shall result in legal action, which may include but not necessarily be limited to non-use of the building(s).

Applicant Signature [Signature] Date 3/9/96
 Department Approval Glennie Edwards Date 3/15/96

Additional water and/or sewer tap fee(s) are required: YES NO _____ W/O No. WD 9027 - S/F
 Utility Accounting Millie Fowler Date 3-15-96

VALID FOR SIX MONTHS FROM DATE OF ISSUANCE (Section 9-3-2C Grand Junction Zoning & Development Code)

(White: Planning) (Yellow: Customer) (Pink: Building Department) (Goldenrod: Utility Accounting)

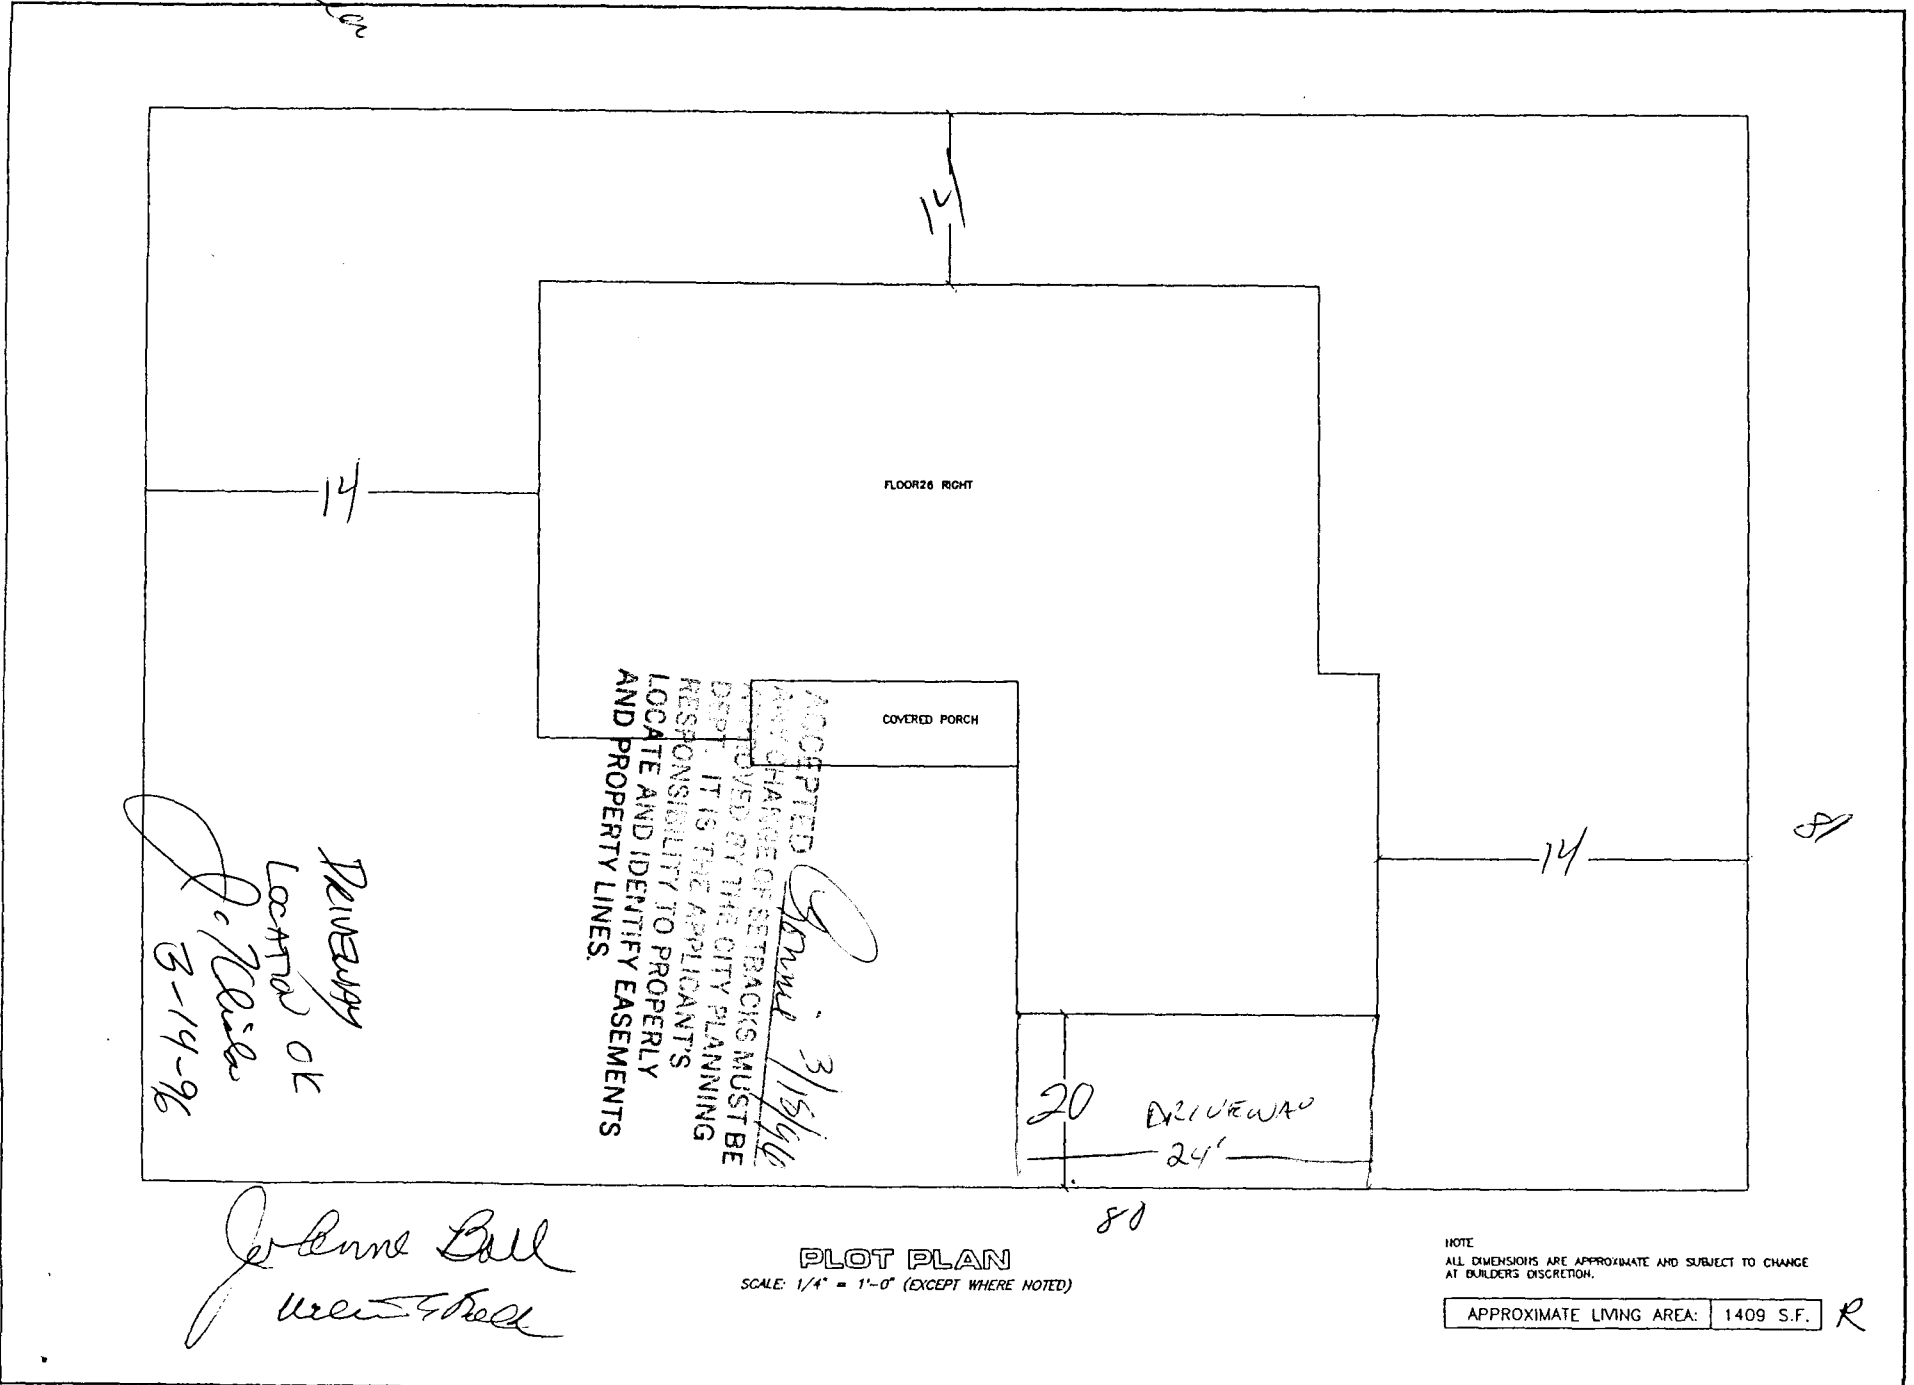

58' 11"

*DRIVEWAY
LOCATED OK
J. Collins
3-14-96*

ACCEPTED
AND CHARGE OF SETBACKS MUST BE
DEPT. IT IS THE APPLICANT'S
RESPONSIBILITY TO PROPERLY
LOCATE AND IDENTIFY EASEMENTS
AND PROPERTY LINES.

General 3/15/96

*Johnnie Ball
Westwood*

PLOT PLAN

SCALE: 1/4" = 1'-0" (EXCEPT WHERE NOTED)


NOTE:
ALL DIMENSIONS ARE APPROXIMATE AND SUBJECT TO CHANGE
AT BUILDERS DISCRETION.

APPROXIMATE LIVING AREA: 1409 S.F.

R

REVISIONS	
1	
2	
3	
4	
5	
6	
7	
8	

AutoBRAFT
COMPUTER AIDED DRAFTING
1991 531-1144

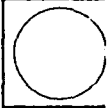

**CASTLE
CONSTRUCTION**

DATE	
AUTOCAD	
REV	
1202-PLT.DWG	
PK	
1-26-98	
1/4" = 1'-0"	
1 OF 1	