
FEE \$ /0	BLDG PERMIT NO. 54010
PLANNIN (Single Family Reside	IG CLEARANCE ential and Accessory Structures) nunity Development Department
027-1680-02-4 🖙 This section to bi	E COMPLETED BY APPLICANT 📾
BLDG ADDRESS 786 N Sodona (14 Gro.d Sundian, CD 81504	TAX SCHEDULE NO. 270/35/53003
SUBDIVISION Sedona	SQ. FT. OF PROPOSED BLDG(S)/ADDITION 14×14
FILING 2 BLK LOT 3	SQ. FT. OF EXISTING BLDG(S) 3202 #
(1) OWNER Carl + Elizabeth Frighal.	NO. OF DWELLING UNITS THIS CONSTRUCTION
(1) ADDRESS 786 N Sedena (+ SY (0 81506 (1) TELEPHONE 970-241-3219 (+m)	NO. OF BLDGS ON PARCEL BEFORE: AFTER: THIS CONSTRUCTION
(2) APPLICANT SAME	USE OF EXISTING BLDGS home
(2) ADDRESS	DESCRIPTION OF WORK AND INTENDED USE:
(2) TELEPHONE 970-248-4900 (WK)	New Gaide Sheel
$\sum \frac{2}{2} $	OMMUNITY DEVELOPMENT DEPARTMENT STAFF 100 Maximum coverage of lot by structures
SETBACKS: Front from property line (PL)) Parking Req'mt
from center of ROW, whichever is greater	Special Conditions no ouchangs in
Side from PL Rear from F or easemts.	lasements.
Maximum Height	- CENSUS TRACT 16 TRAFFIC ZONE 3
	proved, in writing, by the Director of the Community Development cannot be occupied until a final inspection has been completed and ding Department (Section 305, Uniform Building Code).
	d the information is correct; I agree to comply with any and all codes, to the project. I understand that failure to comply shall result in legal I to non-use of the building(s).
Applicant Signature	Date/24 /76
Department ApprovalKonnie Wi	Date 4/26/96
ditional water and/or sewer tap fee(s) are required:	YES NO NO. N/A - no chan
Utility Accounting Willie Joule	Date 4 26-96
VALID FOR SIX MONTHS FROM DATE OF ISSUANC	

Ì

(Yellow: Customer) (Pink: Building Department)

(Goldenrod: Utility Accounting)

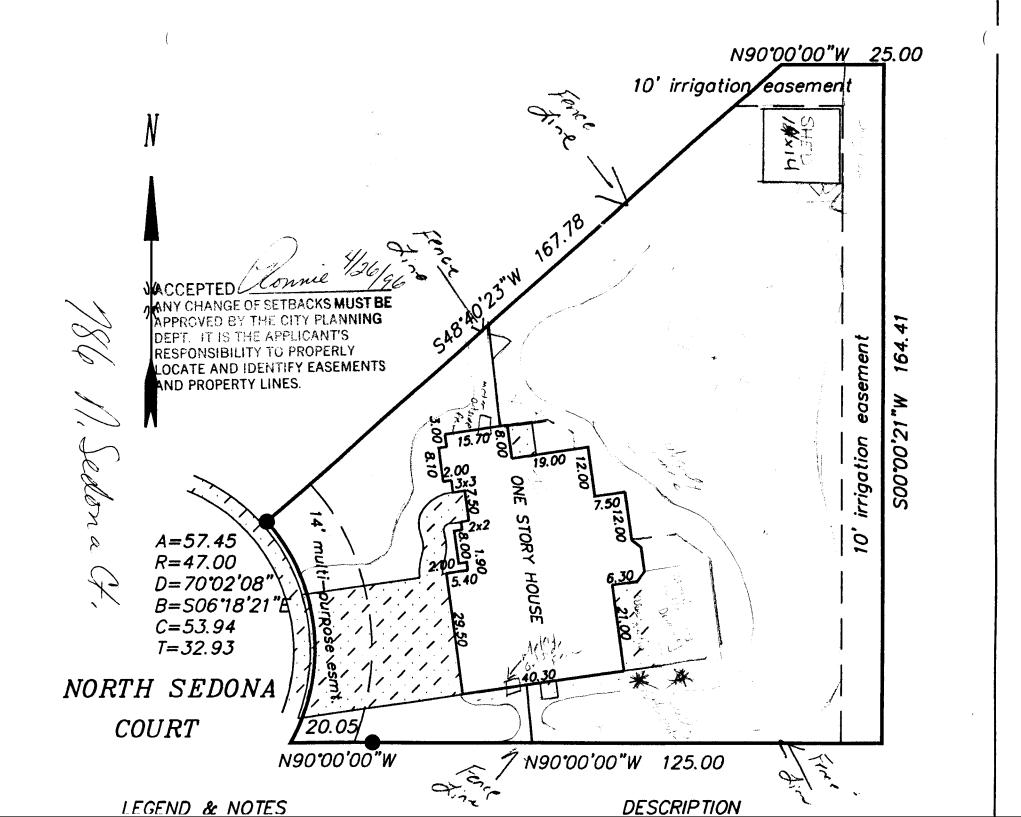

€

Spiroding