

FEE \$	10 ⁰⁰
TCP \$	0

BLDG PERMIT NO. 57983

PLANNING CLEARANCE
 (Single Family Residential and Accessory Structures)
 Grand Junction Community Development Department

schump

THIS SECTION TO BE COMPLETED BY APPLICANT

BLDG ADDRESS 2552 Westwood Dr TAX SCHEDULE NO. 2945-031-00-155
 SUBDIVISION Valley Meadows East SQ. FT. OF PROPOSED BLDG(S)/ADDITION 1400
 FILING 1 BLK 3 LOT 1 SQ. FT. OF EXISTING BLDG(S) -
 (1) OWNER John Davis NO. OF DWELLING UNITS
 BEFORE: _____ AFTER: 1 THIS CONSTRUCTION
 (1) ADDRESS _____ NO. OF BLDGS ON PARCEL
 BEFORE: _____ AFTER: 1 THIS CONSTRUCTION
 (2) APPLICANT Carter Homes, Inc USE OF EXISTING BLDGS -
 (2) ADDRESS 2755 N. Ave. DESCRIPTION OF WORK AND INTENDED USE: _____
 (2) TELEPHONE 2484638 single family

REQUIRED: Two (2) plot plans, on 8 1/2" x 11" paper, showing all existing and proposed structure location(s), parking, setbacks to all property lines, ingress/egress to the property, and all easements and rights-of-way which abut the parcel.

THIS SECTION TO BE COMPLETED BY COMMUNITY DEVELOPMENT DEPARTMENT STAFF

ZONE PR 2.93 Maximum coverage of lot by structures _____
 SETBACKS: Front 20' from property line (PL) Parking Req'mt _____
 or _____ from center of ROW, whichever is greater Special Conditions _____
 Side 10' from PL Rear 20' from PL
 Maximum Height 32' CENSUS TRACT 10 TRAFFIC ZONE 19

Modifications to this Planning Clearance must be approved, in writing, by the Director of the Community Development Department. The structure authorized by this application cannot be occupied until a final inspection has been completed and a Certificate of Occupancy has been issued by the Building Department (Section 305, Uniform Building Code).

I hereby acknowledge that I have read this application and the information is correct; I agree to comply with any and all codes, ordinances, laws, regulations or restrictions which apply to the project. I understand that failure to comply shall result in legal action, which may include but not necessarily be limited to non-use of the building(s).

Applicant Signature [Signature], President Date 10/16/96
 Department Approval [Signature] Date 10/24/96

Additional water and/or sewer tap fee(s) are required: YES NO _____ W/O No. 9611

Utility Accounting [Signature] Date 10/25/96


VALID FOR SIX MONTHS FROM DATE OF ISSUANCE (Section 9-3-2C Grand Junction Zoning & Development Code)

(White: Planning) (Yellow: Customer) (Pink: Building Department) (Goldenrod: Utility Accounting)

APPROVED

VALLEY MEADOWS EAST SUBDIVISION
115'-0" L1 B3 F1

2552 Westwood Dr.
DRIVEWAY OK
J. P. Miller
10-29-96

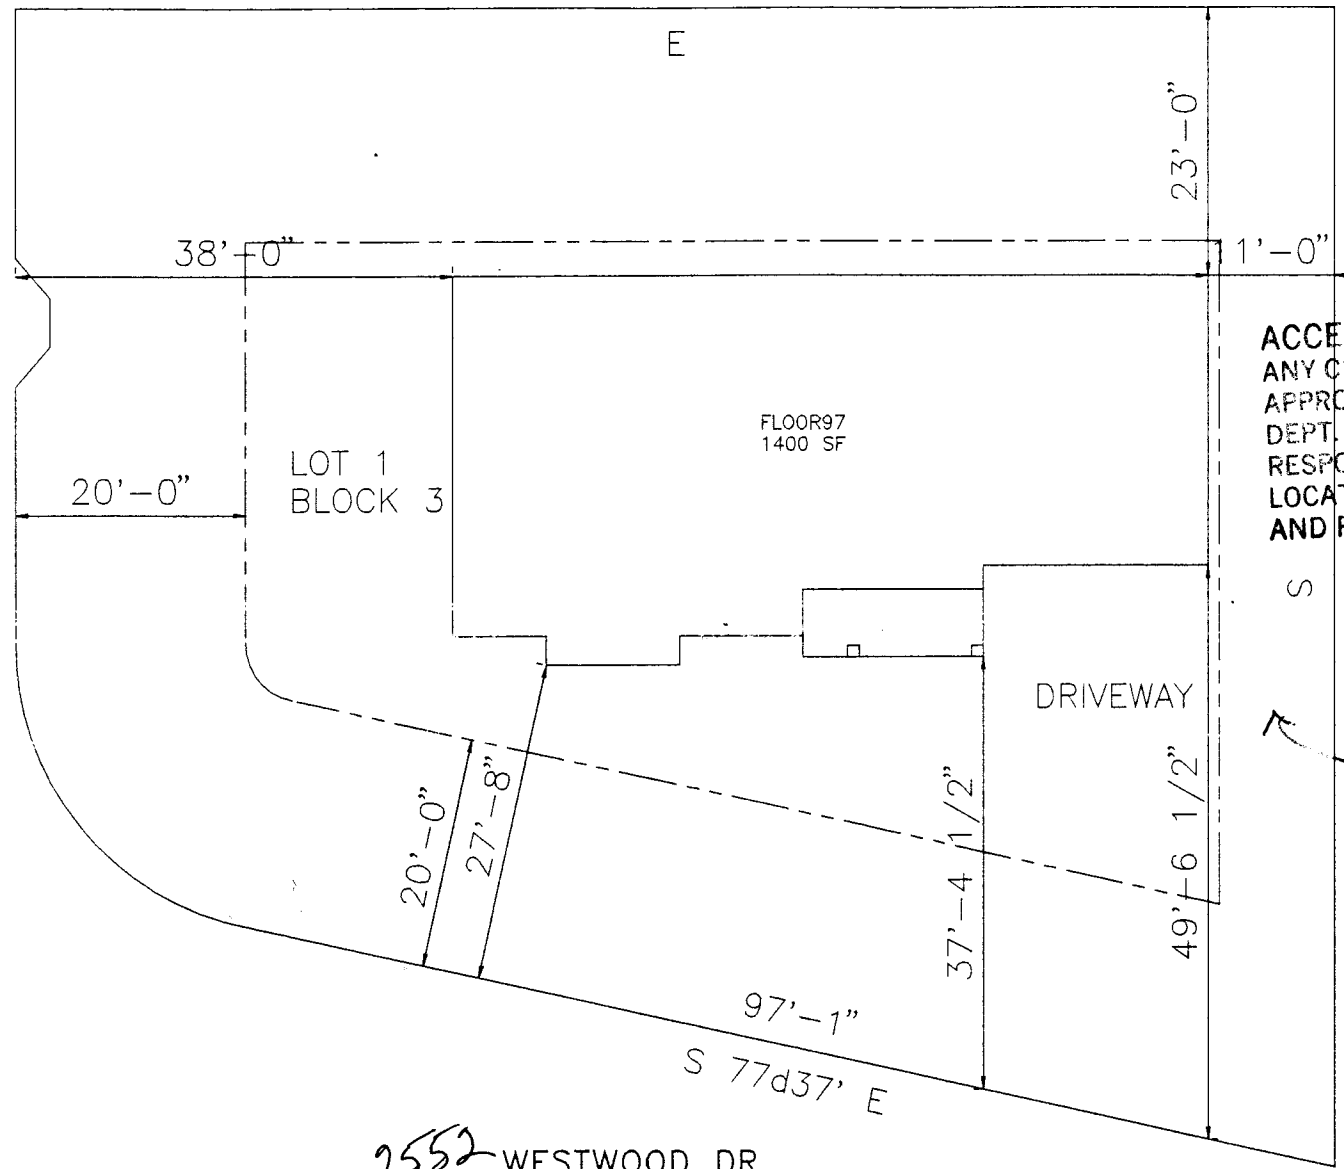

ACCEPTED *Ronnie 10/29/96*
ANY CHANGE OF SETBACKS MUST BE APPROVED BY THE CITY PLANNING DEPT. IT IS THE APPLICANT'S RESPONSIBILITY TO PROPERLY LOCATE AND IDENTIFY EASEMENTS AND PROPERTY LINES.

S 11 1/2"

*10' easement -
no overhang
here*

2552 WESTWOOD DR.