

FEE \$ 10 -  
TCP \$ -0 -

BLDG PERMIT NO. 57987

School 292 -

**PLANNING CLEARANCE**  
(Single Family Residential and Accessory Structures)  
**Grand Junction Community Development Department**

*Schump*

**THIS SECTION TO BE COMPLETED BY APPLICANT**

BLDG ADDRESS 2557 Westwood Dr. TAX SCHEDULE NO. 2945-031-00-155  
SUBDIVISION Valley Meadows East SQ. FT. OF PROPOSED BLDG(S)/ADDITION 21528  
FILING 2 BLK 04 LOT 2 SQ. FT. OF EXISTING BLDG(S) -  
(1) OWNER John Davis NO. OF DWELLING UNITS BEFORE: \_\_\_\_\_ AFTER: 1 THIS CONSTRUCTION  
(1) ADDRESS \_\_\_\_\_ NO. OF BLDGS ON PARCEL BEFORE: \_\_\_\_\_ AFTER: 1 THIS CONSTRUCTION  
(1) TELEPHONE 243 7711 USE OF EXISTING BLDGS -  
(2) APPLICANT Carter Homes, Inc DESCRIPTION OF WORK AND INTENDED USE: \_\_\_\_\_  
(2) ADDRESS 2755 N. Ae. Single family  
(2) TELEPHONE 248 4658

REQUIRED: Two (2) plot plans, on 8 1/2" x 11" paper, showing all existing and proposed structure location(s), parking, setbacks to all property lines, ingress/egress to the property, and all easements and rights-of-way which abut the parcel.

**THIS SECTION TO BE COMPLETED BY COMMUNITY DEVELOPMENT DEPARTMENT STAFF**

ZONE PR-2.93 Maximum coverage of lot by structures \_\_\_\_\_  
SETBACKS: Front 20' from property line (PL) Parking Req'mt 2  
or \_\_\_\_\_ from center of ROW, whichever is greater Special Conditions \_\_\_\_\_  
Side 10' from PL Rear 20' from PL  
Maximum Height 32'  
CENSUS TRACT 10 TRAFFIC ZONE 19

Modifications to this Planning Clearance must be approved, in writing, by the Director of the Community Development Department. The structure authorized by this application cannot be occupied until a final inspection has been completed and a Certificate of Occupancy has been issued by the Building Department (Section 305, Uniform Building Code).

I hereby acknowledge that I have read this application and the information is correct; I agree to comply with any and all codes, ordinances, laws, regulations or restrictions which apply to the project. I understand that failure to comply shall result in legal action, which may include but not necessarily be limited to non-use of the building(s).

Applicant Signature W/W, President Date 10/19/96  
Department Approval Marcia Rabideaux Date 10-24-96

Additional water and/or sewer tap fee(s) are required: YES X NO \_\_\_\_\_ W/O No. 9613

Utility Accounting Paul Roman Date 10/25/96


VALID FOR SIX MONTHS FROM DATE OF ISSUANCE (Section 9-3-2C Grand Junction Zoning & Development Code)

(White: Planning) (Yellow: Customer) (Pink: Building Department) (Goldenrod: Utility Accounting)

VALLEY MEADOWS EAST SUBDIVISION  
FILING 2

**APPROVED**

2557 WESTWOOD DR.

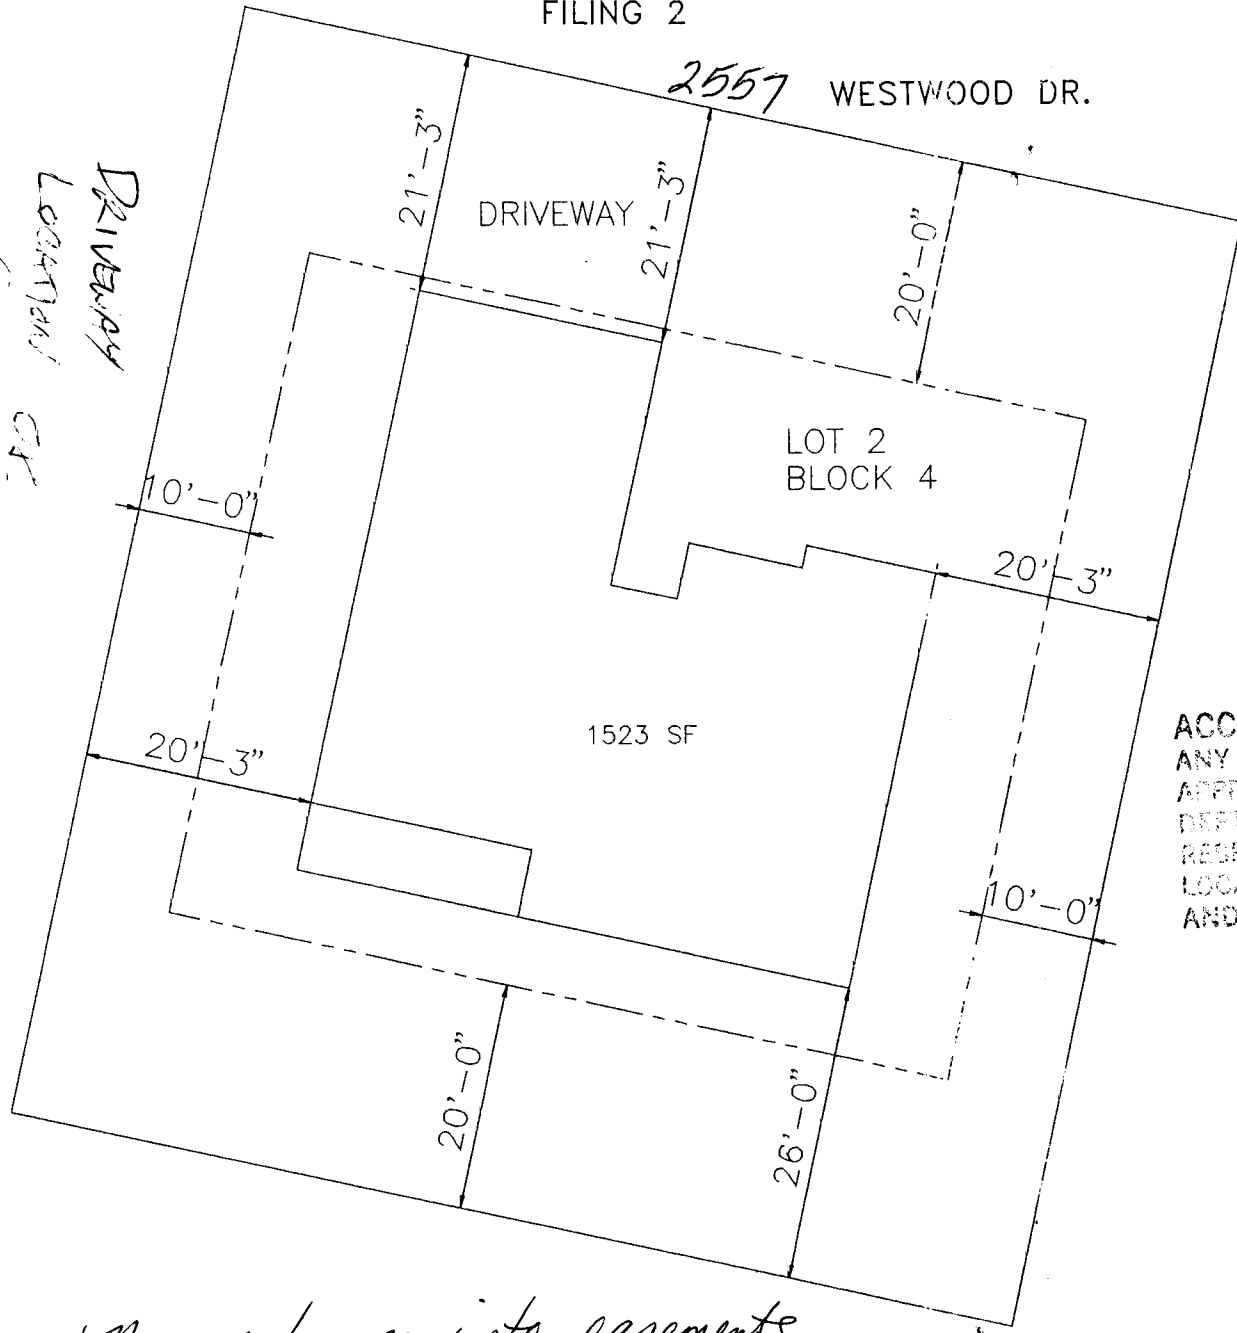

ACCEPTED *Bonnie* 10/24/96  
ANY CHANGE OF SETBACKS MUST BE  
APPROVED BY THE CITY PLANNING  
DEPT. IT IS THE APPLICANT'S  
RESPONSIBILITY TO PROPERLY  
LOCATE AND IDENTIFY EASEMENTS  
AND PROPERTY LINES.

*No overhangs into easements*