

FEE \$	<del>7000</del> 500
TCP \$	—
DRAINAGE FEE \$	—

BLDG PERMIT NO.	63939
FILE #	

## PLANNING CLEARANCE

(site plan review, multi-family development, non-residential development)  
Grand Junction Community Development Department

\* THIS SECTION TO BE COMPLETED BY APPLICANT \*

BLDG ADDRESS <u>580 25 Rd</u>	TAX SCHEDULE NO. <u>2995-102-00-158</u>
SUBDIVISION <u>—</u>	SQ. FT. OF PROPOSED BLDG(S)/ADDITION <u>208</u> <span style="float: right;">8x26</span>
FILING <u>BLK</u> <u>—</u> LOT <u>—</u>	SQ. FT. OF EXISTING BLDG(S) <u>4000 + 100</u>
(1) OWNER <u>D.S. Dykstra</u>	NO. OF DWELLING UNITS BEFORE: <u>2</u> AFTER: <u>2</u> CONSTRUCTION
(1) ADDRESS <u>2707 Crossroads Blvd</u>	NO. OF BLDGS ON PARCEL BEFORE: <u>2</u> AFTER: <u>3</u> CONSTRUCTION
(1) TELEPHONE <u>243-3066</u>	USE OF ALL EXISTING BLDGS <u>Manufacturing</u>
(2) APPLICANT <u>Canvas Products Co</u>	DESCRIPTION OF WORK & INTENDED USE: <u>Storage - No electrical or Plumbing</u>
(2) ADDRESS <u>580 25 Rd</u>	<u>(portable) or Foundation</u>
(2) TELEPHONE <u>242-1453</u>	

✓ Submittal requirements are outlined in the SSID (Submittal Standards for Improvements and Development) document.

\* THIS SECTION TO BE COMPLETED BY COMMUNITY DEVELOPMENT DEPARTMENT STAFF \*

ZONE <u>C-2</u>	Landscaping / Screening Required: YES <input type="checkbox"/> NO <input type="checkbox"/>
SETBACKS: Front <u>0'</u> from Property Line (PL) or <u>—</u> from center of ROW, whichever is greater	Parking Req'mt <u>—</u>
Side <u>0'</u> from PL Rear <u>0'</u> from PL	Special Conditions: <u>—</u>
Maximum Height <u>—</u>	
Maximum coverage of lot by structures <u>—</u>	CENS.T. <u>4</u> T.ZONE <u>10</u> ANN# <u>—</u>

Modifications to this Planning Clearance must be approved, in writing, by the Community Development Department Director. The structure authorized by this application cannot be occupied until a final inspection has been completed and a Certificate of Occupancy has been issued by the Building Department (Section 307, Uniform Building Code). Required improvements in the public right-of-way must be guaranteed prior to issuance of a Planning Clearance. All other required site improvements must be completed or guaranteed prior to issuance of a Certificate of Occupancy. Any landscaping required by this permit shall be maintained in an acceptable and healthy condition. The replacement of any vegetation materials that die or are in an unhealthy condition is required by the G.J. Zoning and Development Code.

Four (4) sets of final construction drawings must be submitted and stamped by City Engineering prior to issuing the Planning Clearance. One stamped set must be available on the job site at all times.

I hereby acknowledge that I have read this application and the information is correct; I agree to comply with any and all codes, ordinances, laws, regulations, or restrictions which apply to the project. I understand that failure to comply shall result in legal action, which may include but not necessarily be limited to non-use of the building(s).

Applicant's Signature <u>[Signature]</u>	Date <u>12-9-97</u>
Department Approval <u>[Signature]</u>	Date <u>12-9-97</u>
Additional water and/or sewer tap fee(s) are required: YES <input type="checkbox"/> NO <input checked="" type="checkbox"/> W/O No. <u>712-83299</u>	
Utility Accounting <u>[Signature]</u>	Date <u>12-10-97</u>


VALID FOR SIX MONTHS FROM DATE OF ISSUANCE (Section 9-3-2C Grand Junction Zoning & Development Code)

(White: Planning)      (Yellow: Customer)      (Pink: Building Department)      (Goldenrod: Utility Accounting)

# Site Plan

Canvas Products  
580 25 Rd  
242-1453  
Tom Dykstra

## Portable Storage Shed

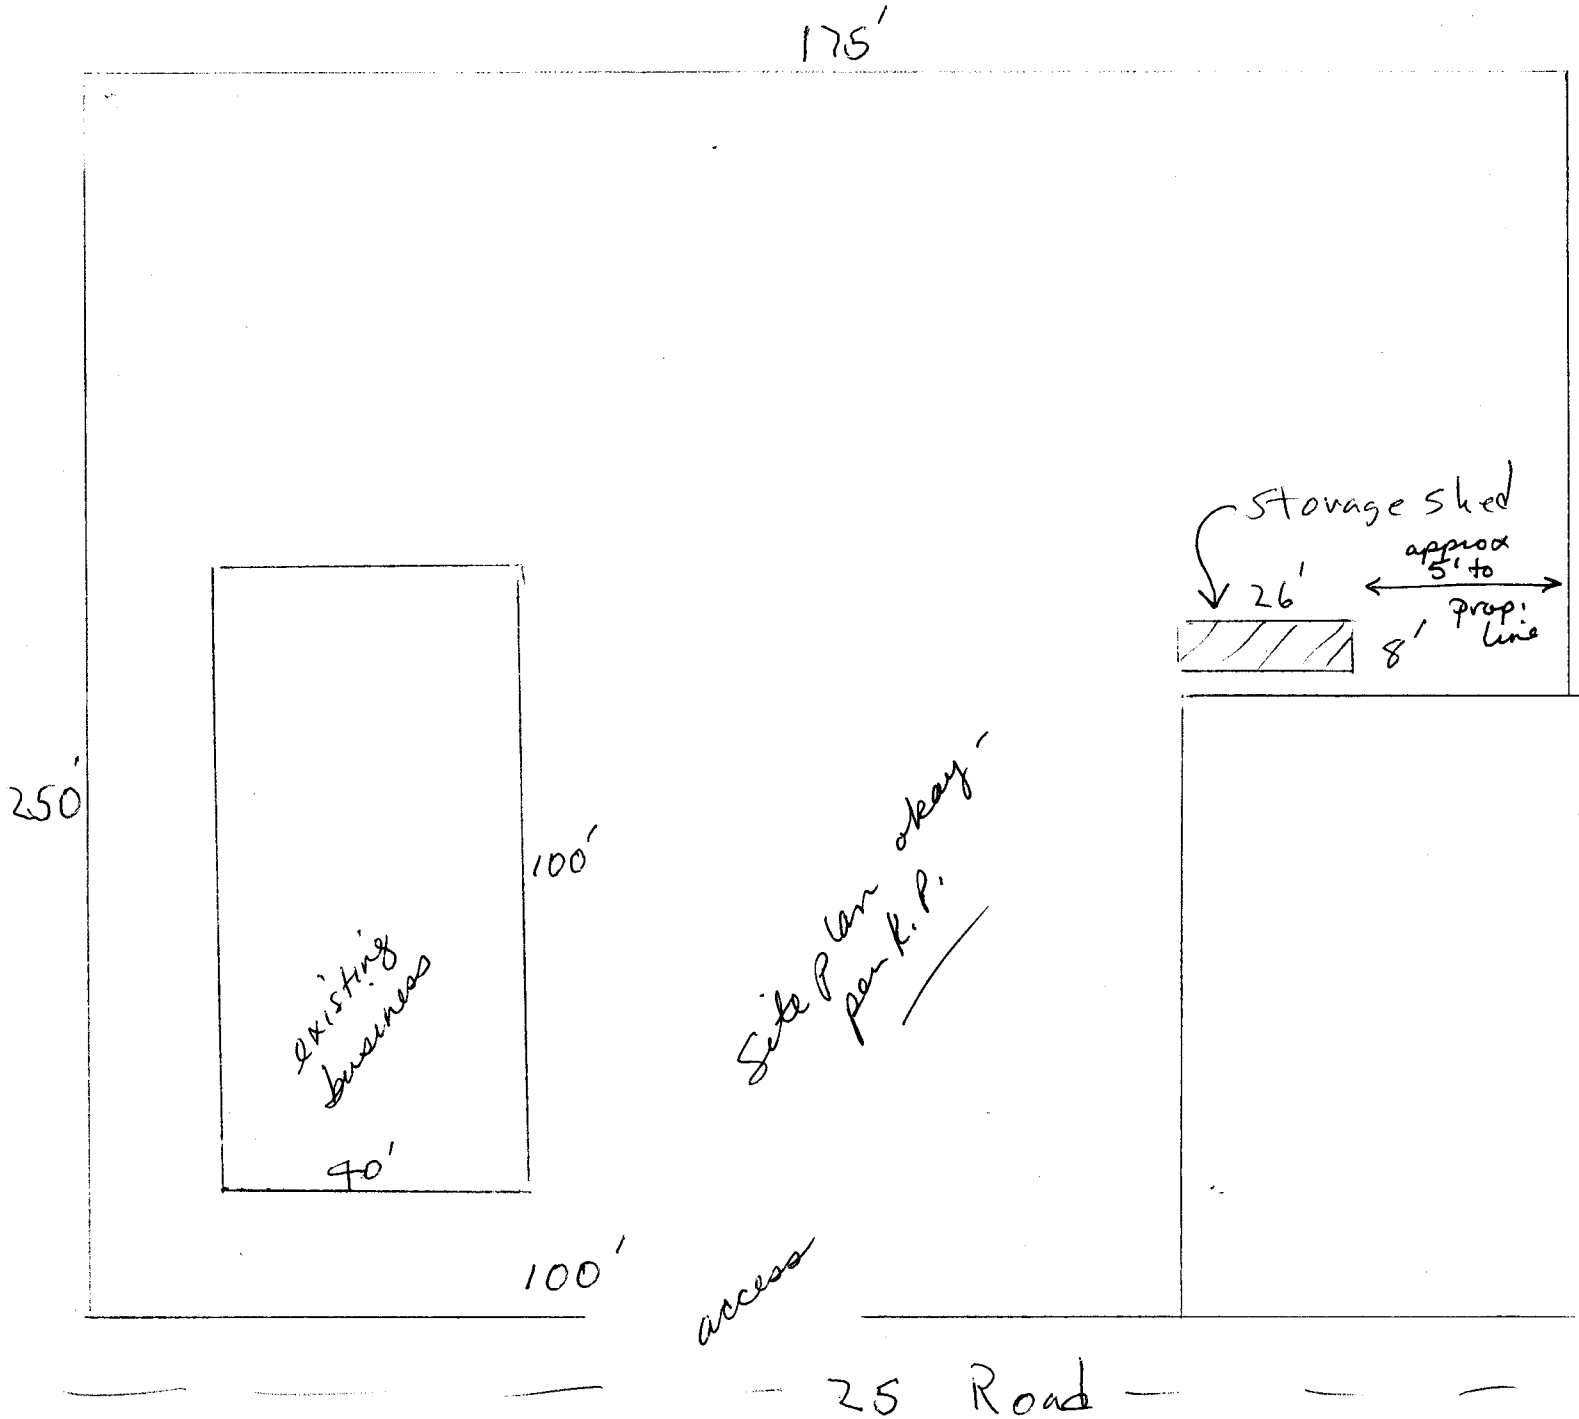

Not to Scale

NTS.

C-2 zone