

Planning \$ <u>10-</u>	Drainage \$ <u>-0-</u>
TCP \$ <u>-0-</u>	School Impact \$ <u>-0-</u>

BLDG PERMIT NO. <u>60594</u>
FILE #

PLANNING CLEARANCE

(site plan review, multi-family development, non-residential development)

Grand Junction Community Development Department

3017-0620-01-9

THIS SECTION TO BE COMPLETED BY APPLICANT

BLDG ADDRESS 2635 N. 7TH ST. TAX SCHEDULE NO. 2945-112-00-971

SUBDIVISION _____ SQ. FT. OF PROPOSED BLDG(S)/ADDITION _____

FILING _____ BLK _____ LOT _____ SQ. FT. OF EXISTING BLDG(S) _____

(1) OWNER S. MARY'S HOSPITAL NO. OF DWELLING UNITS
BEFORE: _____ AFTER: _____ CONSTRUCTION

(1) ADDRESS 2635 N. 7TH ST. NO. OF BLDGS ON PARCEL
BEFORE: _____ AFTER: _____ CONSTRUCTION

(1) TELEPHONE 244-2169

(2) APPLICANT JOHN NEWELL USE OF ALL EXISTING BLDGS HOSPITAL

(2) ADDRESS 553 25 1/2 ROAD DESCRIPTION OF WORK & INTENDED USE: COUNCIL

(2) TELEPHONE 242-3548 TOWER PAD / INSTALL NEW TOWER

✓ Submittal requirements are outlined in the SSID (Submittal Standards for Improvements and Development) document.

THIS SECTION TO BE COMPLETED BY COMMUNITY DEVELOPMENT DEPARTMENT STAFF

ZONE PB Landscaping / Screening Required: YES _____ NO _____

SETBACKS: Front _____ from Property Line (PL) or _____ from center of ROW, whichever is greater Parking Req't _____

Side _____ from PL Rear _____ from PL Special Conditions: as approved

Maximum Height _____

Maximum coverage of lot by structures _____ Census Tract 5 Traffic Zone 26 Annx # _____

Modifications to this Planning Clearance must be approved, in writing, by the Community Development Department Director. The structure authorized by this application cannot be occupied until a final inspection has been completed and a Certificate of Occupancy has been issued by the Building Department (Section 307, Uniform Building Code). Required improvements in the public right-of-way must be guaranteed prior to issuance of a Planning Clearance. All other required site improvements must be completed or guaranteed prior to issuance of a Certificate of Occupancy. Any landscaping required by this permit shall be maintained in an acceptable and healthy condition. The replacement of any vegetation materials that die or are in an unhealthy condition is required by the G.J. Zoning and Development Code.

Four (4) sets of final construction drawings must be submitted and stamped by City Engineering prior to issuing the Planning Clearance. One stamped set must be available on the job site at all times.

I hereby acknowledge that I have read this application and the information is correct; I agree to comply with any and all codes, ordinances, laws, regulations, or restrictions which apply to the project. I understand that failure to comply shall result in legal action, which may include but not necessarily be limited to non-use of the building(s).

Applicant's Signature _____ Date 5-29-97


Department Approval _____ Date 5-29-97

Additional water and/or sewer tap fee(s) are required: YES _____ NO W/O No. _____

Utility Accounting _____ Date 4/2/97

VALID FOR SIX MONTHS FROM DATE OF ISSUANCE (Section 9-3-2C Grand Junction Zoning & Development Code)

(White: Planning) (Yellow: Customer) (Pink: Building Department) (Goldenrod: Utility Accounting)

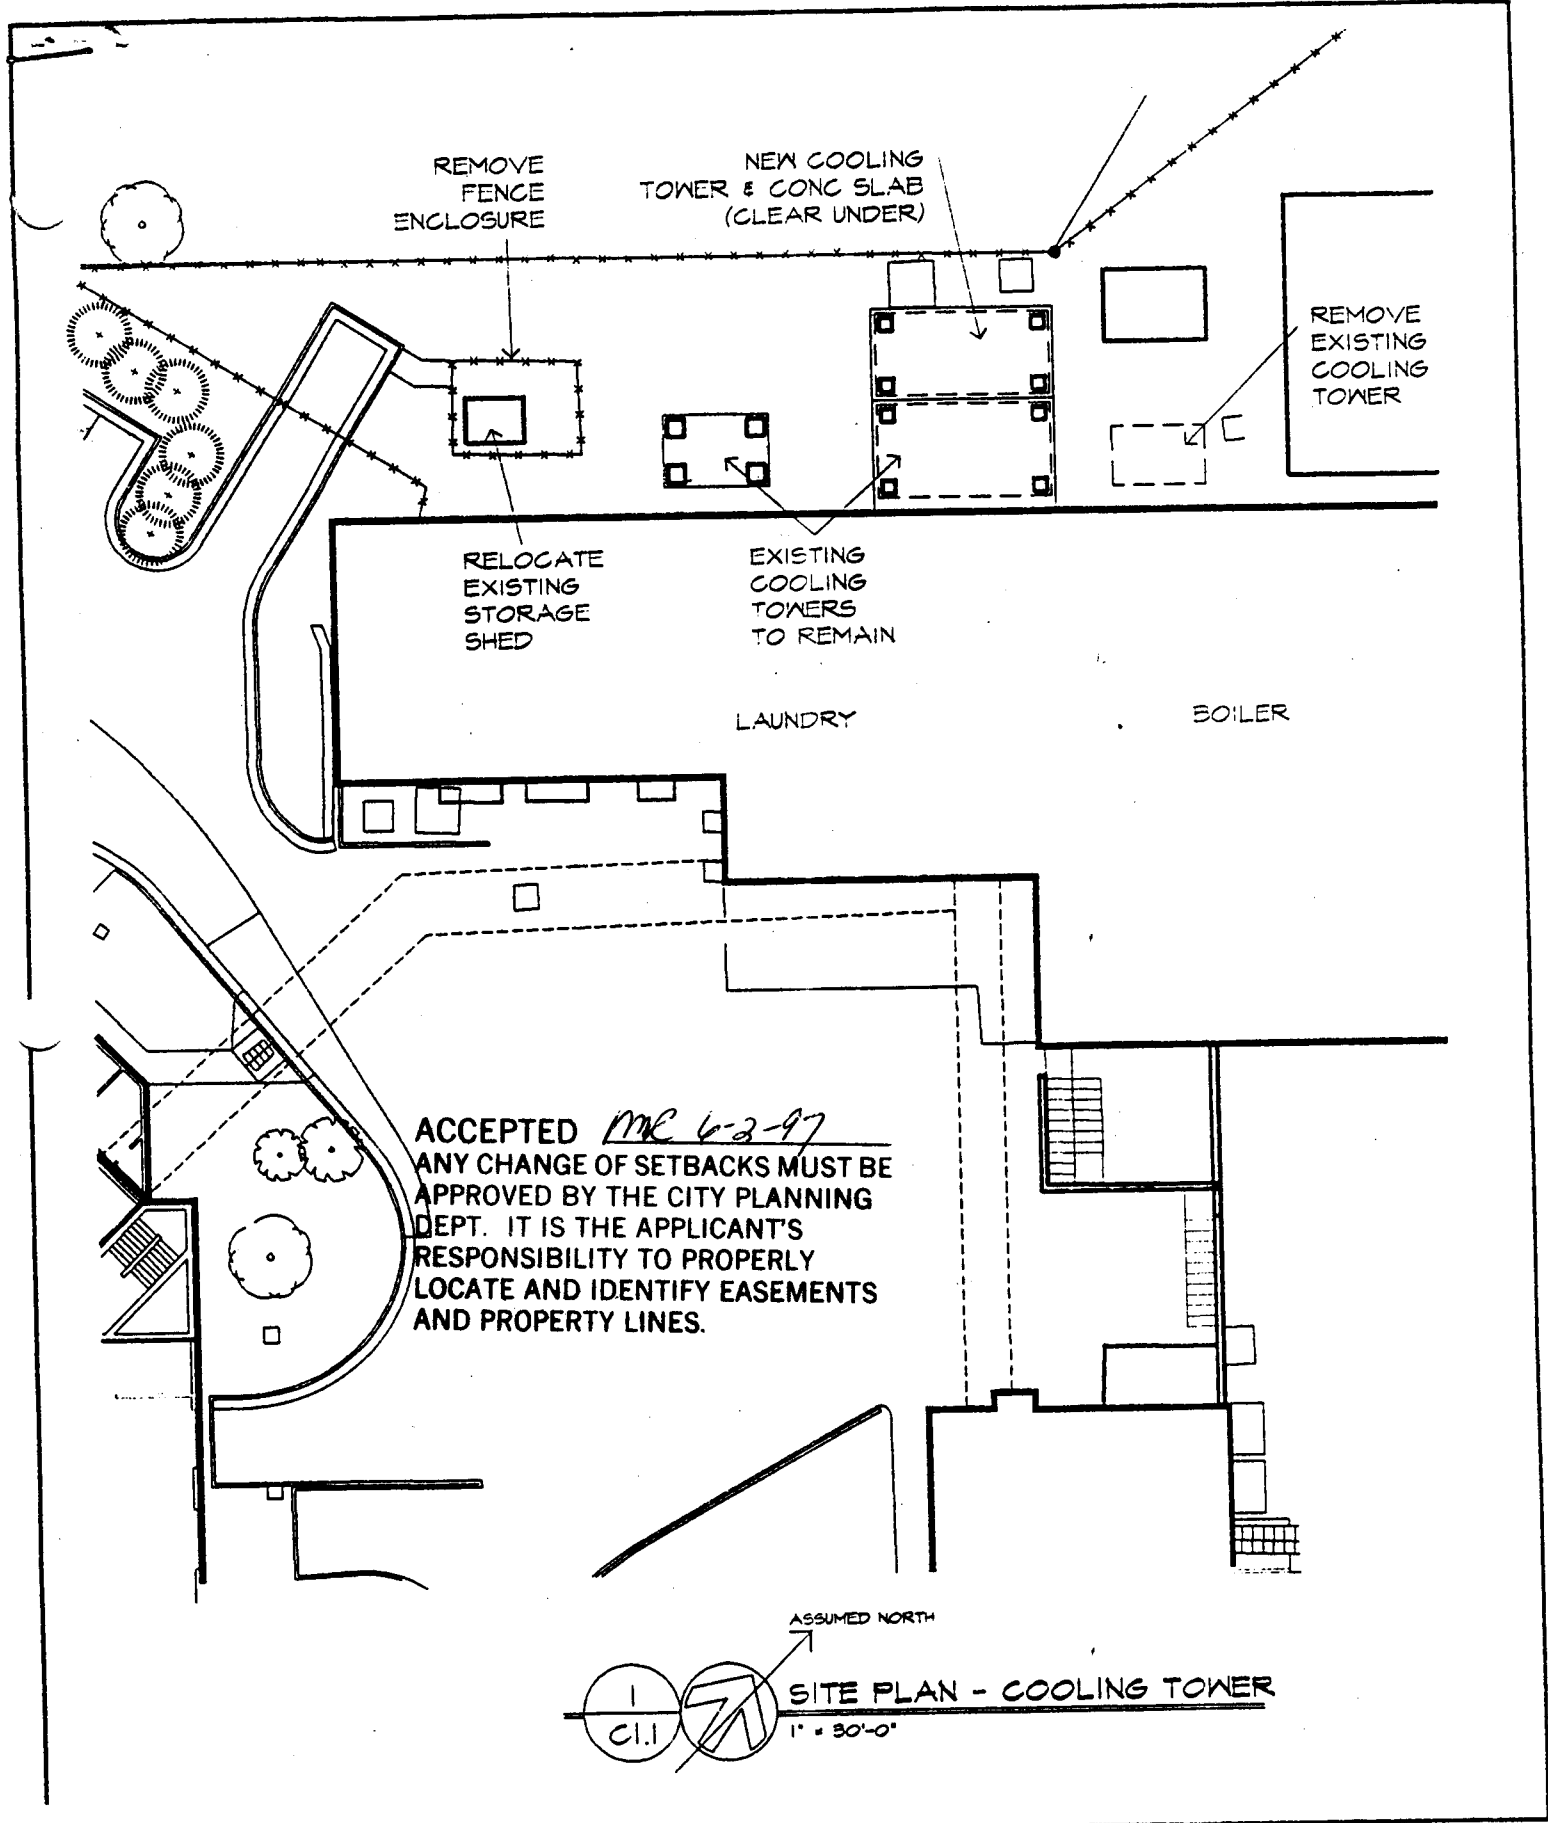

ACCEPTED *MC 6-2-97*
 ANY CHANGE OF SETBACKS MUST BE APPROVED BY THE CITY PLANNING DEPT. IT IS THE APPLICANT'S RESPONSIBILITY TO PROPERLY LOCATE AND IDENTIFY EASEMENTS AND PROPERTY LINES.

ASSUMED NORTH
 SITE PLAN - COOLING TOWER
 1" = 30'-0"

Cl.1

ROBERT D. JENKINS/AIA
 ARCHITECT
 1000 North 9th Suite 35 (970) 256-1980
 Grand Junction, Co 81501 03/24/97

ll
 COOLING TOWER
 St Mary's Hospital & Medical Center