


FEE \$	<u>10<sup>00</sup></u>
TCP \$	

BLDG PERMIT NO.	<u>59257</u>
-----------------	--------------

**PLANNING CLEARANCE**  
 (Single Family Residential and Accessory Structures)  
 Grand Junction Community Development Department

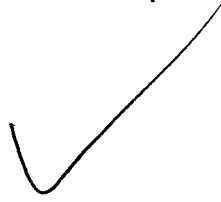

**THIS SECTION TO BE COMPLETED BY APPLICANT**

BLDG ADDRESS <u>480 28 1/4 RD #55</u>	TAX SCHEDULE NO. <u>2943-182-09-002</u>
SUBDIVISION <u>DARWIN</u>	SQ. FT. OF PROPOSED BLDG(S)/ADDITION <u>14 x 66</u>
FILING _____ BLK _____ LOT <u>2</u>	SQ. FT. OF EXISTING BLDG(S) <u>NA</u>
(1) OWNER <u>JOHN DAVIS</u>	NO. OF DWELLING UNITS BEFORE: <u>0</u> AFTER: _____ THIS CONSTRUCTION
(1) ADDRESS <u>1023 24 Rd</u>	NO. OF BLDGS ON PARCEL BEFORE: <u>0</u> AFTER: _____ THIS CONSTRUCTION
(1) TELEPHONE <u>250-0720</u>	USE OF EXISTING BLDGS _____
(2) APPLICANT <u>ROBERT HURNI</u>	DESCRIPTION OF WORK AND INTENDED USE: _____
(2) ADDRESS <u>1460 N AVE #H</u>	
(2) TELEPHONE <u>243-2308</u>	<u>Set mobile Home SP 55</u>

**REQUIRED:** Two (2) plot plans, on 8 1/2" x 11" paper, showing all existing and proposed structure location(s), parking, setbacks to all property lines, ingress/egress to the property, and all easements and rights-of-way which abut the parcel.

**THIS SECTION TO BE COMPLETED BY COMMUNITY DEVELOPMENT DEPARTMENT STAFF**

ZONE <u>PMH</u>	Maximum coverage of lot by structures _____
SETBACKS: Front _____ from property line (PL) or _____ from center of ROW, whichever is greater	Parking Req'mt _____
Side _____ from PL Rear _____ from PL	Special Conditions <u>per park regs</u>
Maximum Height _____	CENSUS TRACT <u>7</u> TRAFFIC ZONE <u>39</u>

Modifications to this Planning Clearance must be approved, in writing, by the Director of the Community Development Department. The structure authorized by this application cannot be occupied until a final inspection has been completed and a Certificate of Occupancy has been issued by the Building Department (Section 305, Uniform Building Code).

I hereby acknowledge that I have read this application and the information is correct; I agree to comply with any and all codes, ordinances, laws, regulations or restrictions which apply to the project. I understand that failure to comply shall result in legal action, which may include but not necessarily be limited to non-use of the building(s).


Applicant Signature <u>Robert Hurni</u>	Date <u>2-13-97</u>
Department Approval <u>Ronnie Edwards</u>	Date <u>2-25-97</u>

Additional water and/or sewer tap fee(s) are required: YES  NO \_\_\_\_\_ W/O No. 9917

Utility Accounting <u>[Signature]</u>	Date <u>2/25/97</u>
---------------------------------------	---------------------

VALID FOR SIX MONTHS FROM DATE OF ISSUANCE (Section 9-3-2C Grand Junction Zoning & Development Code)

(White: Planning) (Yellow: Customer) (Pink: Building Department) (Goldenrod: Utility Accounting)

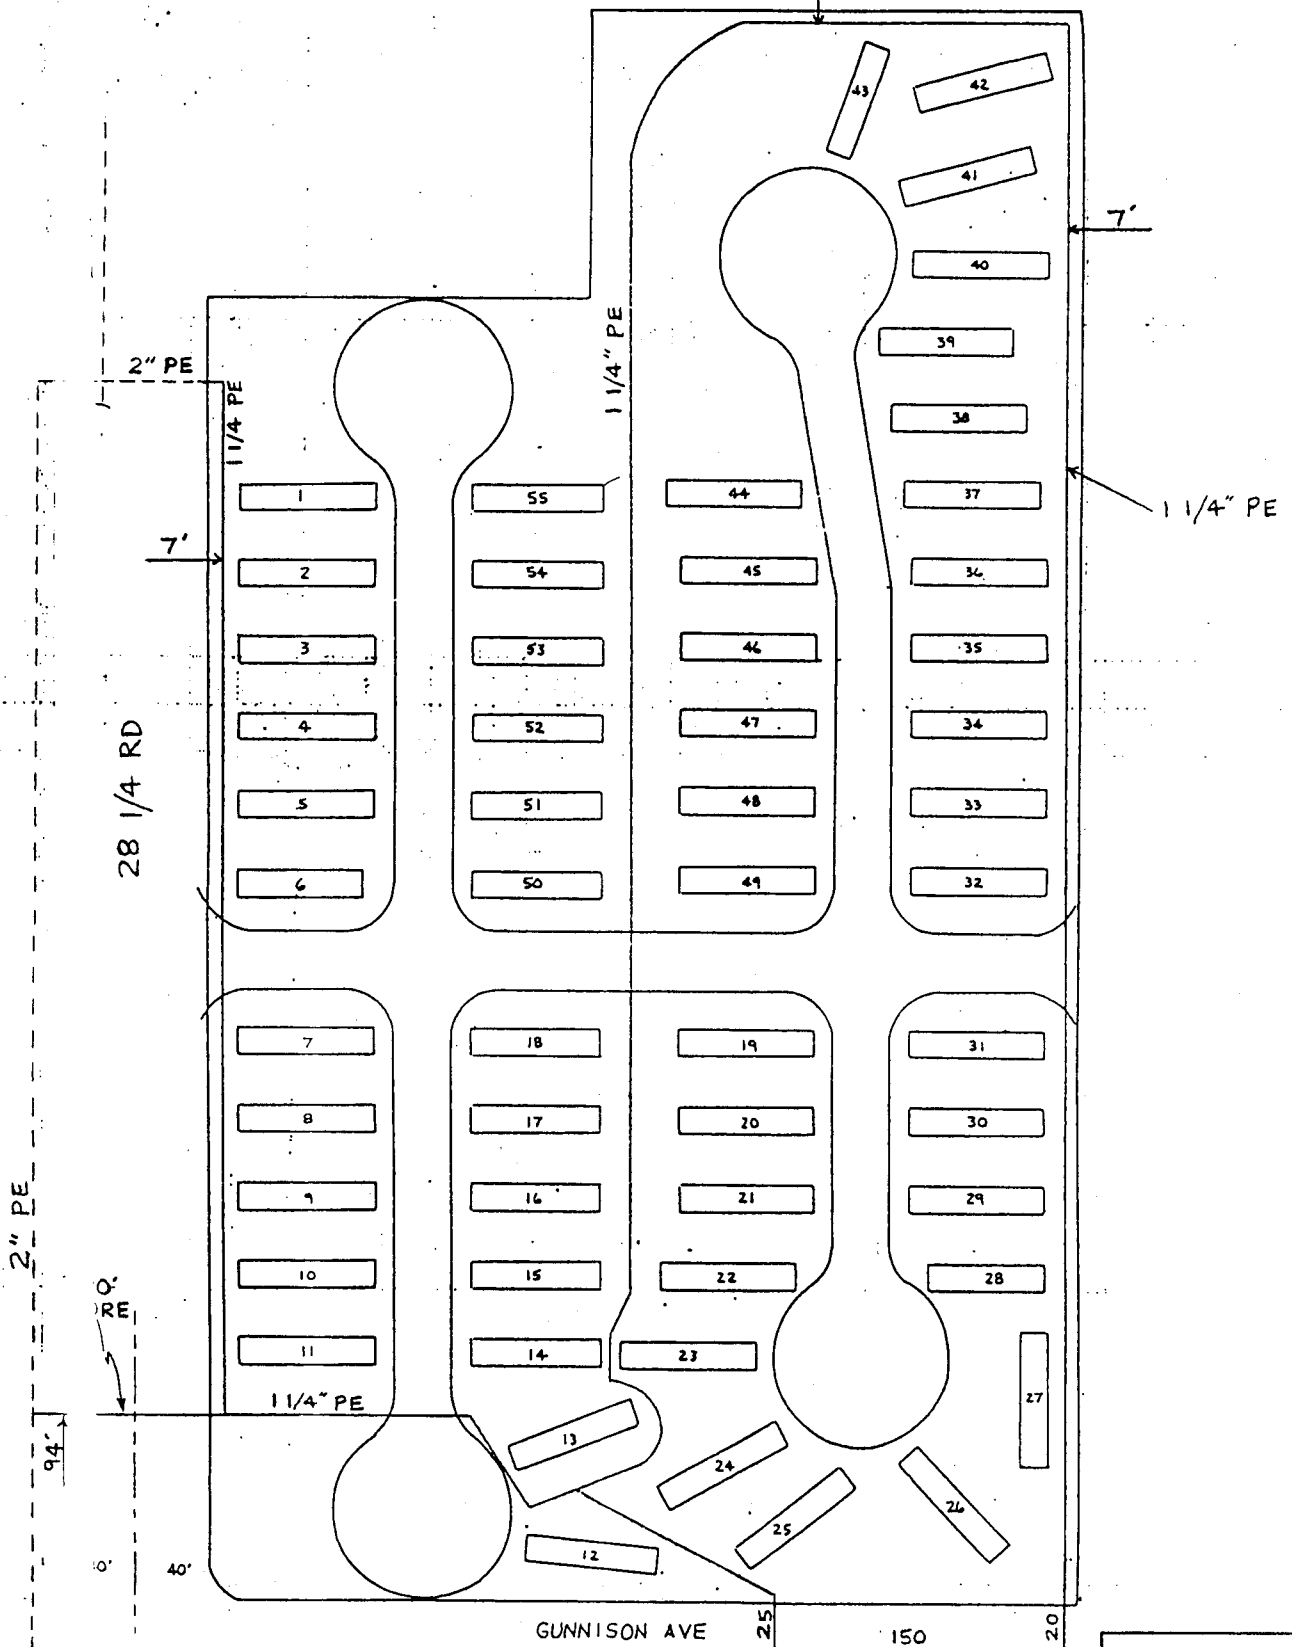

SHOW CONDITIONS OF	_____	END	<input type="checkbox"/> GOOD	<input type="checkbox"/> FAIR	<input type="checkbox"/> POOR
OLD MAIN AT	_____	END	<input type="checkbox"/> GOOD	<input type="checkbox"/> FAIR	<input type="checkbox"/> POOR
TEST PRESSURE	TEST MADE WITH	DURATION OF TEST	FOREMAN	DATE	

Present Gas   
 Proposed Gas   
 Abandon Gas \_\_\_\_\_  
 Water Phone \_\_\_\_\_  
 Sewer Phone \_\_\_\_\_  
 Other Phone \_\_\_\_\_

2943-082-09-002