

FEE \$ 10.-
 TCP \$ 0
 SIF \$ 292.- pd



BLDG PERMIT NO. 102513

10-
 292-
 1,000-
 750-
 \$ 2,052- total fees

Tap fees - \$1,000 sewer ext. \$750 PIF
PLANNING CLEARANCE
 (Single Family Residential and Accessory Structures)
 Community Development Department

BLDG ADDRESS 404 Attamira Ct TAX SCHEDULE NO. 2945-183-02-002
 SUBDIVISION Trails West Village SQ. FT. OF PROPOSED BLDG(S)/ADDITION 1600 #
 FILING 2 BLK 1 LOT 9 SQ. FT. OF EXISTING BLDG(S) _____
 (1) OWNER Bob + Stephanie Auer NO. OF DWELLING UNITS
 BEFORE: 0 AFTER: 1 THIS CONSTRUCTION
 (1) ADDRESS PO BOX 3648, GJ
 (1) TELEPHONE 241-8180 NO. OF BLDGS ON PARCEL
 BEFORE: 0 AFTER: 1 THIS CONSTRUCTION
 (2) APPLICANT Bradley Danell Harrell ^{Bemis &} USE OF EXISTING BLDGS _____
 (2) ADDRESS Dame DESCRIPTION OF WORK AND INTENDED USE: SFR
 (2) TELEPHONE 243-3738
248-0177

REQUIRED: One plot plan, on 8 1/2" x 11" paper, showing all existing & proposed structure location(s), parking, setbacks to all property lines, ingress/egress to the property, driveway location & width & all easements & rights-of-way which abut the parcel.

THIS SECTION TO BE COMPLETED BY COMMUNITY DEVELOPMENT DEPARTMENT STAFF

ZONE RSF-4 Maximum coverage of lot by structures 35%
 SETBACKS: Front 20' from property line (PL) Parking Req't 2
 or 45' from center of ROW, whichever is greater
 Side 7' from PL Rear 30' from PL Special Conditions _____
 Maximum Height 32'
 CENSUS 1401 TRAFFIC 123 ANN# _____

Modifications to this Planning Clearance must be approved, in writing, by the Director of the Community Development Department. The structure authorized by this application cannot be occupied until a final inspection has been completed and a Certificate of Occupancy has been issued by the Building Department (Section 305, Uniform Building Code).

I hereby acknowledge that I have read this application and the information is correct; I agree to comply with any and all codes, ordinances, laws, regulations or restrictions which apply to the project. I understand that failure to comply shall result in legal action, which may include but not necessarily be limited to non-use of the building(s).

Applicant Signature [Signature] Date 10-20-97

Department Approval [Signature] Date 10-24-97


Additional water and/or sewer tap fee(s) are required: YES NO W/O No. 10656

Utility Accounting [Signature] Date 10-24-97

VALID FOR SIX MONTHS FROM DATE OF ISSUANCE (Section 9-3-2C Grand Junction Zoning & Development Code)

(White: Planning) (Yellow: Customer) (Pink: Building Department) (Goldenrod: Utility Accounting)

ACCEPTED SLO 10-24-97
 ANY CHANGE OF SETBACKS MUST BE APPROVED BY THE CITY PLANNING DEPT. IT IS THE APPLICANT'S RESPONSIBILITY TO PROPERLY LOCATE AND IDENTIFY EASEMENTS AND PROPERTY LINES.

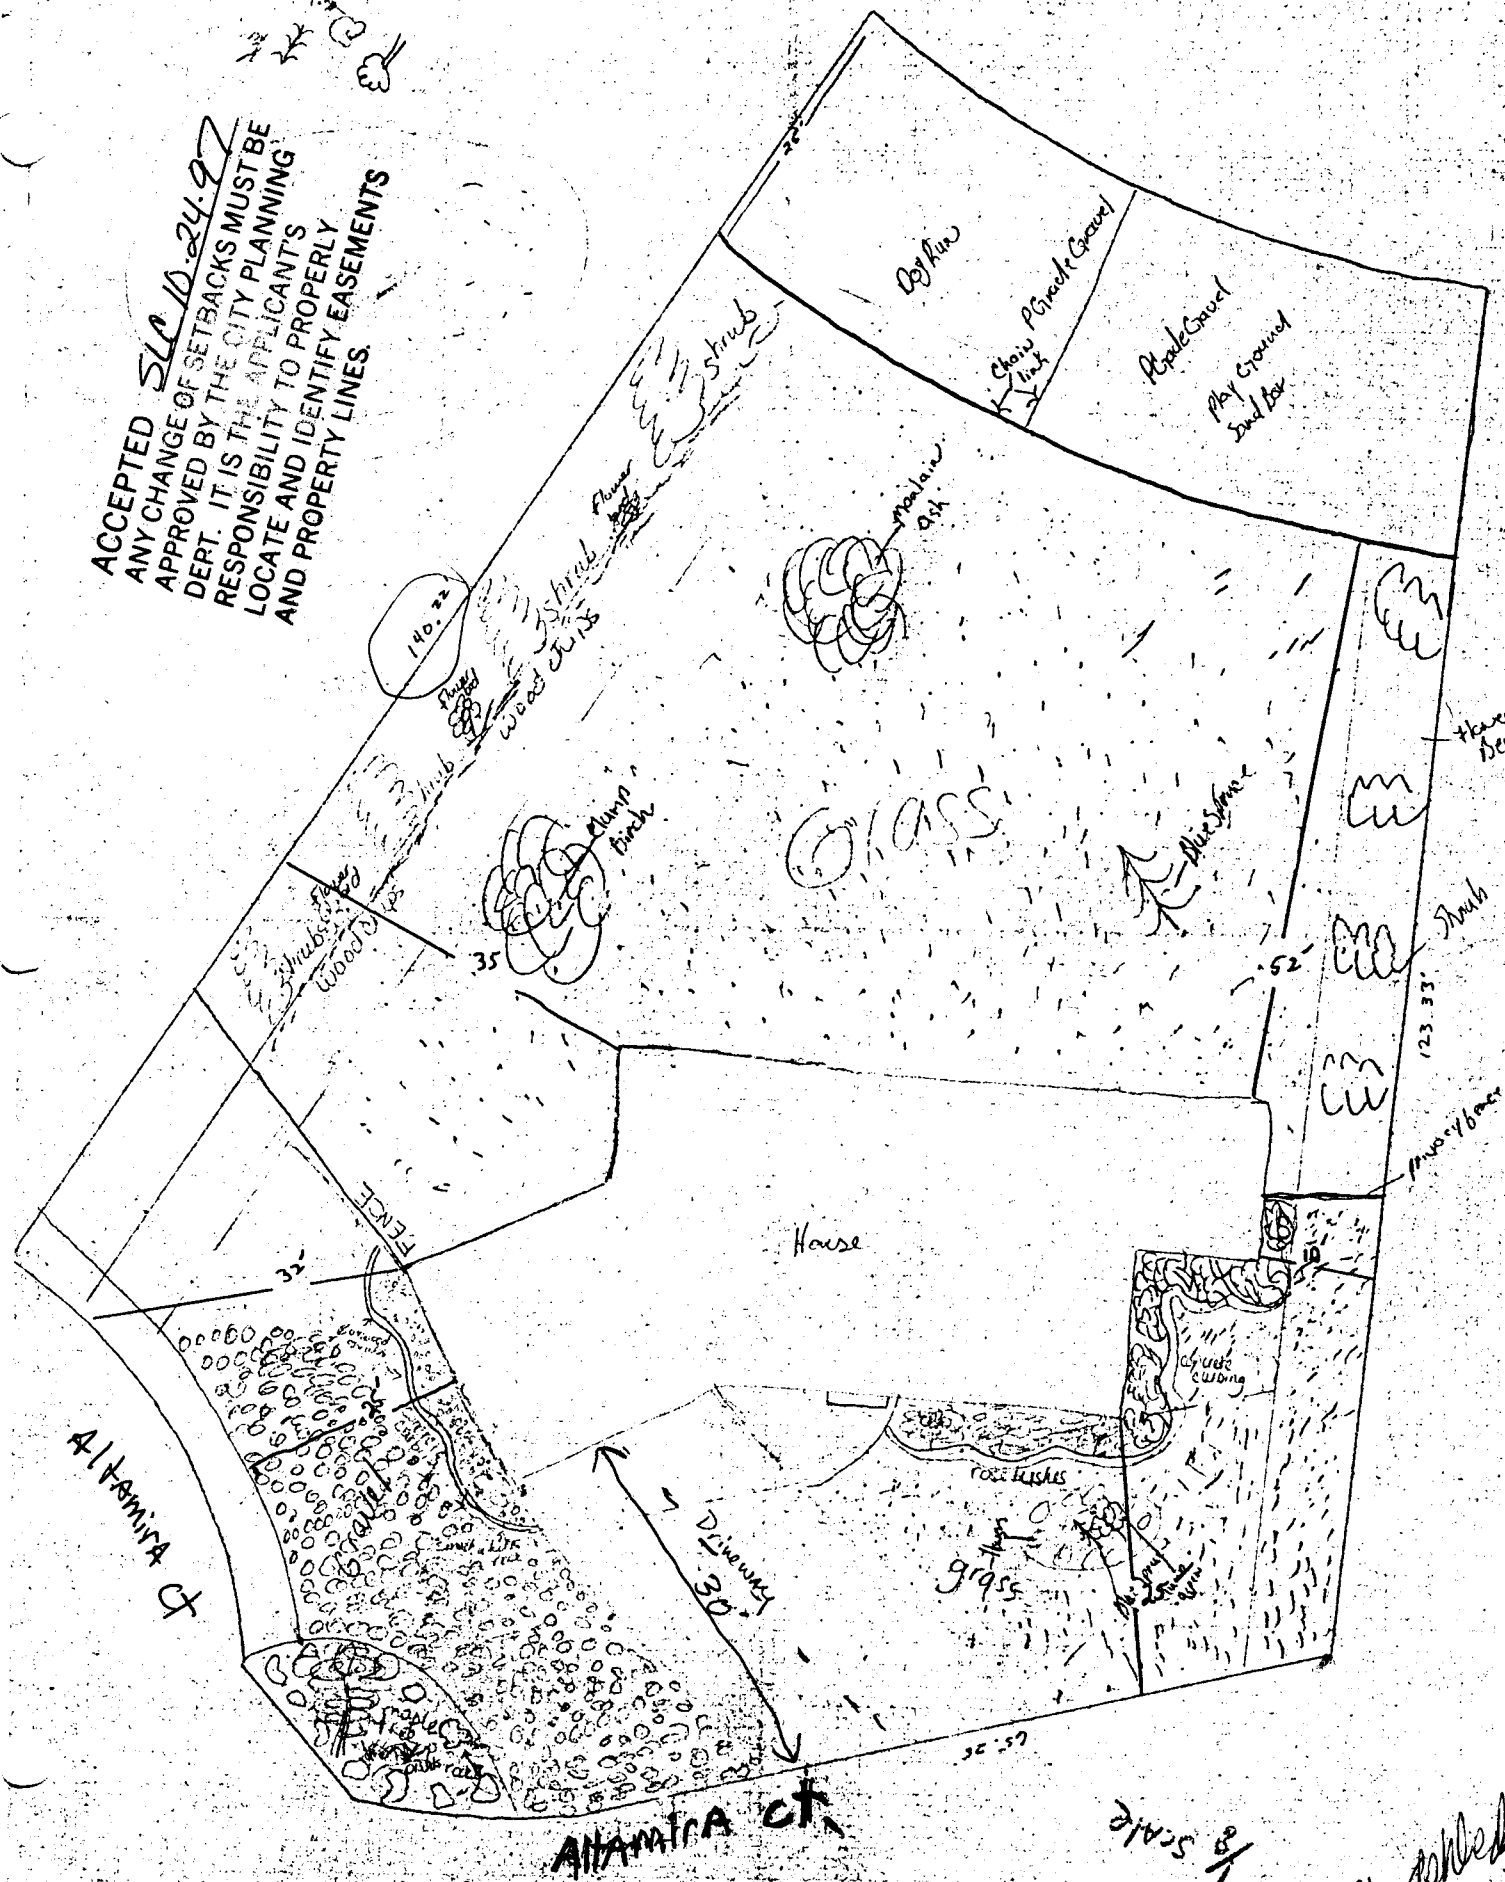

DRIVEWAY LOCATION OK. 10/21/97