

FEE \$	10 ⁰⁰
TCP \$	500 ⁰⁰
SIF \$	0



BLDG PERMIT NO. 61276

PLANNING CLEARANCE

(Single Family Residential and Accessory Structures)
Community Development Department



BLDG ADDRESS 1793 Bacon Ct. TAX SCHEDULE NO. 2945-234-14-003
 SUBDIVISION Micaela's Village SQ. FT. OF PROPOSED BLDG(S)/ADDITION 1380
 FILING _____ BLK 3 LOT 3 SQ. FT. OF EXISTING BLDG(S) -0-
 (1) OWNER Zeck + Associates, LLC NO. OF DWELLING UNITS
 BEFORE: 0 AFTER: 1 THIS CONSTRUCTION
 (1) ADDRESS P.O. Box 1083
 NO. OF BLDGS ON PARCEL
 BEFORE: 0 AFTER: 1 THIS CONSTRUCTION
 (1) TELEPHONE 257-9483
 USE OF EXISTING BLDGS None
 (2) APPLICANT Mansel L. Zeck
 DESCRIPTION OF WORK AND INTENDED USE: _____
 (2) ADDRESS P.O. Box 1083
 (2) TELEPHONE 257-9483 New single family residence

REQUIRED: One plot plan, on 8 1/2" x 11" paper, showing all existing & proposed structure location(s), parking, setbacks to all property lines, ingress/egress to the property, driveway location & width & all easements & rights-of-way which abut the parcel.

THIS SECTION TO BE COMPLETED BY COMMUNITY DEVELOPMENT DEPARTMENT STAFF

ZONE PR-~~sf~~ Maximum coverage of lot by structures _____
 SETBACKS: Front 20' from property line (PL) Parking Req'mt _____
 or _____ from center of ROW, whichever is greater Special Conditions _____
 Side 5' from PL Rear 15' on W from PL
25' on S
 Maximum Height _____
 CENSUS 13 TRAFFIC 80 ANN# _____

Modifications to this Planning Clearance must be approved, in writing, by the Director of the Community Development Department. The structure authorized by this application cannot be occupied until a final inspection has been completed and a Certificate of Occupancy has been issued by the Building Department (Section 305, Uniform Building Code).


I hereby acknowledge that I have read this application and the information is correct; I agree to comply with any and all codes, ordinances, laws, regulations or restrictions which apply to the project. I understand that failure to comply shall result in legal action, which may include but not necessarily be limited to non-use of the building(s).

Applicant Signature Mansel L. Zeck Date 7/22/97
 Department Approval Senita J. Castello Date 7/25/97

Additional water and/or sewer tap fee(s) are required: YES NO _____ W/O No. 10395
 Utility Accounting Chris Anderson Date 7-25-97

VALID FOR SIX MONTHS FROM DATE OF ISSUANCE (Section 9-3-2C Grand Junction Zoning & Development Code)

(White: Planning) (Yellow: Customer) (Pink: Building Department) (Goldenrod: Utility Accounting)

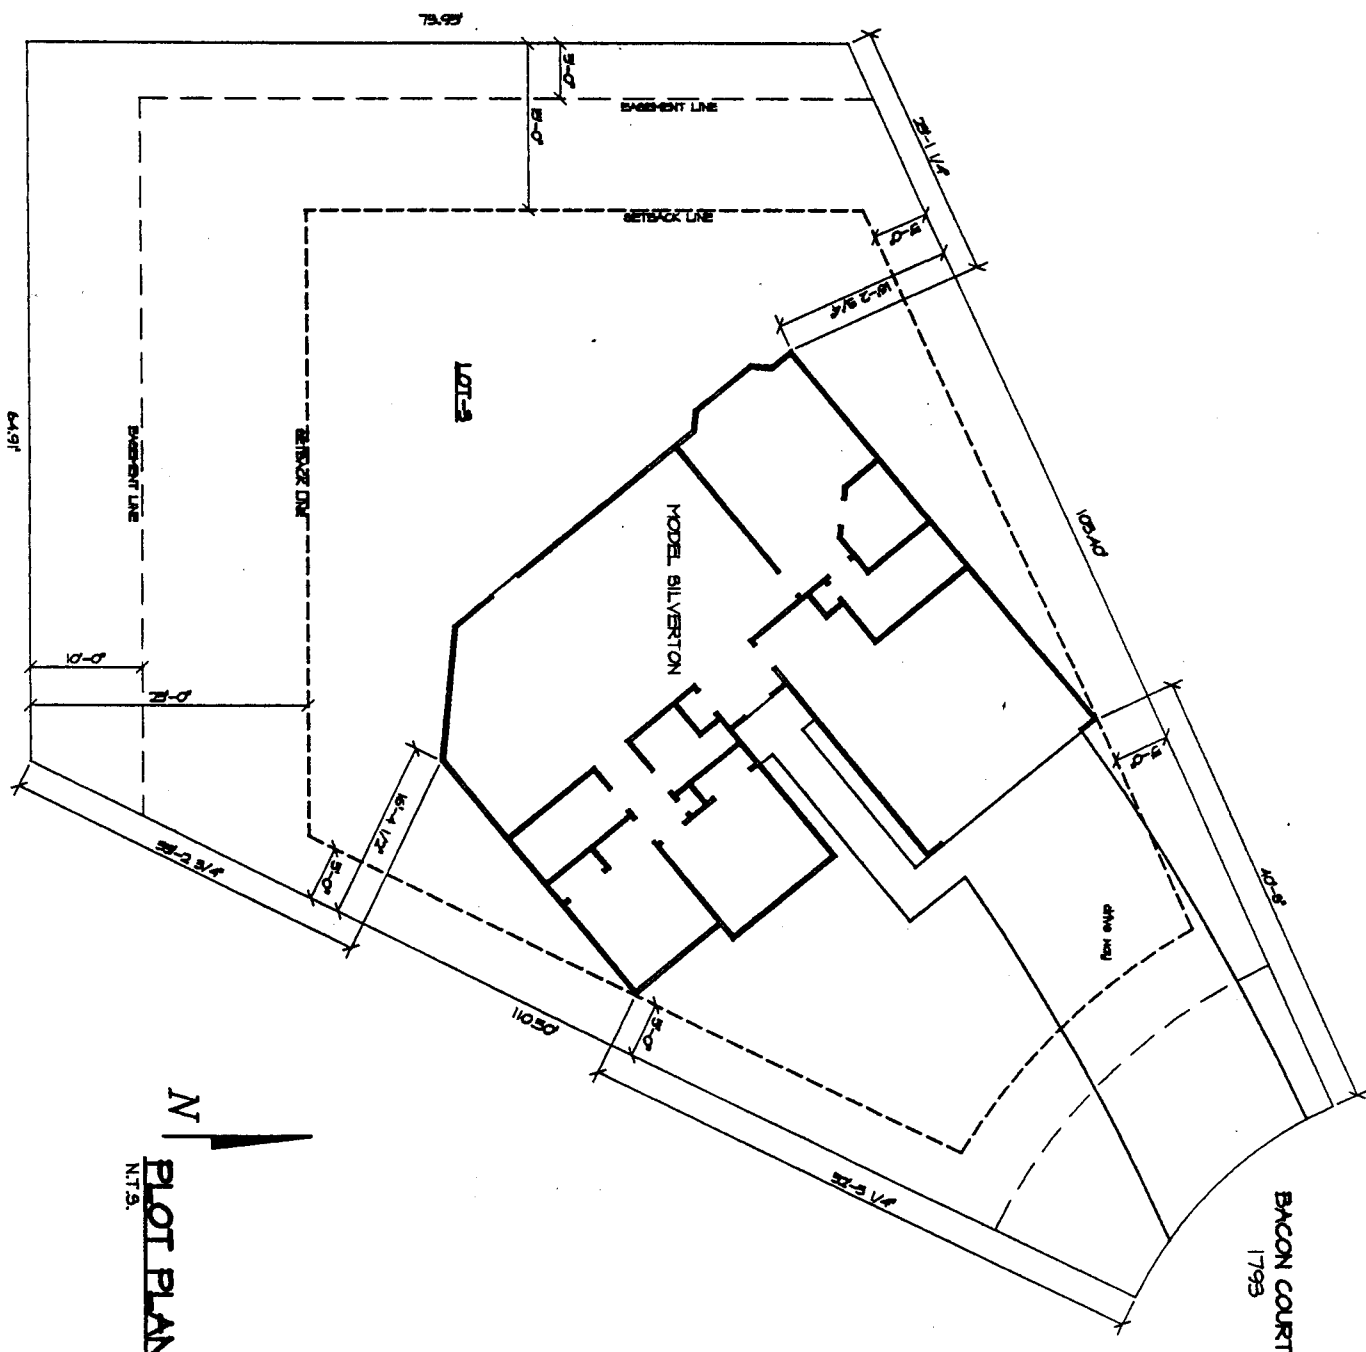

N
PLOT PLAN
 N.T.S.

ACCEPTED *SLC 7/25/97*
 ANY CHANGE OF SETBACKS MUST BE APPROVED BY THE CITY PLANNING DEPT. IT IS THE APPLICANT'S RESPONSIBILITY TO PROPERLY LOCATE AND IDENTIFY EASEMENTS AND PROPERTY LINES.

DRIVEWAY
 LOCATION OK
J. R. R. R.
 7-24-97

	JMK & Associates <small>200 1/2 S. Grand Ave., Grand Junction, CO. 81502 970-244-2222</small>		Zeck & Associates LLC <small>P.O. Box 1088 Grand Junction, CO. 81502 (970) 257-9488</small>	PLOT PLAN for LOT 3, BLOCK 3 Micaela Village Subdivision	
	<small>DATE: 7/24/97</small> <small>BY: JMK</small>		<small>SCALE: AS SHOWN</small>		