

FEE \$	10.00
TCP \$	0

BLDG PERMIT NO.	63175
-----------------	-------

SIF-292

PLANNING CLEARANCE
 (Single Family Residential and Accessory Structures)
 Grand Junction Community Development Department

THIS SECTION TO BE COMPLETED BY APPLICANT

BLDG ADDRESS 633 GOLD LEAF CT. TAX SCHEDULE NO. 2945-034-00-126
 SUBDIVISION FALL VALLEY SQ. FT. OF PROPOSED BLDG(S)/ADDITION 1465
 FILING 1 BLK 3 LOT 6 SQ. FT. OF EXISTING BLDG(S) NO
 (1) OWNER JOHN DAVIS NO. OF DWELLING UNITS BEFORE: 0 AFTER: 1 THIS CONSTRUCTION
 (1) ADDRESS P.O. BOX 2861
 (1) TELEPHONE 243-2308 NO. OF BLDGS ON PARCEL BEFORE: 0 AFTER: 1 THIS CONSTRUCTION
 (2) APPLICANT CASTLE HOMES, INC. USE OF EXISTING BLDGS NO
 (2) ADDRESS 556 25 ROAD DESCRIPTION OF WORK AND INTENDED USE: _____
 (2) TELEPHONE 248-0708 SFR

REQUIRED: Two (2) plot plans, on 8 1/2" x 11" paper, showing all existing and proposed structure location(s), parking, setbacks to all property lines, ingress/egress to the property, and all easements and rights-of-way which abut the parcel.

THIS SECTION TO BE COMPLETED BY COMMUNITY DEVELOPMENT DEPARTMENT STAFF

ZONE R2.9 Maximum coverage of lot by structures _____
 SETBACKS: Front 15' 20' for garage from property line (PL) Parking Req'mt 2
 or _____ from center of ROW, whichever is greater
 Side 10' from PL Rear 20' from PL Special Conditions _____
 Maximum Height 32' CENSUS TRACT 10 TRAFFIC ZONE 19

Modifications to this Planning Clearance must be approved, in writing, by the Director of the Community Development Department. The structure authorized by this application cannot be occupied until a final inspection has been completed and a Certificate of Occupancy has been issued by the Building Department (Section 305, Uniform Building Code).

I hereby acknowledge that I have read this application and the information is correct; I agree to comply with any and all codes, ordinances, laws, regulations or restrictions which apply to the project. I understand that failure to comply shall result in legal action, which may include but not necessarily be limited to non-use of the building(s).

Applicant Signature Margie D. Koch Date 12/4/97
 Department Approval Seeta J. Costello Date 12.8.97


Additional water and/or sewer tap fee(s) are required: YES X NO _____ W/O No. 10246
 Utility Accounting [Signature] Date 12/8/97

VALID FOR SIX MONTHS FROM DATE OF ISSUANCE (Section 9-3-2C Grand Junction Zoning & Development Code)

(White: Planning) (Yellow: Customer) (Pink: Building Department) (Goldenrod: Utility Accounting)

NOTE: I, THE ARCHITECT, OR THE ENGINEER OR OWNER TO VERIFY DETAILS AND REVISIONS FROM TO CONSTRUCTION.

FALL VALLEY SUBDIVISION BLOCK 3, LOT 6 FILING 1

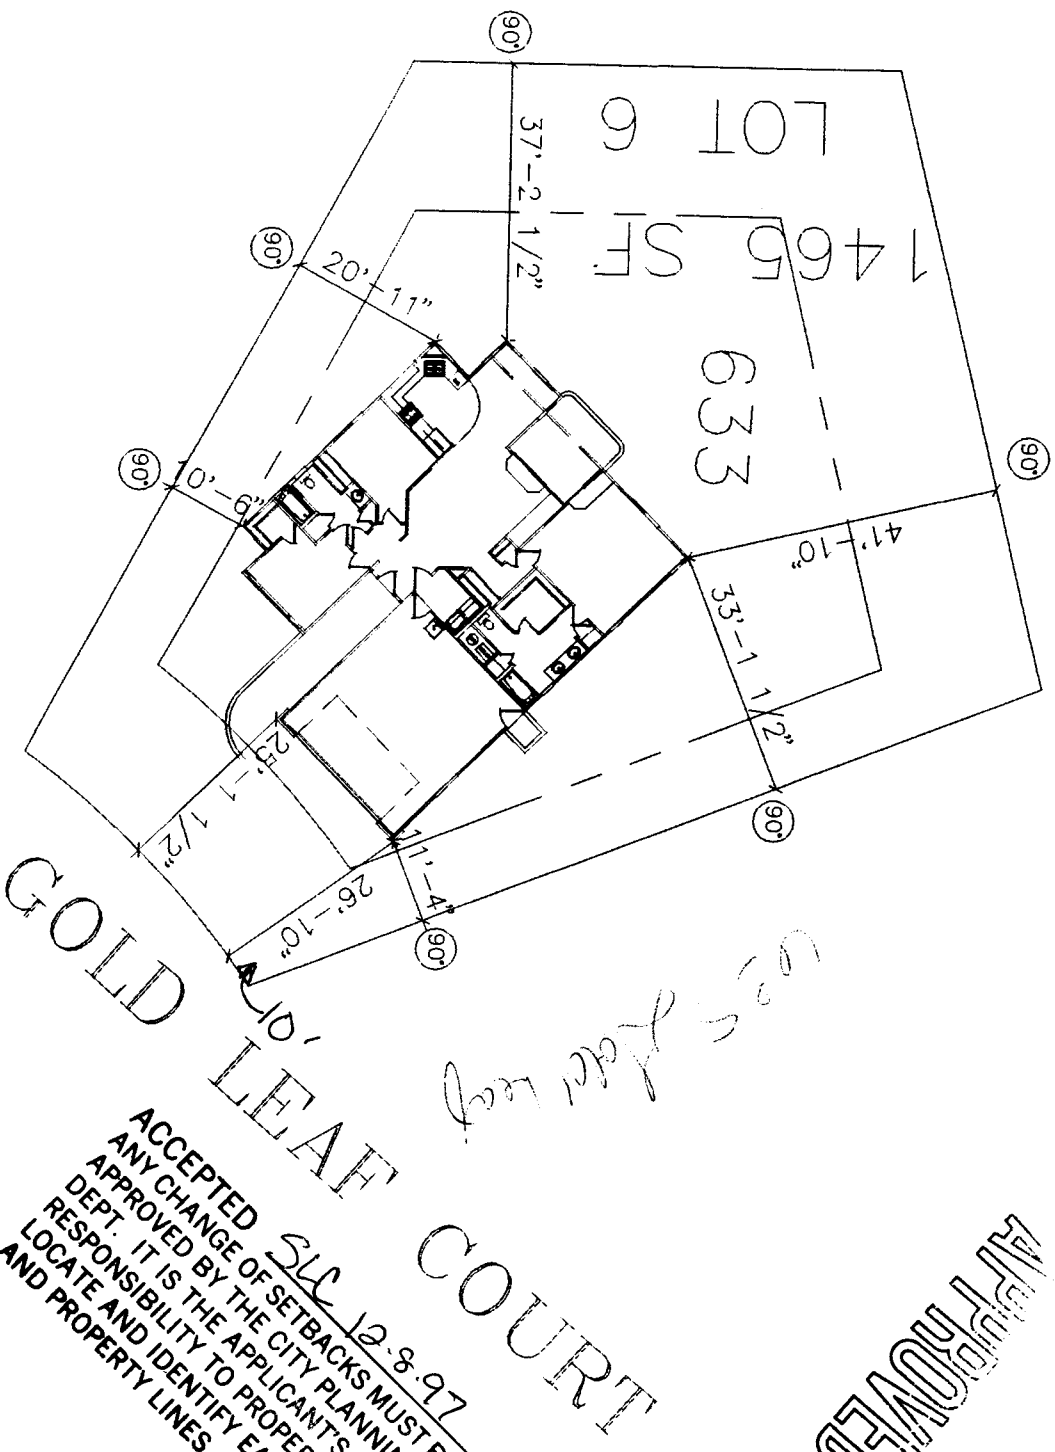

SCALE: 1/8" = 1'-0" (EXCEPT WHERE NOTED)

LOT PLAN

100% Fall Valley

GOLD LEAF COURT


ACCEPTED SLIC 12-8-97
ANY CHANGE OF SETBACKS MUST BE
APPROVED BY THE CITY PLANNING
DEPT. IT IS THE APPLICANT'S
RESPONSIBILITY TO PROPERLY
LOCATE AND IDENTIFY EASEMENTS
AND PROPERTY LINES.

APPROVED

*DRIVEWAY
LOCATION O.K.
R. Ashlock
12/5/97*

DATE	12-3-97
BY	AS
CHECKED	AS
SCALE	1/8" = 1'-0"
SHEET	1

CASTLE HOMES INC
F.V. PLOT PLANS

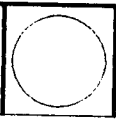

Auto DRAFT
COMPUTER AIDED DRAFTING
GRAND JUNCTION, CO (970) 241-6782

NO.	1
DATE	
BY	
CHECKED	
REVISIONS	