

FEE \$	10.00
TCP \$	—
SIF \$	292.00



BLDG PERMIT NO. 102203

PLANNING CLEARANCE
 (Single Family Residential and Accessory Structures)
Community Development Department

BLDG ADDRESS 639 Grand View Dr. TAX SCHEDULE NO. 2943-064-22-012

SUBDIVISION Grand View E SQ. FT. OF PROPOSED BLDG(S)/ADDITION 1850

FILING 2 BLK 3 LOT 12 SQ. FT. OF EXISTING BLDG(S) 0

(1) OWNER David McClelland NO. OF DWELLING UNITS BEFORE: 0 AFTER: 1 THIS CONSTRUCTION

(1) ADDRESS 3026 Moorland Cir. NO. OF BLDGS ON PARCEL BEFORE: 0 AFTER: 1 THIS CONSTRUCTION

(1) TELEPHONE 434-1420 USE OF EXISTING BLDGS —

(2) APPLICANT David McClelland DESCRIPTION OF WORK AND INTENDED USE: ofc

(2) ADDRESS 3026 Moorland Cir.

(2) TELEPHONE 434-1420

REQUIRED: One plot plan, on 8 1/2" x 11" paper, showing all existing & proposed structure location(s), parking, setbacks to all property lines, ingress/egress to the property, driveway location & width & all easements & rights-of-way which abut the parcel.

THIS SECTION TO BE COMPLETED BY COMMUNITY DEVELOPMENT DEPARTMENT STAFF

ZONE RSF-5 Maximum coverage of lot by structures 35%

SETBACKS: Front 20' from property line (PL) or — from center of ROW, whichever is greater Parking Req't 2

Side 5' from PL Rear 25' from PL Special Conditions —

Maximum Height 32'

CENSUS 10 TRAFFIC 22 ANNEX# —

Modifications to this Planning Clearance must be approved, in writing, by the Director of the Community Development Department. The structure authorized by this application cannot be occupied until a final inspection has been completed and a Certificate of Occupancy has been issued by the Building Department (Section 305, Uniform Building Code).

I hereby acknowledge that I have read this application and the information is correct; I agree to comply with any and all codes, ordinances, laws, regulations or restrictions which apply to the project. I understand that failure to comply shall result in legal action, which may include but not necessarily be limited to non-use of the building(s).

Applicant Signature David McClelland Date 10/3/97

Department Approval Kristen L. Andrews Date 10/3/97

Additional water and/or sewer tap fee(s) are required: YES NO W/O No. 10577

Utility Accounting Tracy Shipe Date 10/2/97

VALID FOR SIX MONTHS FROM DATE OF ISSUANCE (Section 9-3-2C Grand Junction Zoning & Development Code)


(White: Planning) (Yellow: Customer) (Pink: Building Department) (Goldenrod: Utility Accounting)

IN THE SPACE BELOW, PLEASE DRAW A SITE PLAN SHOWING THE FOLLOWING:

1. An outline of the PROPERTY LINES with dimensions.
2. A dotted line outline of the PROPOSED STRUCTURE and dimensions of the PROPOSED STRUCTURE.
3. The DISTANCE from the proposed structure to the front, rear and side property lines (setbacks)
4. All EASEMENTS or RIGHTS- OF -WAY on, or immediately adjacent to, the property.
5. All existing or proposed STRUCTURES on the property, including FENCES.
6. All STREETS adjacent to the property and street names.
7. All existing and proposed DRIVEWAYS, including length, width and distance from intersections.
8. Location of existing and/or PROPOSED PARKING and NUMBER OF SPACES.
9. An arrow indicating the direction NORTH.

ANY OF THE INFORMATION WHICH THE APPLICANT FAILS TO SHOW ON THE DRAWING WILL RESULT IN A DELAY IN OBTAINING THE BUILDING PERMIT.

Site

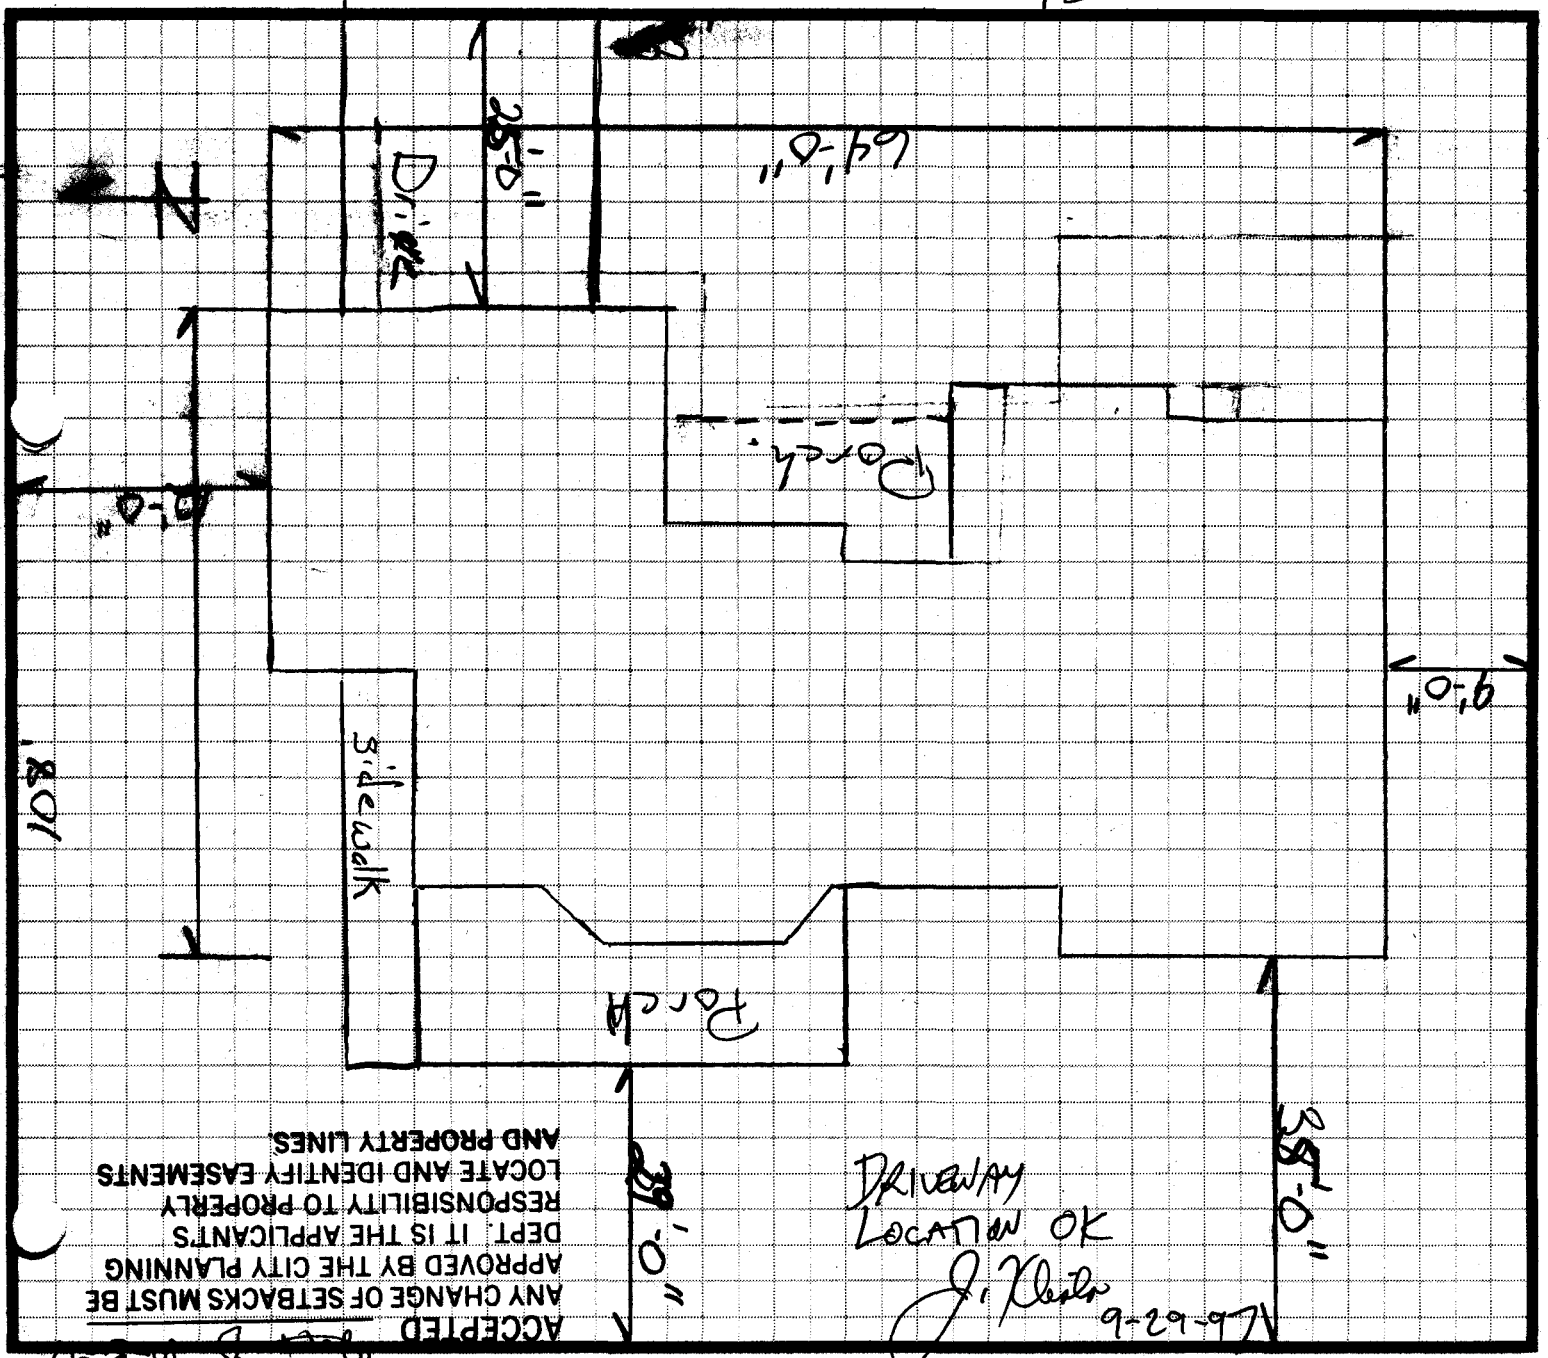

ACCEPTED ANY CHANGE OF SETBACKS MUST BE APPROVED BY THE CITY PLANNING DEPT. IT IS THE APPLICANT'S RESPONSIBILITY TO PROPERLY LOCATE AND IDENTIFY EASEMENTS AND PROPERTY LINES

Driveway Location OK
J. Kester
9-29-97

10-2-97