


FEE \$	10 ⁰⁰
TCP \$	0

BLDG PERMIT NO. 58700

PLANNING CLEARANCE
 (Single Family Residential and Accessory Structures)
 Grand Junction Community Development Department

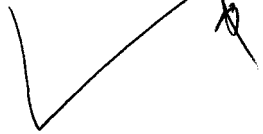

THIS SECTION TO BE COMPLETED BY APPLICANT

BLDG ADDRESS	676 Ignacio Ct	TAX SCHEDULE NO.	2945-032-25-005
SUBDIVISION	Valley Meadows	SQ. FT. OF PROPOSED BLDG(S)/ADDITION	1870
FILING	2 BLK 2 LOT 5	SQ. FT. OF EXISTING BLDG(S)	—
(1) OWNER	Haase & Assoc. Inc.	NO. OF DWELLING UNITS BEFORE:	0 AFTER: 1 THIS CONSTRUCTION
(1) ADDRESS	563 Village Way 81503	NO. OF BLDGS ON PARCEL BEFORE:	0 AFTER: 1 THIS CONSTRUCTION
(1) TELEPHONE	242-8681	USE OF EXISTING BLDGS	0
(2) APPLICANT	Don Haase	DESCRIPTION OF WORK AND INTENDED USE:	
(2) ADDRESS	563 Village Way		
(2) TELEPHONE	242-8681		NEW Residence

REQUIRED: Two (2) plot plans, on 8 1/2" x 11" paper, showing all existing and proposed structure location(s), parking, setbacks to all property lines, ingress/egress to the property, and all easements and rights-of-way which abut the parcel.

THIS SECTION TO BE COMPLETED BY COMMUNITY DEVELOPMENT DEPARTMENT STAFF

ZONE	PR 2.8	Maximum coverage of lot by structures	_____
SETBACKS: Front	20'	Parking Req'mt	_____
or	_____ from center of ROW, whichever is greater	Special Conditions	_____
Side	10' from PL		
Rear	20' from PL		
Maximum Height	_____		
		CENS.T.	10 T.ZONE 19 ANN#

Modifications to this Planning Clearance must be approved, in writing, by the Director of the Community Development Department. The structure authorized by this application cannot be occupied until a final inspection has been completed and a Certificate of Occupancy has been issued by the Building Department (Section 305, Uniform Building Code).

I hereby acknowledge that I have read this application and the information is correct; I agree to comply with any and all codes, ordinances, laws, regulations or restrictions which apply to the project. I understand that failure to comply shall result in legal action, which may include but not necessarily be limited to non-use of the building(s).


Applicant Signature	<i>Don Haase</i>	Date	1-6-97
Department Approval	<i>Santa Costello</i>	Date	1/8/97

Additional water and/or sewer tap fee(s) are required: YES NO W/O No. 9788

Utility Accounting *Andrews* Date 1-8-97

VALID FOR SIX MONTHS FROM DATE OF ISSUANCE (Section 9-3-2C Grand Junction Zoning & Development Code)

(White: Planning) (Yellow: Customer) (Pink: Building Department) (Goldenrod: Utility Accounting)

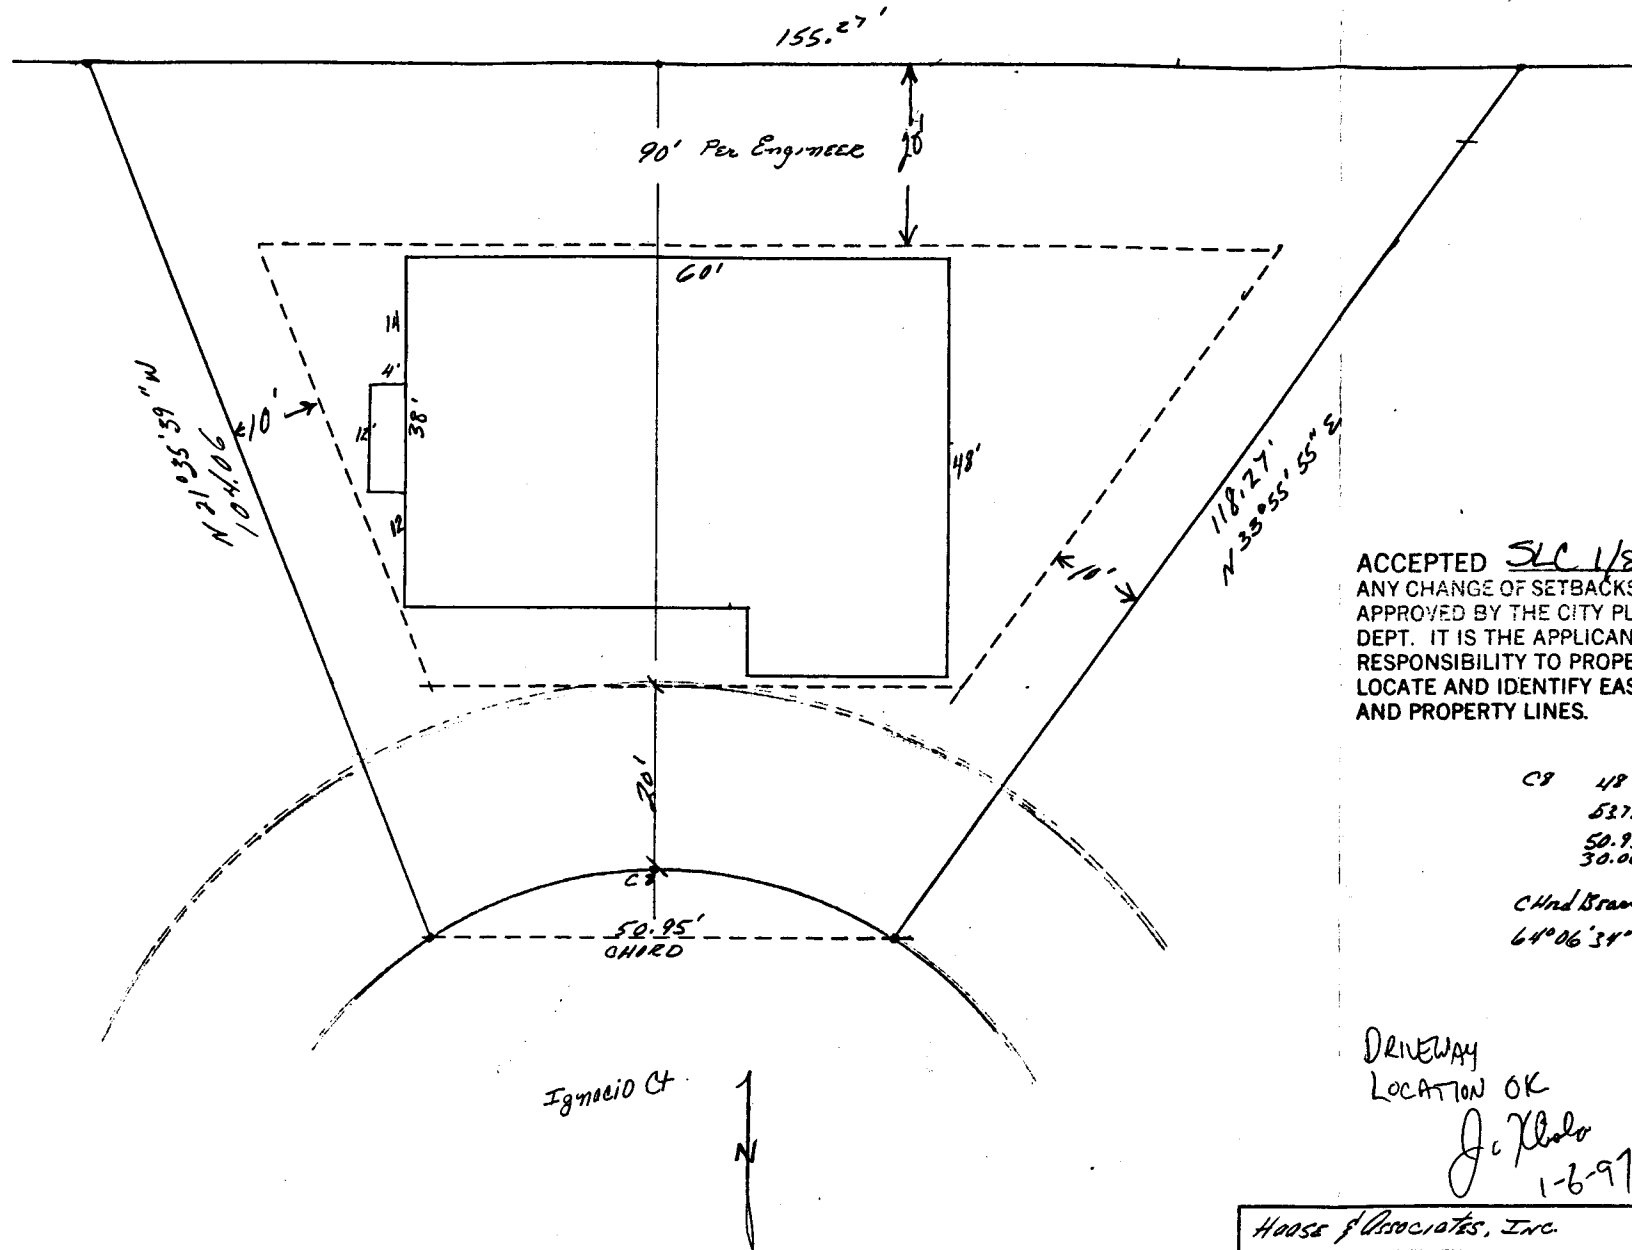

ACCEPTED SLC 1/8/96
 ANY CHANGE OF SETBACKS MUST BE APPROVED BY THE CITY PLANNING DEPT. IT IS THE APPLICANT'S RESPONSIBILITY TO PROPERLY LOCATE AND IDENTIFY EASEMENTS AND PROPERTY LINES.

CR 48' Radius
 53.71 Length
 50.95 Chord
 30.06 Tangent
 Chord Bearing N90E
 64° 06' 34" Dch L

DRIVEWAY
 LOCATION OK
 J. Kholo
 1-6-97

House of Associates, Inc.		
676 Ignacio Ct	SCALE	DRAWN BY Dan
		REVISED
DATE	APPROVED BY	DRAWING NUMBER
1-3-97		