

FEE \$ 10⁻
TCP \$ 500⁻

BLDG PERMIT NO. 60177

292⁻
\$ 802⁻

PLANNING CLEARANCE
(Single Family Residential and Accessory Structures)
Grand Junction Community Development Department



THIS SECTION TO BE COMPLETED BY APPLICANT

BLDG ADDRESS 662 Kapota TAX SCHEDULE NO. 2945-031-42-001
SUBDIVISION Valley Meadows East SQ. FT. OF PROPOSED BLDG(S)/ADDITION 1620
FILING 3 BLK 3 LOT 5 SQ. FT. OF EXISTING BLDG(S) n/a
(1) OWNER John Davis NO. OF DWELLING UNITS
BEFORE: _____ AFTER: 1 THIS CONSTRUCTION
(1) ADDRESS _____ NO. OF BLDGS ON PARCEL
BEFORE: _____ AFTER: 1 THIS CONSTRUCTION
(1) TELEPHONE 2432308 USE OF EXISTING BLDGS n/a
(2) APPLICANT Castle Homes Inc DESCRIPTION OF WORK AND INTENDED USE: _____
(2) ADDRESS 556 25 Rd SFR
(2) TELEPHONE 2489708

REQUIRED: Two (2) plot plans, on 8 1/2" x 11" paper, showing all existing and proposed structure location(s), parking, setbacks to all property lines, ingress/egress to the property, and all easements and rights-of-way which abut the parcel.

THIS SECTION TO BE COMPLETED BY COMMUNITY DEVELOPMENT DEPARTMENT STAFF

ZONE PR-2.93 Maximum coverage of lot by structures _____
SETBACKS: Front 20' from property line (PL) Parking Req'mt _____
or _____ from center of ROW, whichever is greater
Special Conditions Maintain min. 10' from
Side 10' from PL Rear 20' from PL edge of driveway to #
Maximum Height 32' CENSUS TRACT 19 TRAFFIC ZONE 10

Modifications to this Planning Clearance must be approved, in writing, by the Director of the Community Development Department. The structure authorized by this application cannot be occupied until a final inspection has been completed and a Certificate of Occupancy has been issued by the Building Department (Section 305, Uniform Building Code).

I hereby acknowledge that I have read this application and the information is correct; I agree to comply with any and all codes, ordinances, laws, regulations or restrictions which apply to the project. I understand that failure to comply shall result in legal action, which may include but not necessarily be limited to non-use of the building(s).

Applicant Signature Melanie D. Lock Date 8/13/97

Department Approval Antonio Costello Date 8/13/97

Additional water and/or sewer tap fee(s) are required: YES NO _____ W/O No. 10466

Utility Accounting Jacques Shapiro Date 8/13/97

VALID FOR SIX MONTHS FROM DATE OF ISSUANCE (Section 9-3-2C Grand Junction Zoning & Development Code)


(White: Planning) (Yellow: Customer) (Pink: Building Department) (Goldenrod: Utility Accounting)

APPROVED

CASTLE HOMES INC

VALLEY MEADOWS EAST - FILING No. THREE

(SPECIAL PLAN)
BLOCK 3
LOT 5

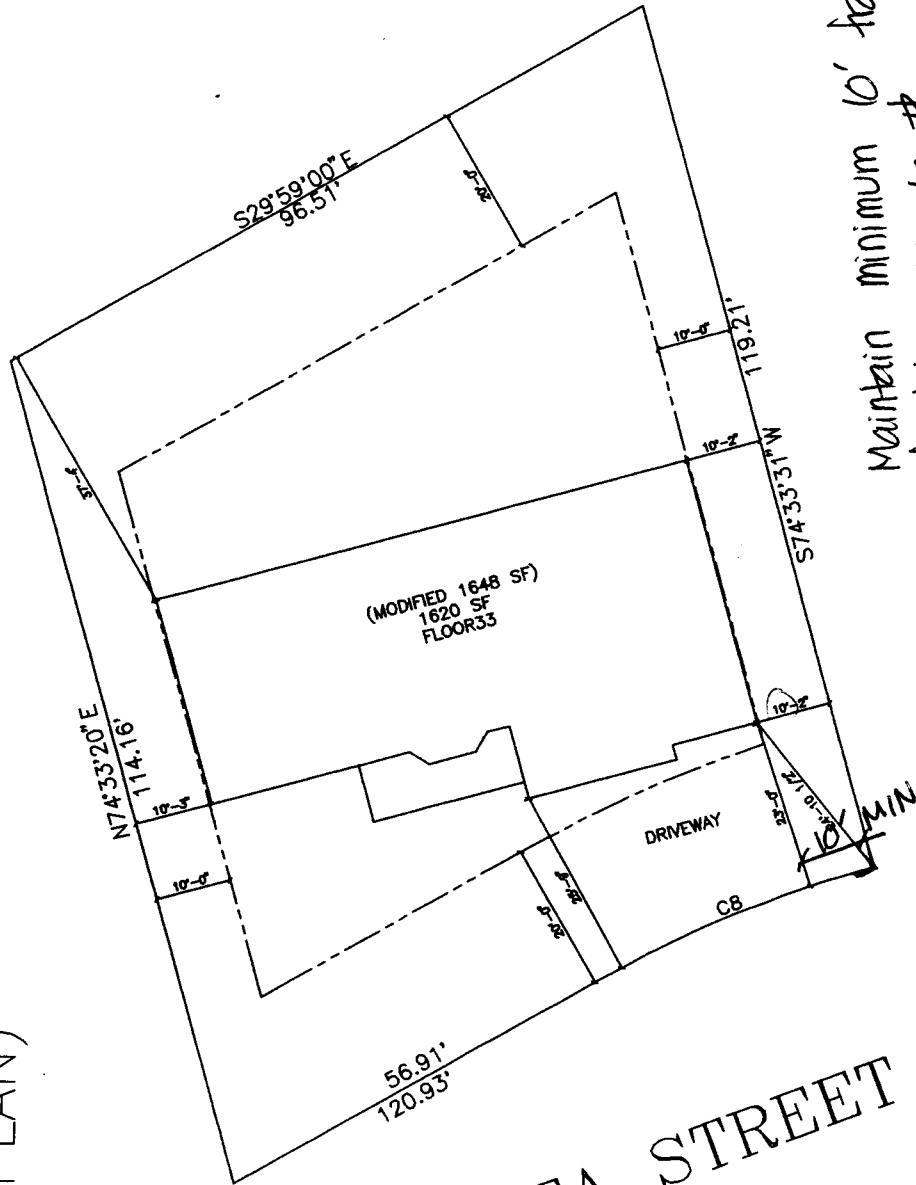

662-KAPOTA STREET

ACCEPTED SUC 8/13/97
ANY CHANGE OF SETBACKS MUST BE APPROVED BY THE CITY PLANNING DEPT. IT IS THE APPLICANT'S RESPONSIBILITY TO PROPERLY LOCATE AND IDENTIFY EASEMENTS AND PROPERTY LINES.

SCALE N.T.S.

Maintain minimum 10' from edge of driveway to FL
Driveway location o.k.
see sketch 5/2/97

REVISIONS
1
2
3
4
5
6
7
8
9
10

CASTLE HOMES INC

 DRAFT
 CONSULTING ARCHITECTS
 2819 1st St. #100
 DENVER, CO 80202

CASTLE HOMES INC

DATE
APPROVED
DATE
2-1-97
DATE
4/75