


FEE \$ 10⁻
TCP \$ 500⁻

BLDG PERMIT NO. 60179

292⁻
802⁻

PLANNING CLEARANCE
(Single Family Residential and Accessory Structures)
Grand Junction Community Development Department

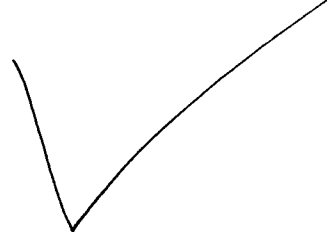

THIS SECTION TO BE COMPLETED BY APPLICANT

BLDG ADDRESS 664 Kapota ST TAX SCHEDULE NO. 2945-031-42-001
SUBDIVISION Valley Meadows East SQ. FT. OF PROPOSED BLDG(S)/ADDITION 1665
FILING 3 BLK 3 LOT 6 SQ. FT. OF EXISTING BLDG(S) n/a
(1) OWNER John Davis NO. OF DWELLING UNITS
BEFORE: _____ AFTER: 1 THIS CONSTRUCTION
(1) ADDRESS _____
(1) TELEPHONE 243 2308 NO. OF BLDGS ON PARCEL
BEFORE: _____ AFTER: 1 THIS CONSTRUCTION
(2) APPLICANT Castle Homes Inc USE OF EXISTING BLDGS n/a
(2) ADDRESS 556 25 Rd DESCRIPTION OF WORK AND INTENDED USE: _____
(2) TELEPHONE 248 9708 SFR

REQUIRED: Two (2) plot plans, on 8 1/2" x 11" paper, showing all existing and proposed structure location(s), parking, setbacks to all property lines, ingress/egress to the property, and all easements and rights-of-way which abut the parcel.

THIS SECTION TO BE COMPLETED BY COMMUNITY DEVELOPMENT DEPARTMENT STAFF

ZONE PR2.93 Maximum coverage of lot by structures _____
SETBACKS: Front 20' from property line (PL) Parking Req'mt _____
or _____ from center of ROW, whichever is greater Special Conditions _____
Side 10' from PL Rear 20' from PL
Maximum Height 32'
CENSUS TRACT 19 TRAFFIC ZONE 10

Modifications to this Planning Clearance must be approved, in writing, by the Director of the Community Development Department. The structure authorized by this application cannot be occupied until a final inspection has been completed and a Certificate of Occupancy has been issued by the Building Department (Section 305, Uniform Building Code).

I hereby acknowledge that I have read this application and the information is correct; I agree to comply with any and all codes, ordinances, laws, regulations or restrictions which apply to the project. I understand that failure to comply shall result in legal action, which may include but not necessarily be limited to non-use of the building(s).

Applicant Signature Melanie D. Fork Date 6/26/97

Department Approval Ronnie Edwards Date 6/26/97

Additional water and/or sewer tap fee(s) are required: YES NO _____ W/O No. 10315

Utility Accounting Chick Date 6-26-97

VALID FOR SIX MONTHS FROM DATE OF ISSUANCE (Section 9-3-2C Grand Junction Zoning & Development Code)

(White: Planning) (Yellow: Customer) (Pink: Building Department) (Goldenrod: Utility Accounting)


APPROVED

CASTLE HOMES INC
VALLEY MEADOWS EAST - FILING No. THREE

ACCEPTED *Ronnie 6/26/97*
ANY CHANGE OF SETBACKS MUST BE
APPROVED BY THE CITY PLANNING
DEPT. IT IS THE APPLICANT'S
RESPONSIBILITY TO PROPERLY
LOCATE AND IDENTIFY EASEMENTS
AND PROPERTY LINES.

BLOCK 3
LOT 6

5' utility easement this side - no overhang into easement.

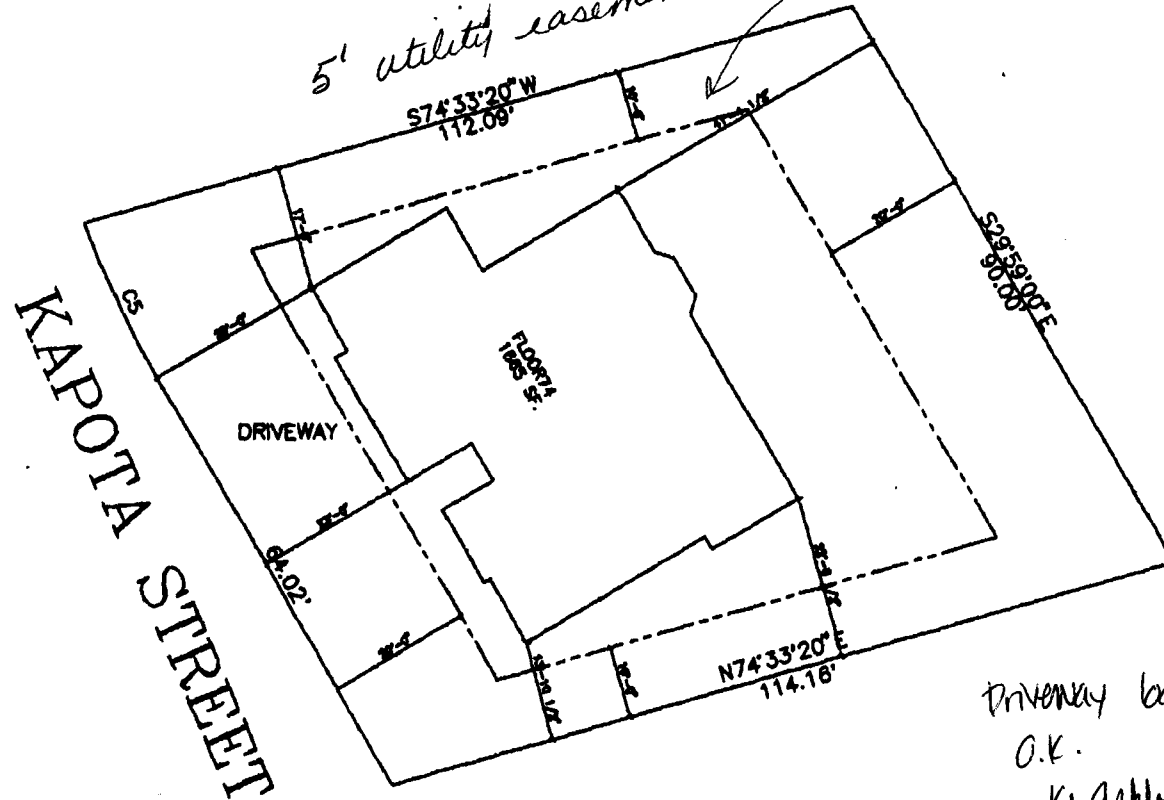

664 Kapota

*Driveway location
O.K.
Kashuk
5/2/97*

SCALE 1/16" = 1'-0"



AutoRAFT



CASTLE
HOMES INC

DATE
BY
CHECKED
DATE