

FEE'S	10 ⁰⁰
TCP \$	500 ⁰⁰
SIF \$	0



BLDG PERMIT NO. 60432

PLANNING CLEARANCE
(Single Family Residential and Accessory Structures)
Community Development Department

BLDG ADDRESS 1796 Lesa Ct. TAX SCHEDULE NO. 2945-234-13-004
 SUBDIVISION MICHAEL VILLAGE SQ. FT. OF PROPOSED BLDG(S)/ADDITION 1100
 FILING _____ BLK 2 LOT 4 SQ. FT. OF EXISTING BLDG(S) NA
 (1) OWNER Zeck & Associates NO. OF DWELLING UNITS BEFORE: 0 AFTER: 1 THIS CONSTRUCTION
 (1) ADDRESS P.O. BOX 1083
 (1) TELEPHONE 257-9483 NO. OF BLDGS ON PARCEL BEFORE: 0 AFTER: 1 THIS CONSTRUCTION
 (2) APPLICANT SANDE USE OF EXISTING BLDGS NA
 (2) ADDRESS _____ DESCRIPTION OF WORK AND INTENDED USE: _____
 (2) TELEPHONE _____ New S/M 66 Family Res.

REQUIRED: One plot plan, on 8 1/2" x 11" paper, showing all existing & proposed structure location(s), parking, setbacks to all property lines, ingress/egress to the property, driveway location & width & all easements & rights-of-way which abut the parcel.

THIS SECTION TO BE COMPLETED BY COMMUNITY DEVELOPMENT DEPARTMENT STAFF

ZONE PR-4 Maximum coverage of lot by structures _____
 SETBACKS: Front 20' from property line (PL) Parking Req'mt _____
 or _____ from center of ROW, whichever is greater
 Side 5' from PL Rear 25' from PL Special Conditions PAID
 Maximum Height _____ JUN 10 1997
 CENSUS 13 CM 80 ANNX# _____

Modifications to this Planning Clearance must be approved, in writing, by the Director of the Community Development Department. The structure authorized by this application cannot be occupied until a final inspection has been completed and a Certificate of Occupancy has been issued by the Building Department (Section 305, Uniform Building Code).


I hereby acknowledge that I have read this application and the information is correct; I agree to comply with any and all codes, ordinances, laws, regulations or restrictions which apply to the project. I understand that failure to comply shall result in legal action, which may include but not necessarily be limited to non-use of the building(s).

Applicant Signature [Signature] Date 5/16/97
 Department Approval [Signature] Date 6/10/97

Additional water and/or sewer tap fee(s) are required: YES NO W/O No. 10253
 Utility Accounting [Signature] Date 6/10/97

VALID FOR SIX MONTHS FROM DATE OF ISSUANCE (Section 9-3-2C Grand Junction Zoning & Development Code)

(White: Planning) (Yellow: Customer) (Pink: Building Department) (Goldenrod: Utility Accounting)

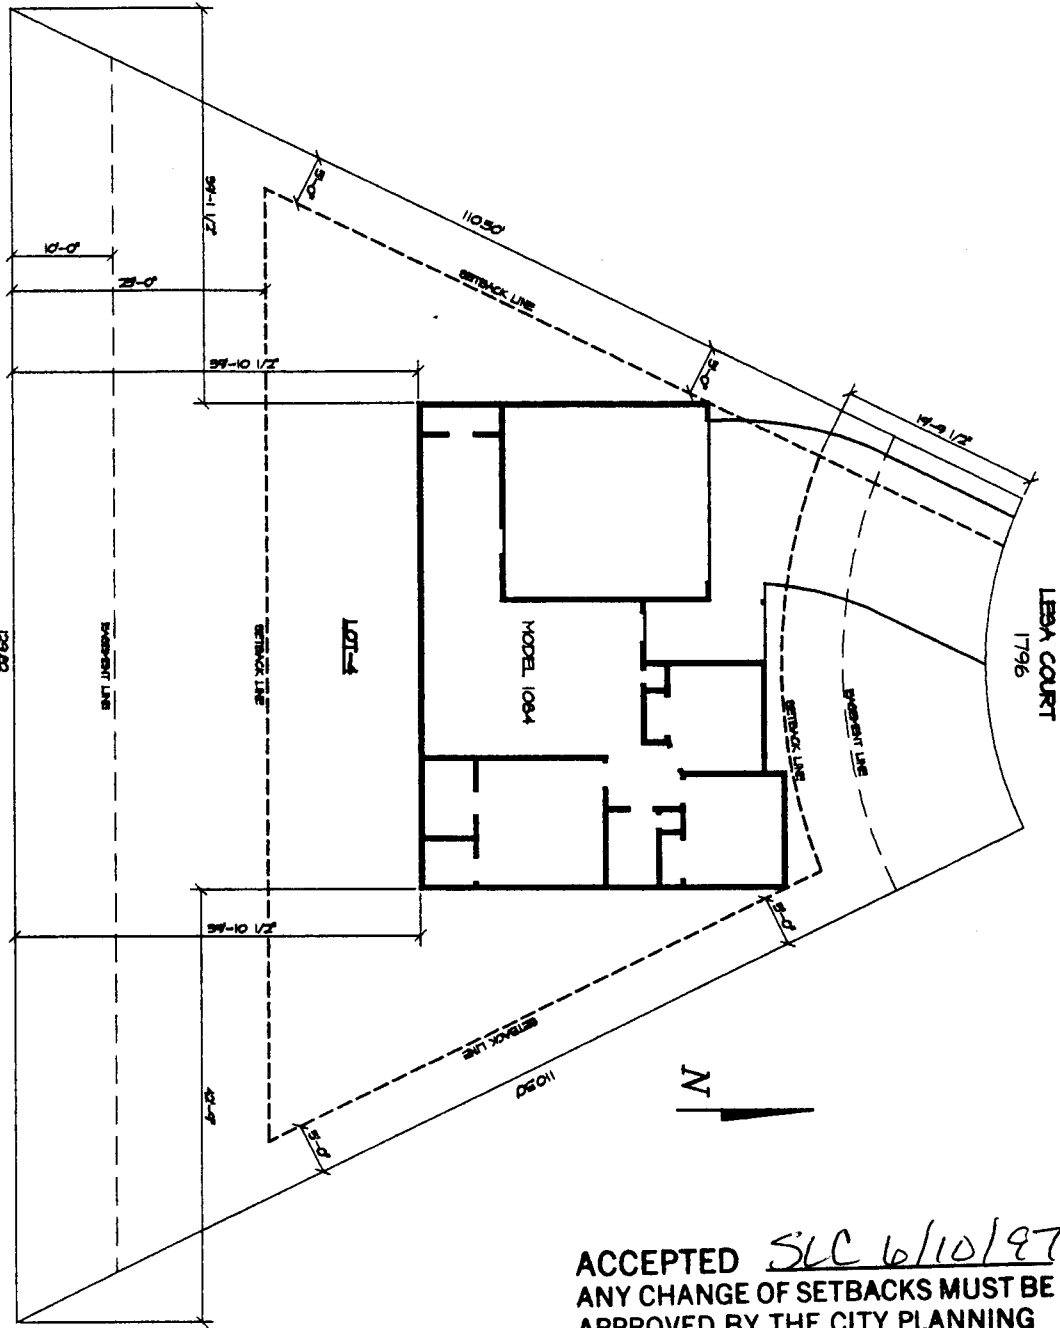

ACCEPTED SLC 6/10/97
 ANY CHANGE OF SETBACKS MUST BE APPROVED BY THE CITY PLANNING DEPT. IT IS THE APPLICANT'S RESPONSIBILITY TO PROPERLY LOCATE AND IDENTIFY EASEMENTS AND PROPERTY LINES.

Driveway location

OK. Washlet

5/20/97

PLOT PLAN
 SCALE: 1/8"=1'-0"

JMK & Associates
 2114
 970 257-0000

Zeck & Associates LLC
 P.O. Box 1069
 Grand Junction, CO. 81502
 (970) 257-9483

PLOT PLAN for
 LOT 4, BLOCK 2
 Micaela Village Subdivision
