

Planning \$ <u>5⁰⁰</u>	Drainage \$ <u>—</u>
TCP \$ <u>—</u>	School Impact \$ <u>—</u>

BLDG PERMIT NO. <u>61754</u>
FILE #

PLANNING CLEARANCE

(site plan review, multi-family development, non-residential development)

Grand Junction Community Development Department ✓

THIS SECTION TO BE COMPLETED BY APPLICANT

BLDG ADDRESS 359 Main St. TAX SCHEDULE NO. 2945-143-22-024/023

SUBDIVISION — SQ. FT. OF PROPOSED BLDG(S)/ADDITION —

FILING — BLK 119 LOT 7 thru 32 SQ. FT. OF EXISTING BLDG(S) —

(1) OWNER Normest Bank NO. OF DWELLING UNITS BEFORE: — AFTER: — CONSTRUCTION

(1) ADDRESS 359 Main St. NO. OF BLDGS ON PARCEL BEFORE: 1 AFTER: 1 CONSTRUCTION

(1) TELEPHONE 248-4808 USE OF ALL EXISTING BLDGS bank & offices

(2) APPLICANT Francis Constructors DESCRIPTION OF WORK & INTENDED USE: interior wall

(2) ADDRESS P.O. Box 176765 81502

(2) TELEPHONE 434-9093

✓ Submittal requirements are outlined in the SSID (Submittal Standards for Improvements and Development) document.

THIS SECTION TO BE COMPLETED BY COMMUNITY DEVELOPMENT DEPARTMENT STAFF

ZONE B-3 Landscaping / Screening Required: YES — NO —

SETBACKS: Front — from Property Line (PL) or — from center of ROW, whichever is greater Parking Req'mt —

Side — from PL Rear — from PL Special Conditions: interior only

Maximum Height — Census Tract 1 Traffic Zone 42 Annx # —

Maximum coverage of lot by structures —

Modifications to this Planning Clearance must be approved, in writing, by the Community Development Department Director. The structure authorized by this application cannot be occupied until a final inspection has been completed and a Certificate of Occupancy has been issued by the Building Department (Section 307, Uniform Building Code). Required improvements in the public right-of-way must be guaranteed prior to issuance of a Planning Clearance. All other required site improvements must be completed or guaranteed prior to issuance of a Certificate of Occupancy. Any landscaping required by this permit shall be maintained in an acceptable and healthy condition. The replacement of any vegetation materials that die or are in an unhealthy condition is required by the G.J. Zoning and Development Code.

Four (4) sets of final construction drawings must be submitted and stamped by City Engineering prior to issuing the Planning Clearance. One stamped set must be available on the job site at all times.

I hereby acknowledge that I have read this application and the information is correct; I agree to comply with any and all codes, ordinances, laws, regulations, or restrictions which apply to the project. I understand that failure to comply shall result in legal action, which may include but not necessarily be limited to non-use of the building(s).

Applicant's Signature [Signature] Date 8/26/97


Department Approval [Signature] Date 8/26/97

Additional water and/or sewer tap fee(s) are required: YES — NO ✓ W/O No. —

Utility Accounting [Signature] Date 8/26/97

VALID FOR SIX MONTHS FROM DATE OF ISSUANCE (Section 9-3-2C Grand Junction Zoning & Development Code)

(White: Planning) (Yellow: Customer) (Pink: Building Department) (Goldenrod: Utility Accounting)

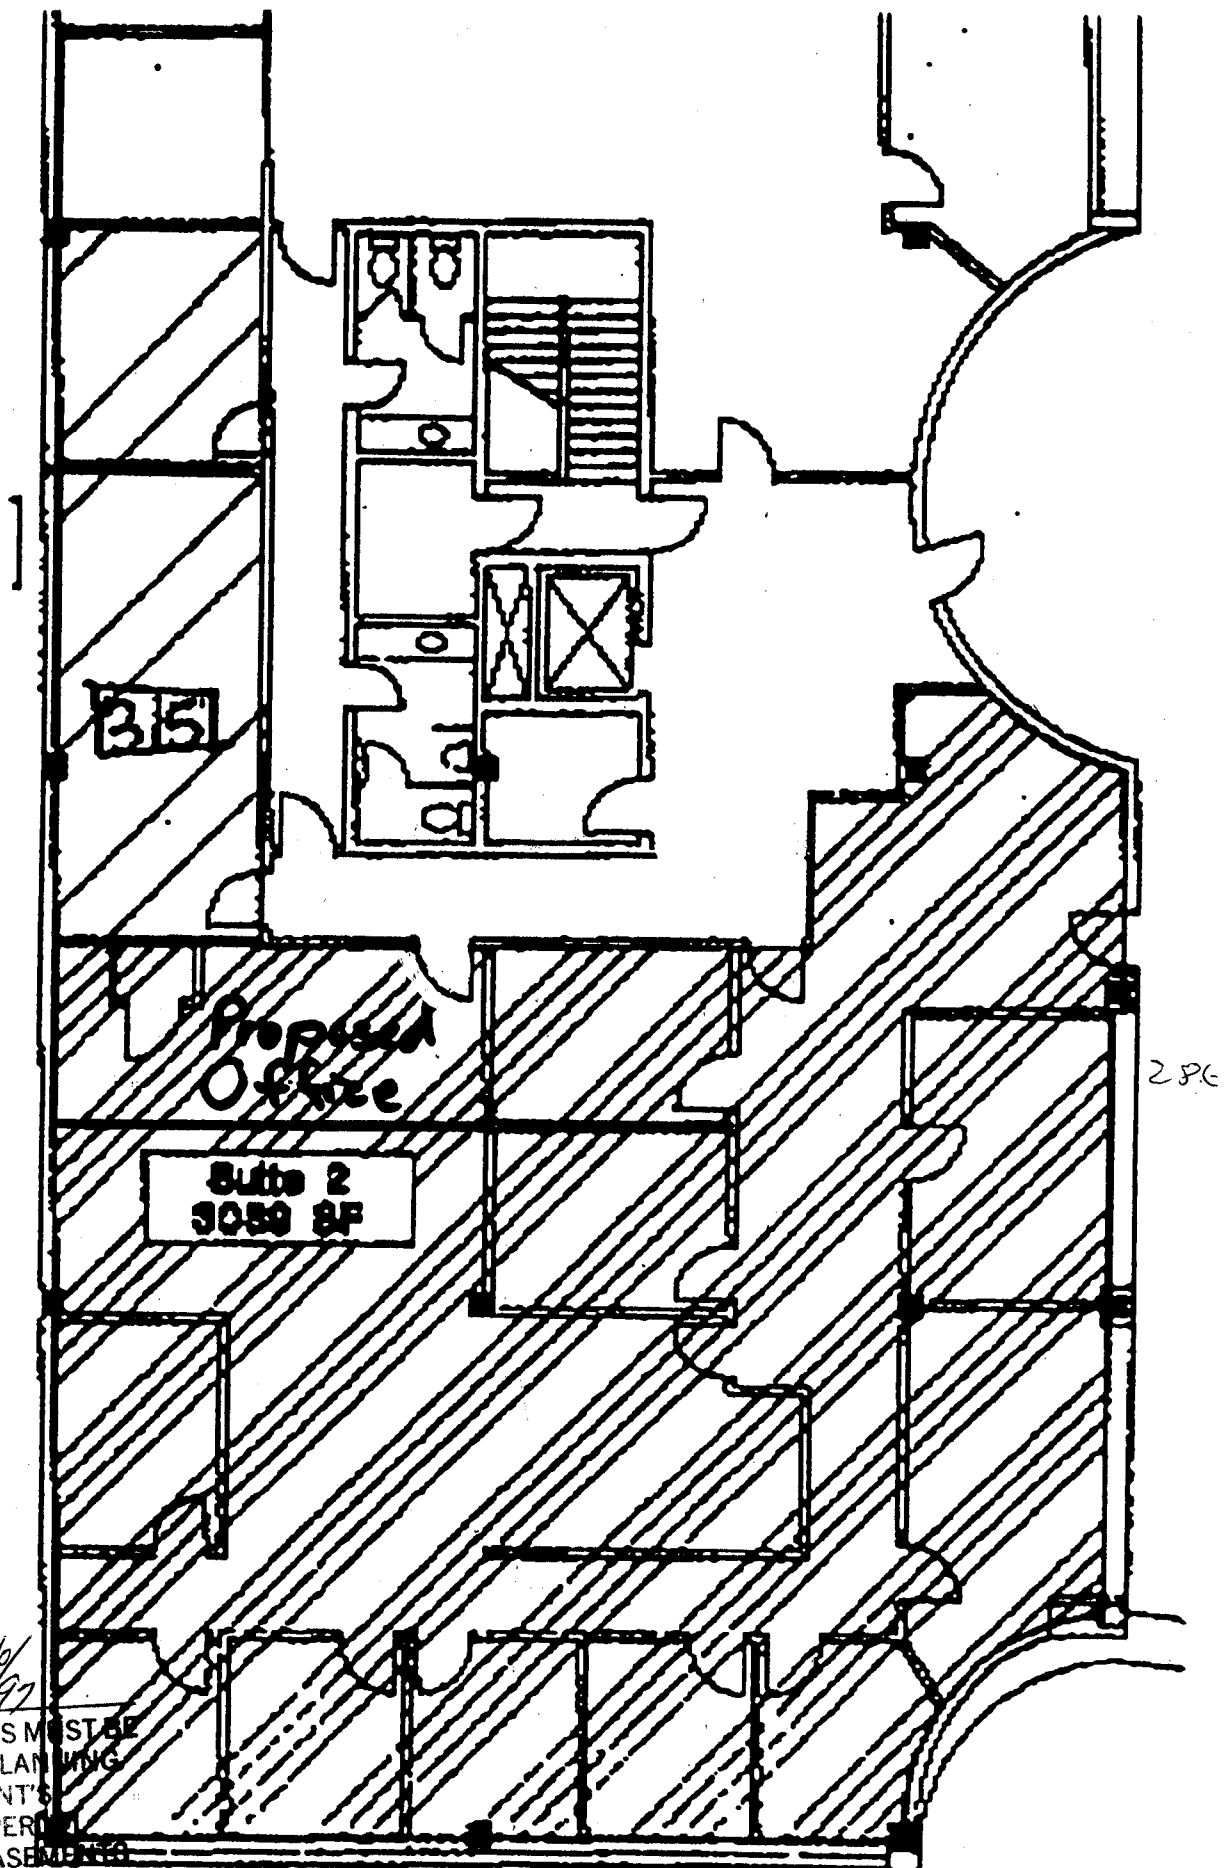

315

Proposed Office

Suite 2
3050 SF

286

ACCEPTED *Ronnie 8/26/97*
 ANY CHANGE OF SETBACKS MUST BE APPROVED BY THE CITY PLANNING DEPARTMENT. IT IS THE APPLICANT'S RESPONSIBILITY TO PROPERLY LOCATE AND IDENTIFY EASEMENTS AND PROPERTY LINES.

interior wall only

① Annex
 1222 W. 7th St