


FEE \$ 10.00  
TCP \$ -0-

BLDG PERMIT NO. 59484

SIF 29200 (pd)

**PLANNING CLEARANCE**  
(Single Family Residential and Accessory Structures)  
**Grand Junction Community Development Department**

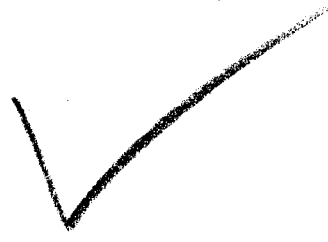

**THIS SECTION TO BE COMPLETED BY APPLICANT**

BLDG ADDRESS 2224 Mescalero AV TAX SCHEDULE NO. 2945-183-00-039  
SUBDIVISION Trail West SQ. FT. OF PROPOSED BLDG(S)/ADDITION 1920  
FILING 1 BLK 1 LOT 6 SQ. FT. OF EXISTING BLDG(S) N/A  
(1) OWNER Concept Builder LLC NO. OF DWELLING UNITS  
BEFORE: \_\_\_\_\_ AFTER: \_\_\_\_\_ THIS CONSTRUCTION  
(1) ADDRESS 2641 Chestnut Dr. 81506  
(1) TELEPHONE (250-0303) (241-1050) NO. OF BLDGS ON PARCEL  
BEFORE: \_\_\_\_\_ AFTER: \_\_\_\_\_ THIS CONSTRUCTION  
(2) APPLICANT DON HICKMAN USE OF EXISTING BLDGS \_\_\_\_\_  
(2) ADDRESS SAME DESCRIPTION OF WORK AND INTENDED USE: \_\_\_\_\_  
(2) TELEPHONE \_\_\_\_\_ new Home

**REQUIRED:** Two (2) plot plans, on 8 1/2" x 11" paper, showing all existing and proposed structure location(s), parking, setbacks to all property lines, ingress/egress to the property, and all easements and rights-of-way which abut the parcel.

**THIS SECTION TO BE COMPLETED BY COMMUNITY DEVELOPMENT DEPARTMENT STAFF**

ZONE RSF-4 Maximum coverage of lot by structures 35%  
SETBACKS: Front 23' from property line (PL) Parking Req't 2  
or \_\_\_\_\_ from center of ROW, whichever is greater  
Side 7' from PL Rear 30' from PL Special Conditions \_\_\_\_\_  
Maximum Height 32'  
CENSUS TRACT 1401 TRAFFIC ZONE 63

Modifications to this Planning Clearance must be approved, in writing, by the Director of the Community Development Department. The structure authorized by this application cannot be occupied until a final inspection has been completed and a Certificate of Occupancy has been issued by the Building Department (Section 305, Uniform Building Code).

I hereby acknowledge that I have read this application and the information is correct; I agree to comply with any and all codes, ordinances, laws, regulations or restrictions which apply to the project. I understand that failure to comply shall result in legal action, which may include but not necessarily be limited to non-use of the building(s).

Applicant Signature Don Hickman Date 3-18-97  
Department Approval Marcia Biddeman Date 3-18-97


Additional water and/or sewer tap fee(s) are required: YES  NO \_\_\_\_\_ W/O No. 0990  
Utility Accounting As road Department Date 3-18-97

VALID FOR SIX MONTHS FROM DATE OF ISSUANCE (Section 9-3-2C Grand Junction Zoning & Development Code)

(White: Planning) (Yellow: Customer) (Pink: Building Department) (Goldenrod: Utility Accounting)

2224 Mescalero AV

E ← → W

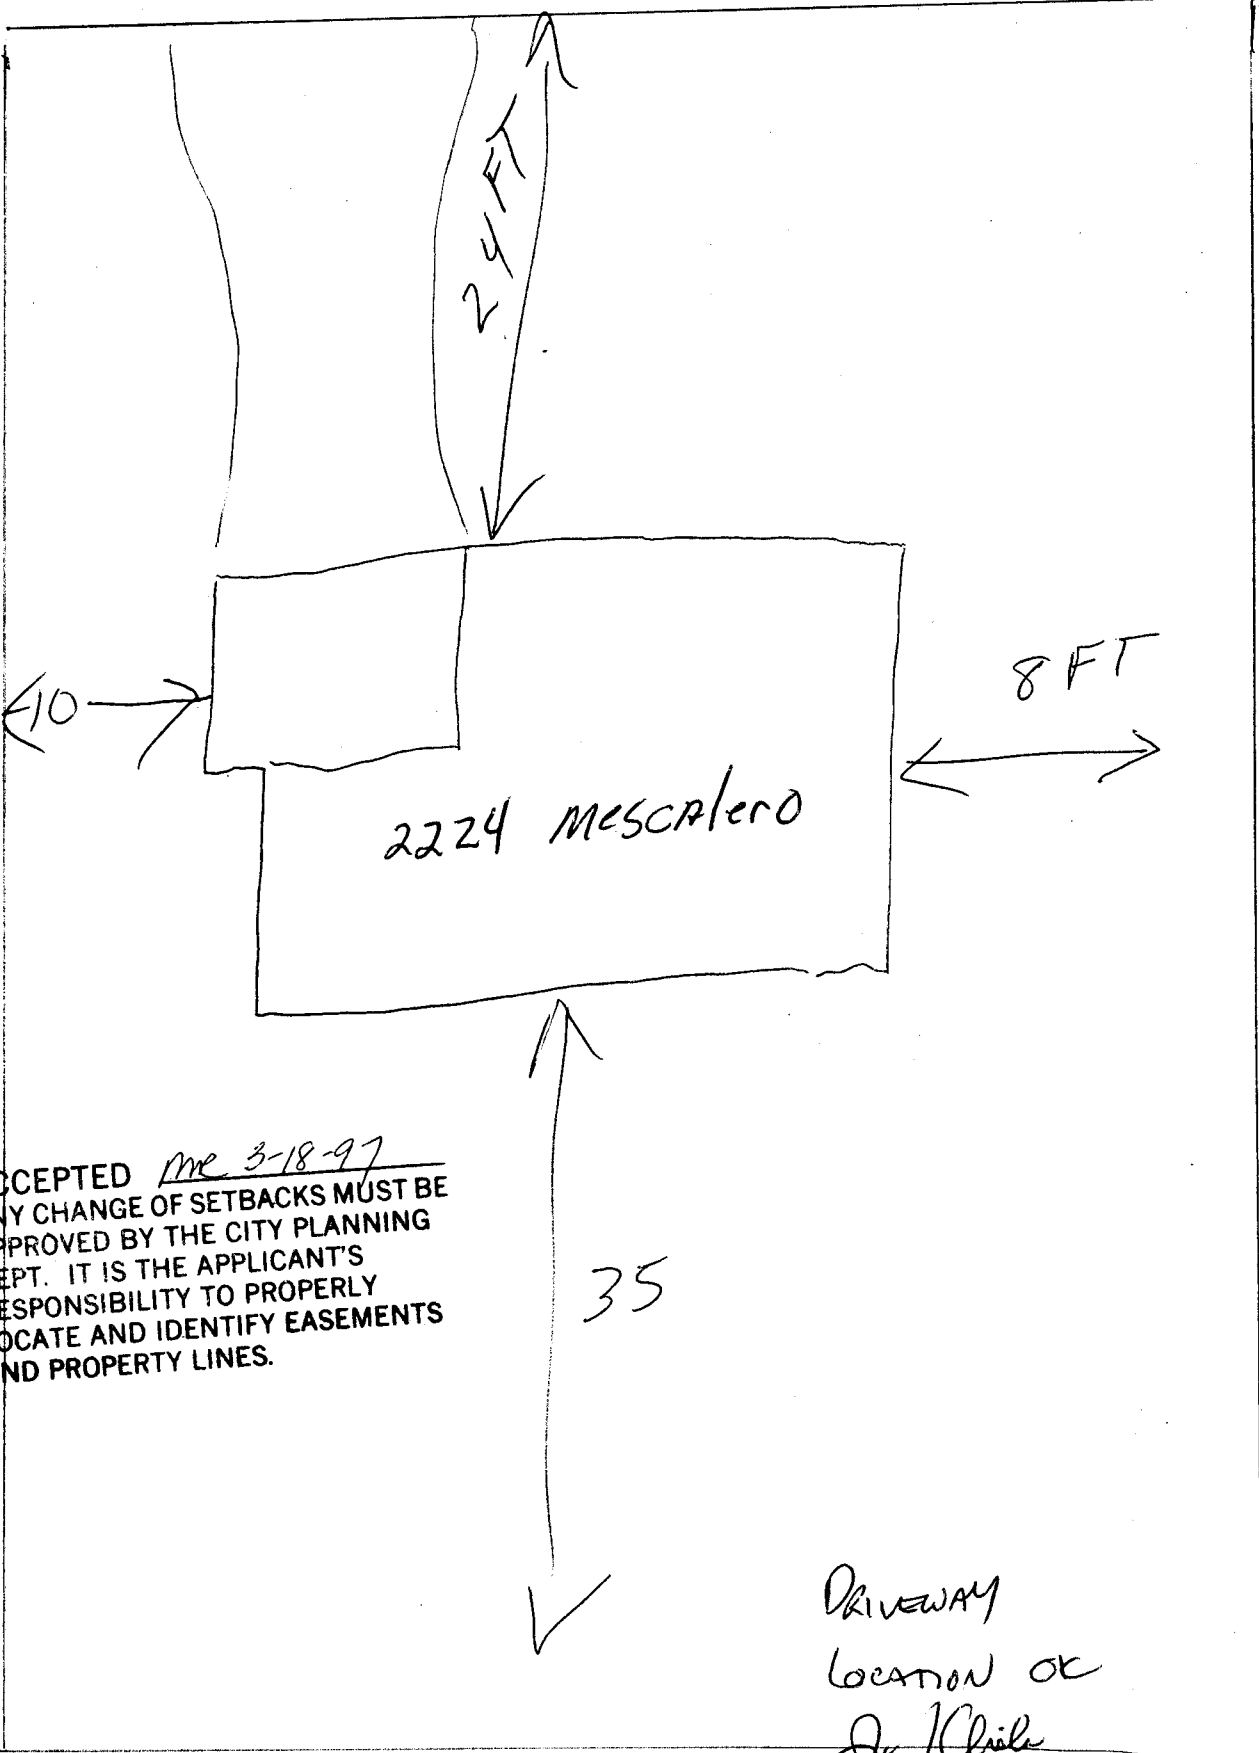

2224 Mescalero

ACCEPTED me 3-18-97  
 ANY CHANGE OF SETBACKS MUST BE  
 APPROVED BY THE CITY PLANNING  
 DEPT. IT IS THE APPLICANT'S  
 RESPONSIBILITY TO PROPERLY  
 LOCATE AND IDENTIFY EASEMENTS  
 AND PROPERTY LINES.

35

DRIVEWAY  
 LOCATION OK  
 J. Childs  
 3-12-97