

FEE \$	10.00
TCP \$	-0-
SIF \$	PL



BLDG PERMIT NO. 59983

PLANNING CLEARANCE
 (Single Family Residential and Accessory Structures)
Community Development Department

BLDG ADDRESS 2229 Mesquero TAX SCHEDULE NO. 2845 183 04 008
 SUBDIVISION Jewels West SQ. FT. OF PROPOSED BLDG(S)/ADDITION 1643 sq. ft.
 FILING 1 BLK 2 LOT 8 SQ. FT. OF EXISTING BLDG(S) -0-
 (1) OWNER Clint & Tamara Shiflet NO. OF DWELLING UNITS
 BEFORE: 0 AFTER: 1 THIS CONSTRUCTION
 (1) ADDRESS 481 Fruitwood
 (1) TELEPHONE 970 523 5445 NO. OF BLDGS ON PARCEL
 BEFORE: 0 AFTER: 1 THIS CONSTRUCTION
 (2) APPLICANT Marcus Costopoulos USE OF EXISTING BLDGS N/A
 (2) ADDRESS 481 Fruitwood Dr. DESCRIPTION OF WORK AND INTENDED USE:
 (2) TELEPHONE 970 523 0485 New ranch style home

REQUIRED: One plot plan, on 8 1/2" x 11" paper, showing all existing & proposed structure location(s), parking, setbacks to all property lines, ingress/egress to the property, driveway location & width & all easements & rights-of-way which abut the parcel.

THIS SECTION TO BE COMPLETED BY COMMUNITY DEVELOPMENT DEPARTMENT STAFF

ZONE RSF-4 Maximum coverage of lot by structures 35%
 SETBACKS: Front 23' from property line (PL) Parking Req'mt 2
 or 45' from center of ROW, whichever is greater Special Conditions _____
 Side 7' from PL Rear 30' from PL
 Maximum Height 32'
 CENSUS 1401 TRAFFIC 63 ANN# _____

Modifications to this Planning Clearance must be approved, in writing, by the Director of the Community Development Department. The structure authorized by this application cannot be occupied until a final inspection has been completed and a Certificate of Occupancy has been issued by the Building Department (Section 305, Uniform Building Code).


I hereby acknowledge that I have read this application and the information is correct; I agree to comply with any and all codes, ordinances, laws, regulations or restrictions which apply to the project. I understand that failure to comply shall result in legal action, which may include but not necessarily be limited to non-use of the building(s).

Applicant Signature [Signature] Date X 4/16/97
 Department Approval [Signature] Date 5-7-97

Additional water and/or sewer tap fee(s) are required: YES NO _____ W/O No. 10154
 Utility Accounting [Signature] Date 5-7-97

VALID FOR SIX MONTHS FROM DATE OF ISSUANCE (Section 9-3-2C Grand Junction Zoning & Development Code)

(White: Planning) (Yellow: Customer) (Pink: Building Department) (Goldenrod: Utility Accounting)

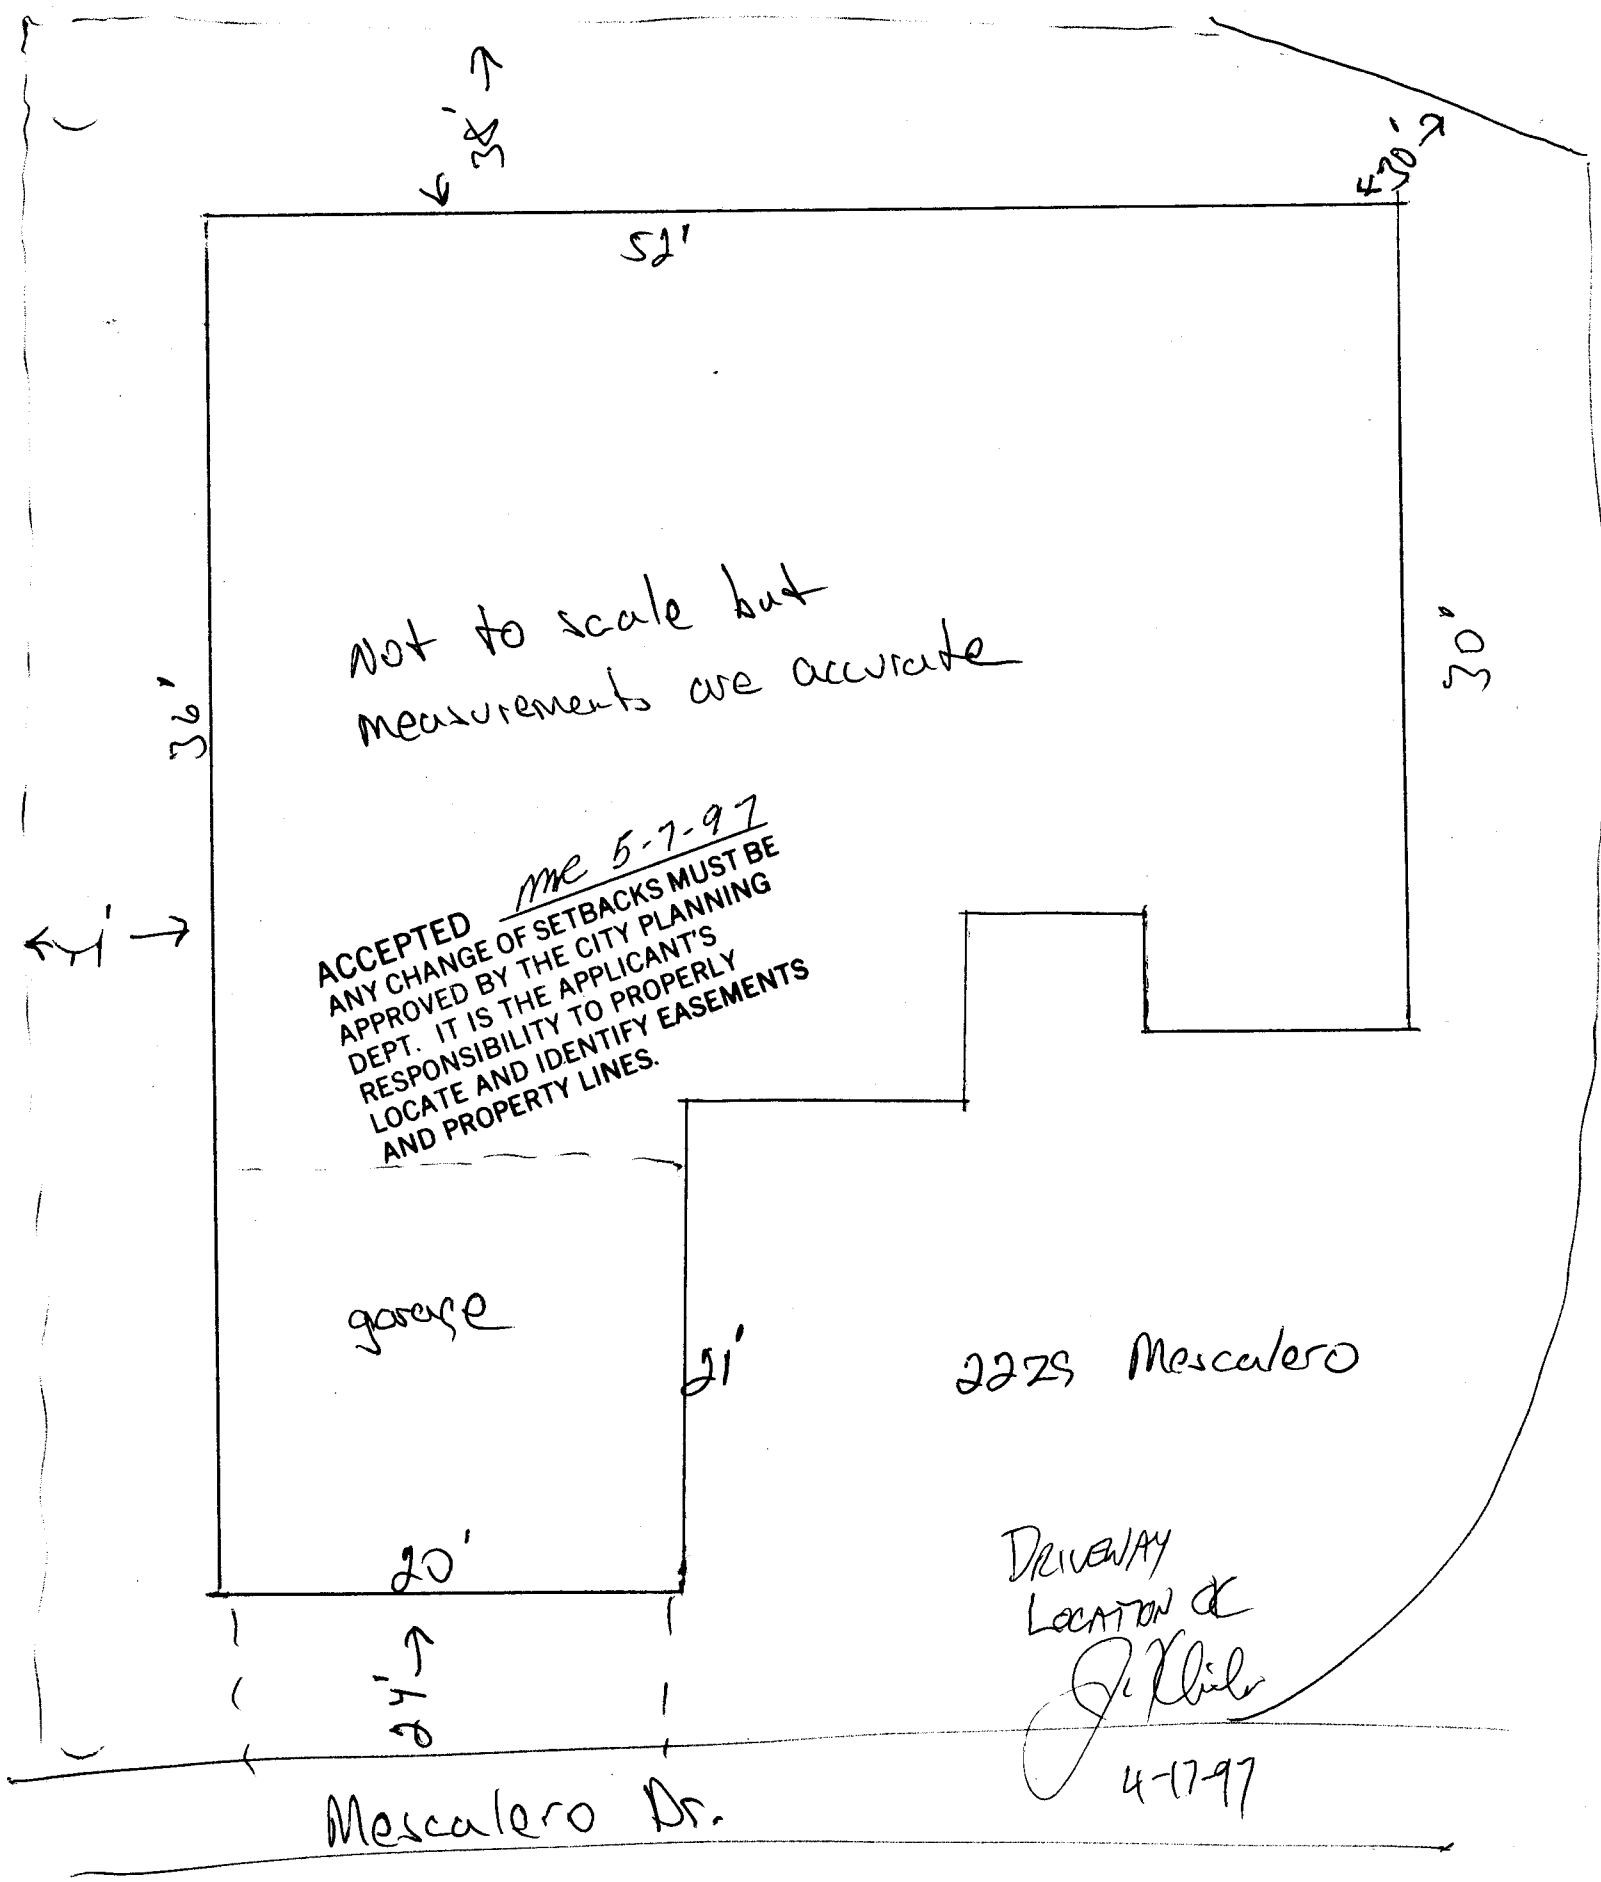

not to scale but
measurements are accurate

ACCEPTED *me 5-7-97*
ANY CHANGE OF SETBACKS MUST BE
APPROVED BY THE CITY PLANNING
DEPT. IT IS THE APPLICANT'S
RESPONSIBILITY TO PROPERLY
LOCATE AND IDENTIFY EASEMENTS
AND PROPERTY LINES.

garage

2229 Mescalero

DRIVEWAY
LOCATION &
J. K. Kibler
4-17-97

Mescalero Dr.