

FEE \$	10 ⁰⁰
TCP \$	0
SIF \$	0



BLDG PERMIT NO. 62835

PLANNING CLEARANCE
(Single Family Residential and Accessory Structures)
Community Development Department

BLDG ADDRESS 725 Pacific Dr. TAX SCHEDULE NO. 2701-354-27-005

SUBDIVISION Bela Vista SQ. FT. OF PROPOSED BLDG(S)/ADDITION 624[#]

FILING ^{1st add.} BLK 1 LOT 5 SQ. FT. OF EXISTING BLDG(S) 1875[#]

(1) OWNER W.E. Williams NO. OF DWELLING UNITS
BEFORE: 1 AFTER: 1 THIS CONSTRUCTION

(1) ADDRESS 725 Pacific Dr. NO. OF BLDGS ON PARCEL
BEFORE: 2 AFTER: 2 THIS CONSTRUCTION

(1) TELEPHONE 245-4339 USE OF EXISTING BLDGS Home/Shed

(2) APPLICANT Same DESCRIPTION OF WORK AND INTENDED USE: Remove existing Deck & carport - 12x24

(2) ADDRESS _____ Add 26x24 addition

(2) TELEPHONE _____

REQUIRED: One plot plan, on 8 1/2" x 11" paper, showing all existing & proposed structure location(s), parking, setbacks to all property lines, ingress/egress to the property, driveway location & width & all easements & rights-of-way which abut the parcel.

THIS SECTION TO BE COMPLETED BY COMMUNITY DEVELOPMENT DEPARTMENT STAFF

ZONE RSF-2 Maximum coverage of lot by structures 2570

SETBACKS: Front 20' from property line (PL) Parking Req'mt 2
or 45' from center of ROW, whichever is greater

Side 15' from PL Rear 30' from PL Special Conditions _____

Maximum Height 32' CENSUS 10 TRAFFIC 17 ANN# _____

Modifications to this Planning Clearance must be approved, in writing, by the Director of the Community Development Department. The structure authorized by this application cannot be occupied until a final inspection has been completed and a Certificate of Occupancy has been issued by the Building Department (Section 305, Uniform Building Code).

I hereby acknowledge that I have read this application and the information is correct; I agree to comply with any and all codes, ordinances, laws, regulations or restrictions which apply to the project. I understand that failure to comply shall result in legal action, which may include but not necessarily be limited to non-use of the building(s).

Applicant Signature W.E. Williams Date 11-07-97

Department Approval Santa J. Castello Date 11-7-97


Additional water and/or sewer tap fee(s) are required: YES _____ NO W/O No. FR-82872

Utility Accounting Chickie Dow Date 11-7-97

VALID FOR SIX MONTHS FROM DATE OF ISSUANCE (Section 9-3-2C Grand Junction Zoning & Development Code)

(White: Planning) (Yellow: Customer) (Pink: Building Department) (Goldenrod: Utility Accounting)

589° 55' E 190.0

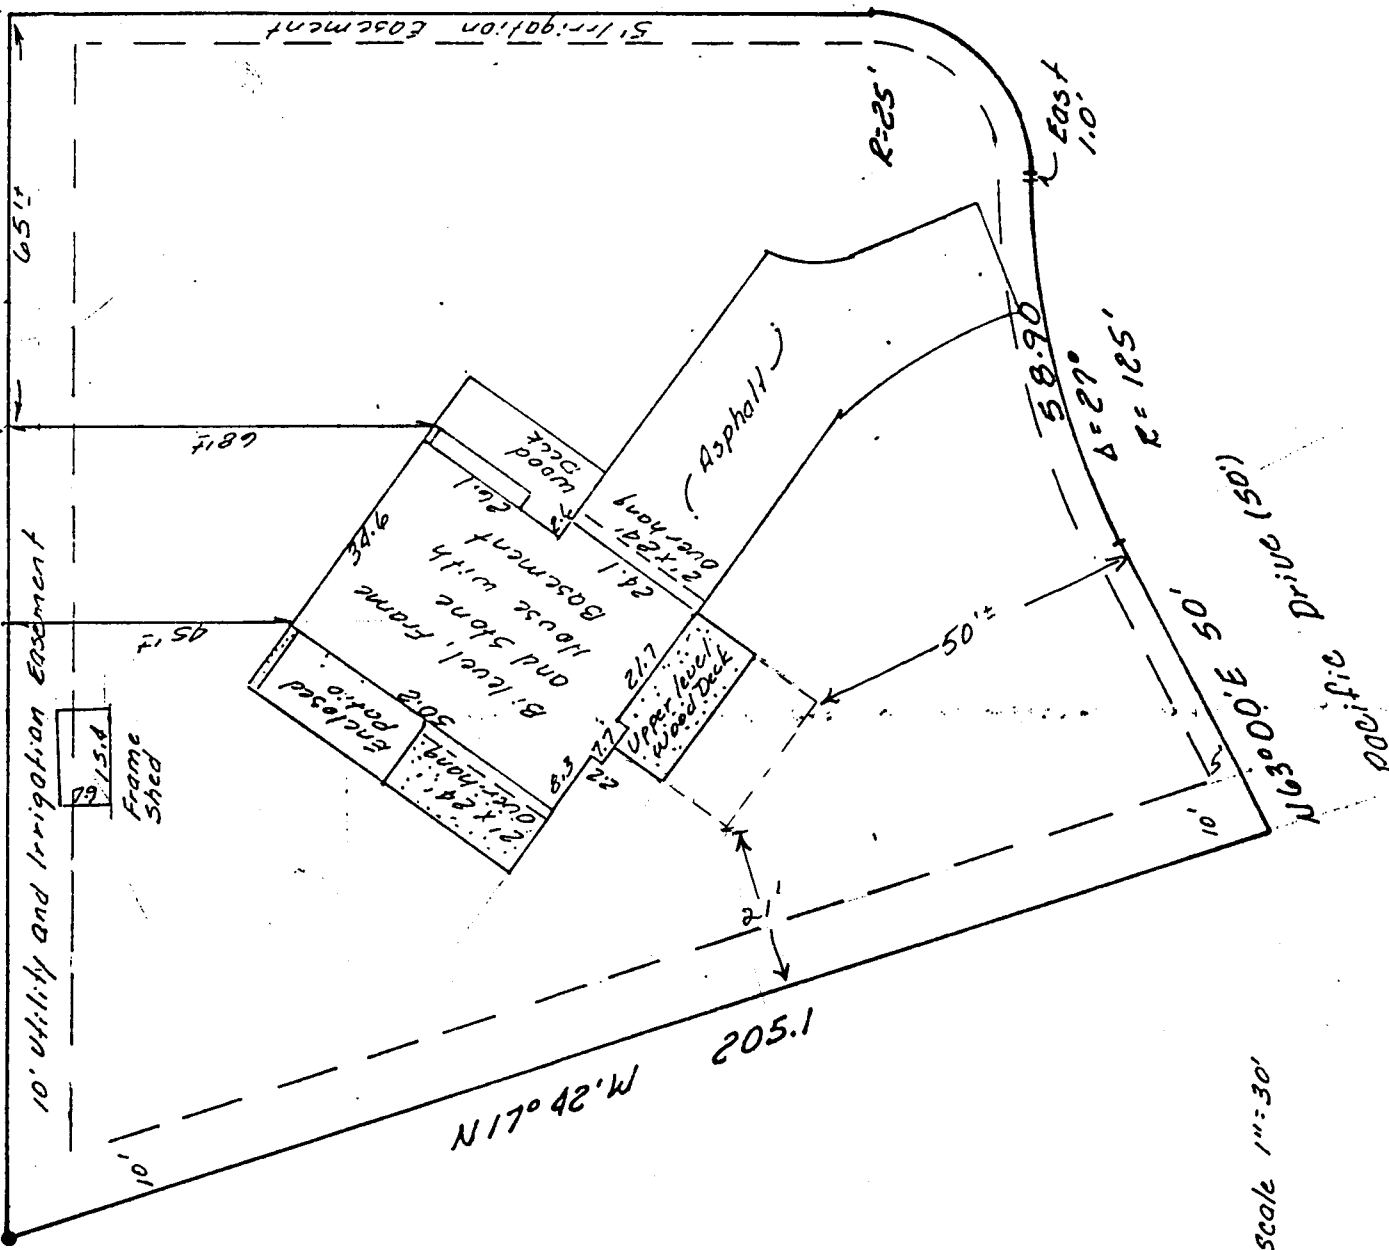

27 Road
500° 07' W 133.8

Found
5/8" Rebar

ACCEPTED SLC 11.7.97
 ANY CHANGE OF SETBACKS MUST BE APPROVED BY THE CITY PLANNING DEPT. IT IS THE APPLICANT'S RESPONSIBILITY TO PROPERLY LOCATE AND IDENTIFY EASEMENTS AND PROPERTY LINES.



Scale 1" = 30'