

FEE \$	10 <sup>-</sup>
TCP \$	4
SIF \$	292 <sup>-</sup>



BLDG PERMIT NO. 60936

**PLANNING CLEARANCE**  
(Single Family Residential and Accessory Structures)  
**Community Development Department**

BLDG ADDRESS 336 Sienns CT TAX SCHEDULE NO. 2947 35117001  
 SUBDIVISION Canyon View SQ. FT. OF PROPOSED BLDG(S)/ADDITION 2370  
 FILING 5 BLK 2 LOT 6 SQ. FT. OF EXISTING BLDG(S) N/A  
 (1) OWNER DAVID BAGG NO. OF DWELLING UNITS BEFORE: 0 AFTER: 1 THIS CONSTRUCTION  
 (1) ADDRESS 371 Lime Kiln NO. OF BLDGS ON PARCEL BEFORE: 0 AFTER: 1 THIS CONSTRUCTION  
 (1) TELEPHONE 241-2734 USE OF EXISTING BLDGS no  
 (2) APPLICANT \_\_\_\_\_ DESCRIPTION OF WORK AND INTENDED USE: \_\_\_\_\_  
 (2) ADDRESS Same \_\_\_\_\_  
 (2) TELEPHONE \_\_\_\_\_ New Res

**REQUIRED: One plot plan, on 8 1/2" x 11" paper, showing all existing & proposed structure location(s), parking, setbacks to all property lines, ingress/egress to the property, driveway location & width & all easements & rights-of-way which abut the parcel.**

**THIS SECTION TO BE COMPLETED BY COMMUNITY DEVELOPMENT DEPARTMENT STAFF**

ZONE PR-2 Maximum coverage of lot by structures \_\_\_\_\_  
 SETBACKS: Front 35' from property line (PL) Parking Req'mt \_\_\_\_\_  
 or \_\_\_\_\_ from center of ROW, whichever is greater  
 Side 15' from PL Rear 25' from PL Special Conditions \_\_\_\_\_  
 Maximum Height \_\_\_\_\_  
 CENSUS 1401 TRAFFIC 64 ANN# \_\_\_\_\_

Modifications to this Planning Clearance must be approved, in writing, by the Director of the Community Development Department. The structure authorized by this application cannot be occupied until a final inspection has been completed and a Certificate of Occupancy has been issued by the Building Department (Section 305, Uniform Building Code).

I hereby acknowledge that I have read this application and the information is correct; I agree to comply with any and all codes, ordinances, laws, regulations or restrictions which apply to the project. I understand that failure to comply shall result in legal action, which may include but not necessarily be limited to non-use of the building(s).

Applicant Signature [Signature] Date 6-23-97  
 Department Approval [Signature] Date 6-24-97

Additional water and/or sewer tap fee(s) are required: YES  NO \_\_\_\_\_ W/O No. #10303  
 Utility Accounting [Signature] Date 6-24-97

VALID FOR SIX MONTHS FROM DATE OF ISSUANCE (Section 9-3-2C Grand Junction Zoning & Development Code)

(White: Planning) (Yellow: Customer) (Pink: Building Department) (Goldenrod: Utility Accounting)


Canyon View Sub

Lot 6  
Blk 2  
Filing 5  
3' 9 1/2"

(25' Drainage  
Easement) 3' 5 1/2"

196.34

ACCEPTED *Ronnie* 6/24/97  
ANY CHANGE OF SETBACKS MUST BE  
APPROVED BY THE CITY PLANNING  
DEPT. IT IS THE APPLICANT'S  
RESPONSIBILITY TO PROPERLY  
LOCATE AND IDENTIFY EASEMENTS  
AND PROPERTY LINES.

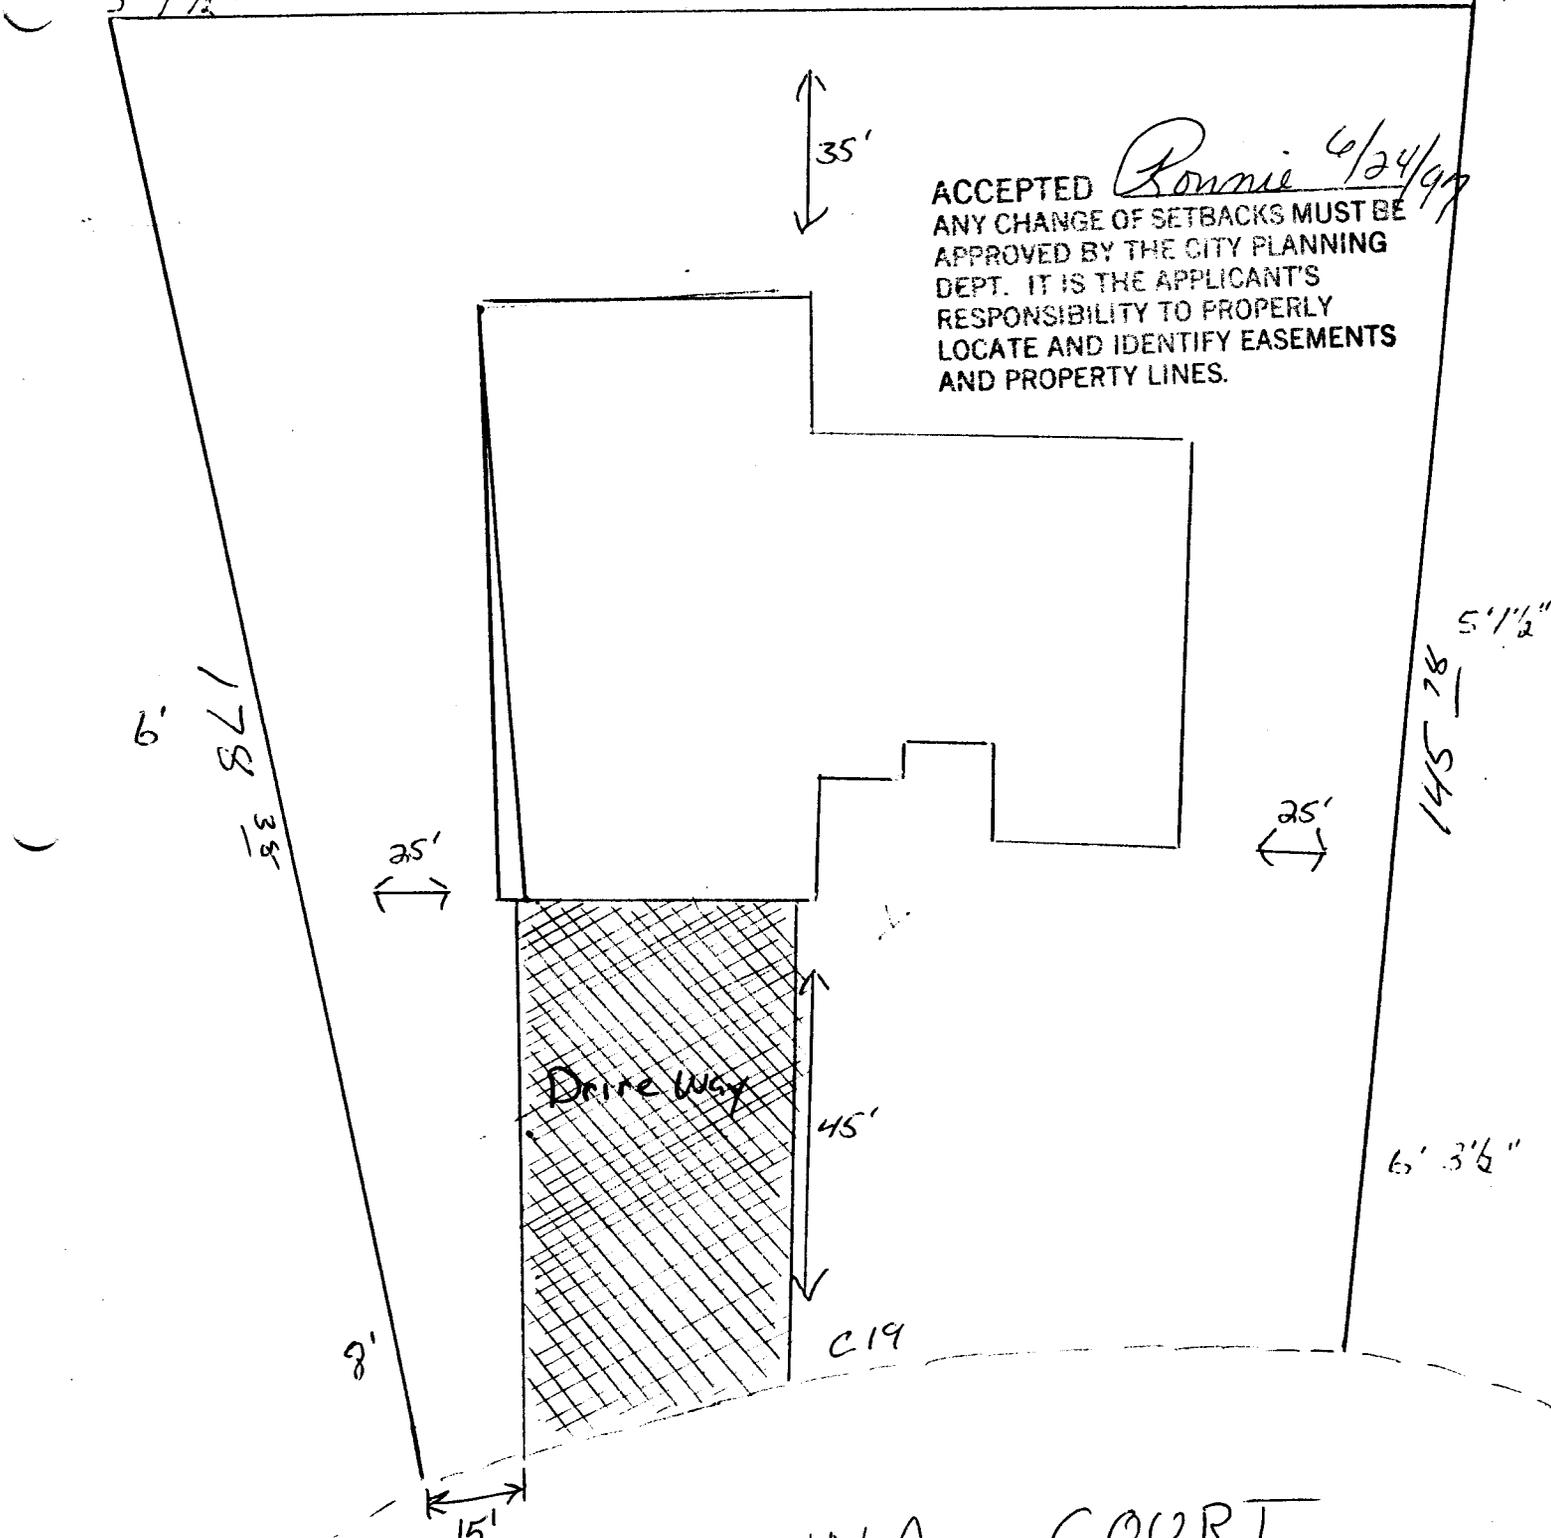

SIENNA COURT

DRIVENWAY LOCATED O.K.  
*W Ashbeck* 6/24/97

B & B Construction  
371 Lime Kiln Way  
Grand Junction, CO 81503