




TYPICAL

ACCEPTED *Ronnie* 5/14/97

ANY CHANGE OF SETBACKS MUST BE APPROVED BY THE CITY PLANNING DEPT. IT IS THE APPLICANT'S RESPONSIBILITY TO PROPERLY LOCATE AND IDENTIFY EASEMENTS AND PROPERTY LINES.

SITE PLAN

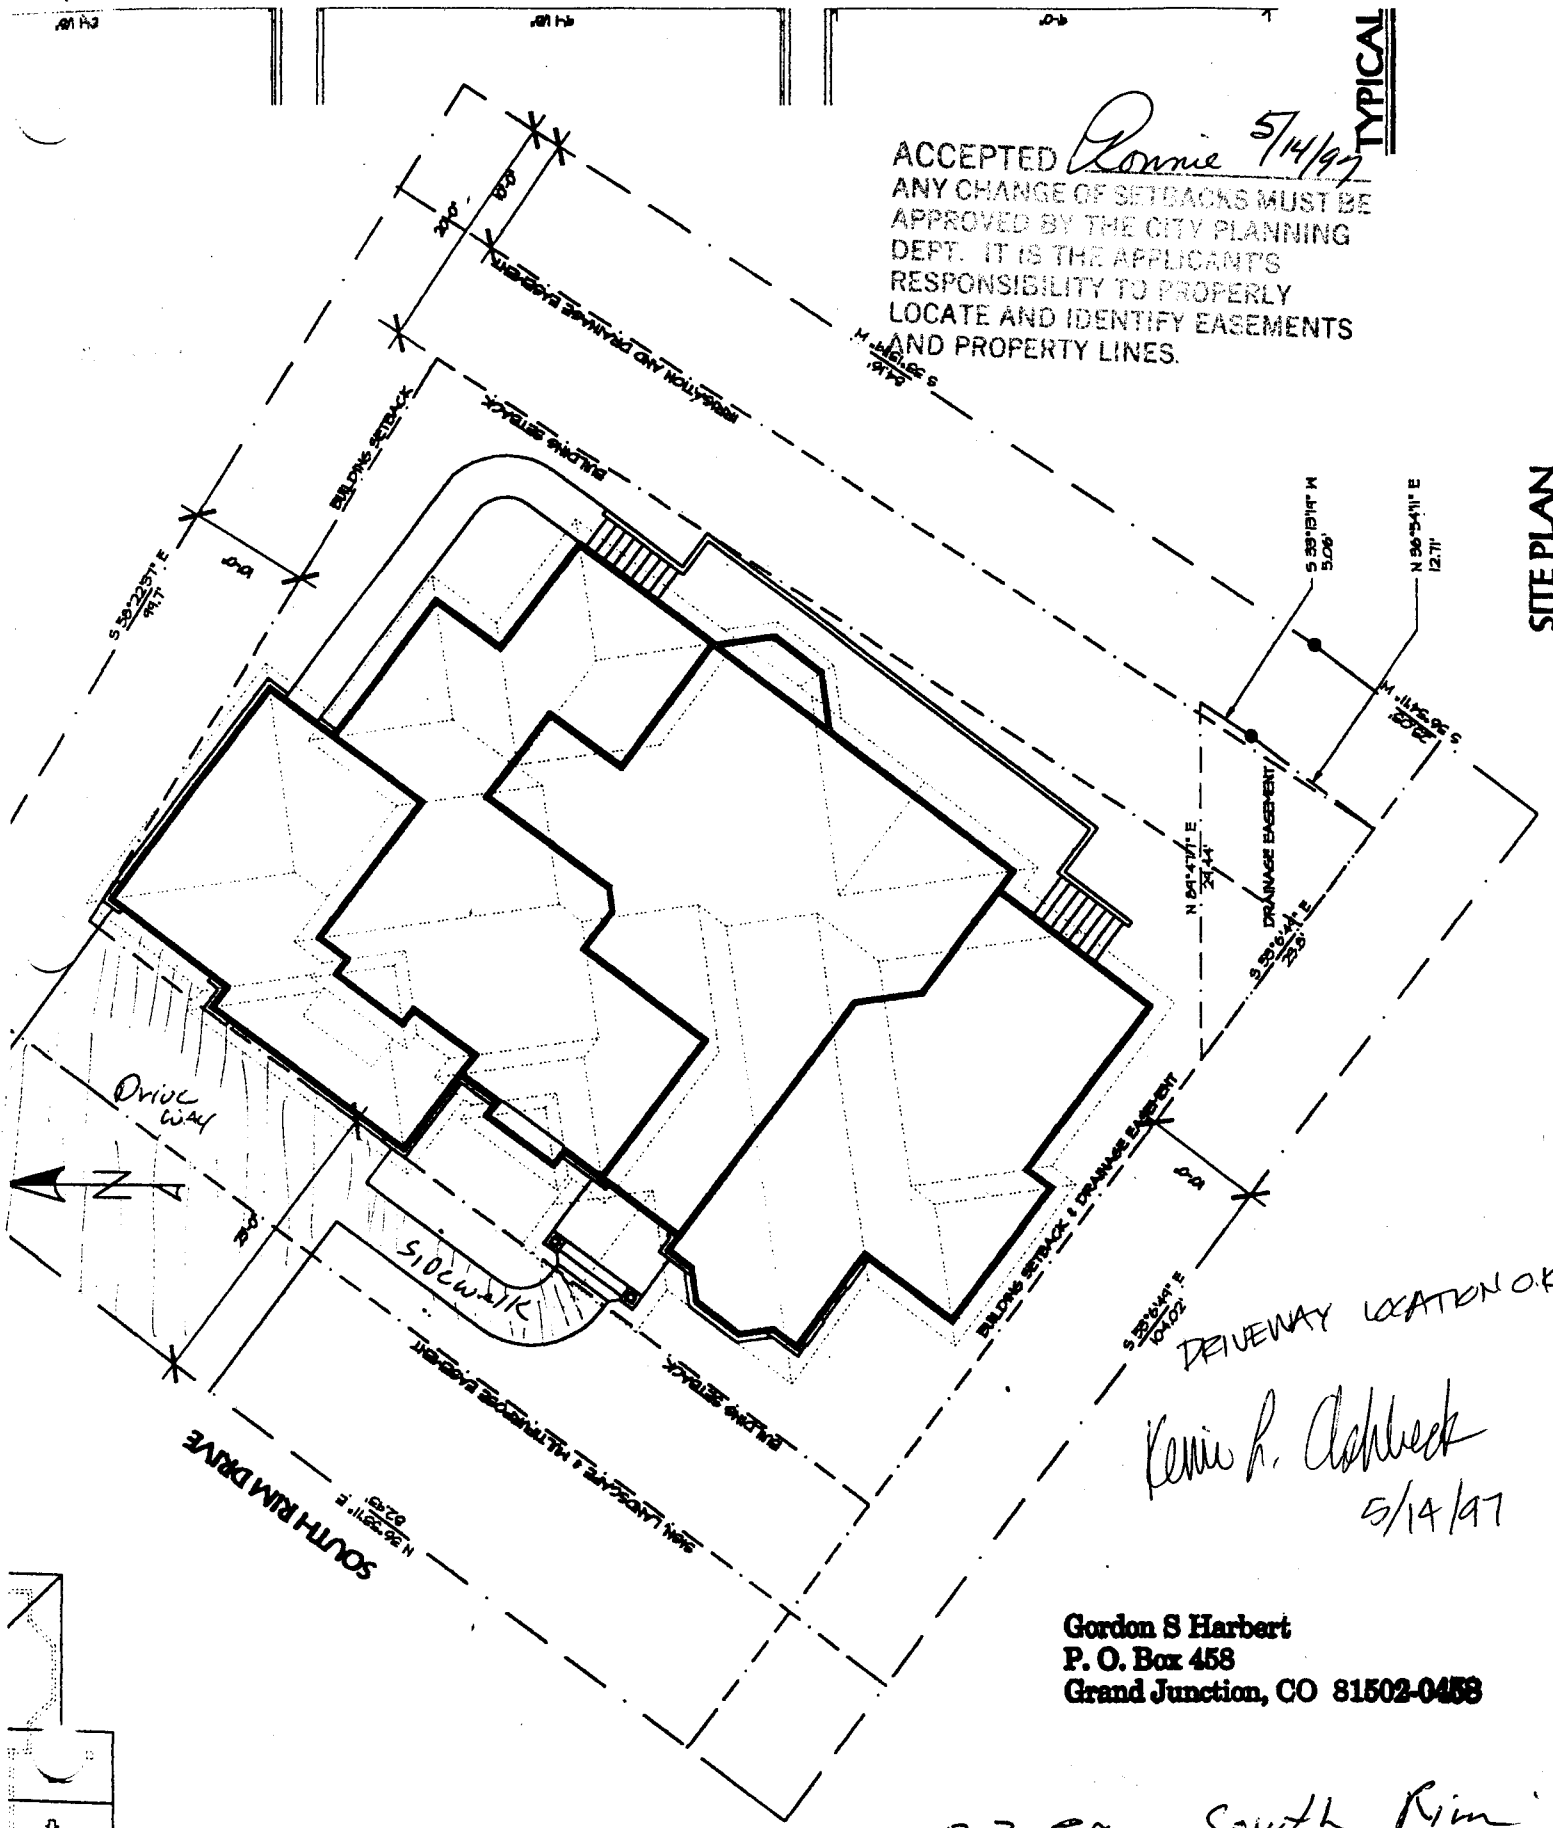

*DRIVEWAY LOCATION OK*  
*Kennie R. Ashbeck*  
5/14/97

**Gordon S Harbert**  
P. O. Box 458  
Grand Junction, CO 81502-0458

2359 South Rim Drive  
Lot 10 Block 3 Filings B

PLAN  
1/8" = 1'-0"