FEE \$	10 -
TCP \$	
SIF \$	292,-




BLDG PERMIT NO. 655 15

PLANNING CLEARANCE

(Single Family Residential and Accessory Structures)

Community Development Department

BLDG ADDRESS 554 Casa Rio C.	TAX SCHEDULE NO. 2945-071-84-003	
SUBDIVISION Lista Del Rio	SQ. FT. OF PROPOSED BLDG(S)/ADDITION	
FILING 3 BLK LOT 3	SQ. FT. OF EXISTING BLDG(S)	
(1) OWNER Darssy Blyd LLC	NO. OF DWELLING UNITS BEFORE: AFTER: THIS CONSTRUCTION	
(1) ADDRESS 690 29/2 Rd,	NO. OF BLDGS ON PARCEL	
(1) TELEPHONE <u>260-6464</u>	BEFORE: AFTER: THIS CONSTRUCTION	
(2) APPLICANT R. Daresey	USE OF EXISTING BLDGS TOURSE 14	
(2) ADDRESS 690 29 12 Rd,	DESCRIPTION OF WORK AND INTENDED USE:	
(2) TELEPHONE 260-6464	Residence	
REQUIRED: One plot plan, on 8 ½" x 11" paper, showing all existing & proposed structure location(s), parking, setbacks to all property lines, ingress/egress to the property, driveway location & width & all easements & rights-of-way which abut the parcel.		
SETBACKS: Front from property line (PL) or from center of ROW, whichever is greater	Special Conditions Lake Lake August	
Side \\ from PL Rear \(\frac{5}{25} \) from F	Invilope	
Maximum Height	CENSUS Y402 IRAFFICO ANNX#	
Modifications to this Planning Clearance must be approved, in writing, by the Director of the Community Development Department. The structure authorized by this application cannot be occupied until a final inspection has been completed and a Certificate of Occupancy has been issued by the Building Department (Section 305, Uniform Building Code).		
I hereby acknowledge that I have read this application and the information is correct; I agree to comply with any and all codes, ordinances, laws, regulations or restrictions which apply to the project. I understand that failure to comply shall result in legal action, which may include but not necessarily be limited to non-use of the building(s).		
Applicant Signature Color L	<u>uusu</u> Date 6/10/98	
Department Approval . Valde	Date 10-10-98	
Additional water and/or sewer tap fee(s) are required: YES V NO W/O No. 854/5		
Utility Accounting Raymond	Date <u>6 10 98</u>	
VALID FOR SIX MONTHS FROM DATE OF ISSUANCE (Section 9-3-2C Grand Junction Zoning & Development Code)		
(White: Planning) (Yellow: Customer) (Pil	nk: Building Department) (Goldenrod: Utility Accounting)	

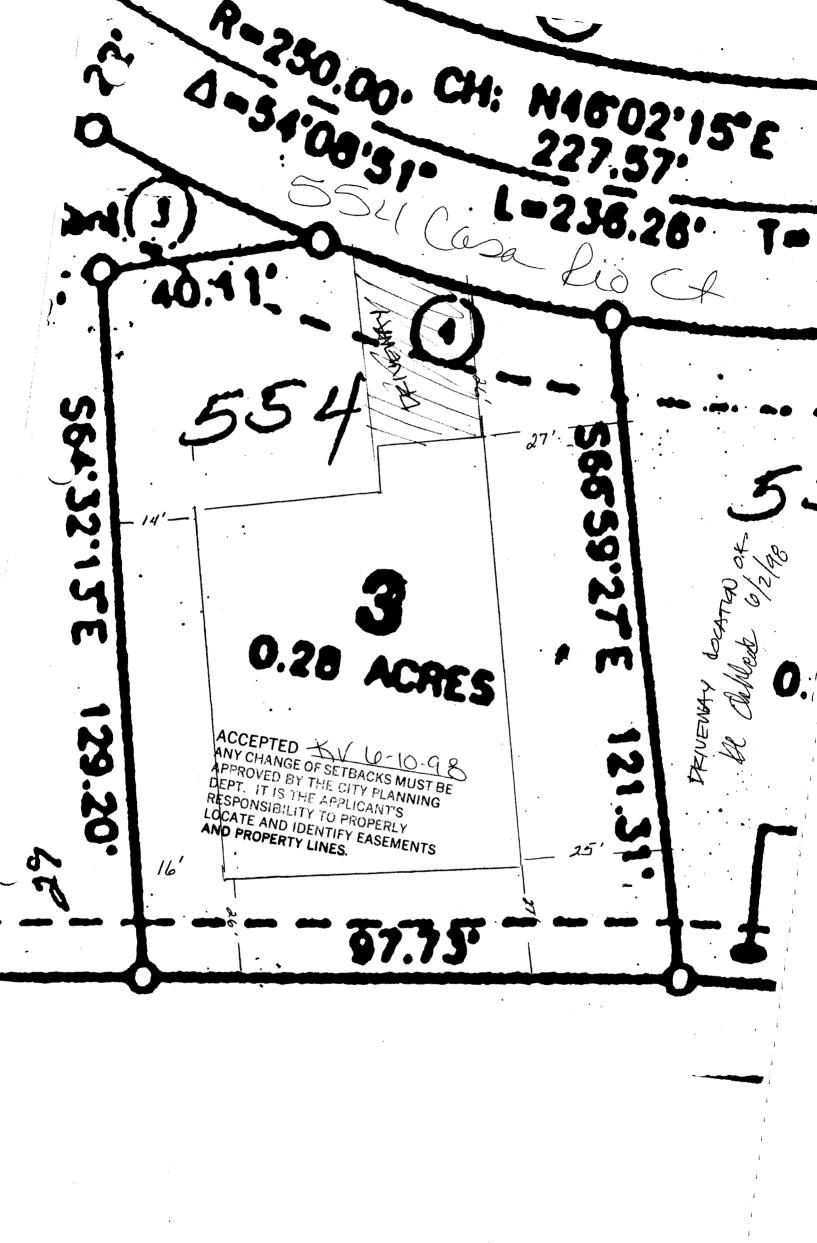

N. 350.00. 146.05.12.E 564:32.12E 5665972 21/00 241 129.20 286