

| | |
|--------|-------------------|
| FEE \$ | 10 ⁰⁰ |
| TCP \$ | 6 |
| SIF \$ | 292 ⁰⁰ |



BLDG PERMIT NO. 66241

PLANNING CLEARANCE

(Single Family Residential and Accessory Structures)

Community Development Department

BLDG ADDRESS 636 Clearwater Ct TAX SCHEDULE NO. 2945-034-50-001
 SUBDIVISION Fall Valley SQ. FT. OF PROPOSED BLDG(S)/ADDITION 1850
 FILING 2 BLK 1 LOT 12 SQ. FT. OF EXISTING BLDG(S) NONE
 (1) OWNER CASTLE HOMES, INC. NO. OF DWELLING UNITS
556 25 ROAD BEFORE: 0 AFTER: 1 THIS CONSTRUCTION
 (1) ADDRESS GRAND JUNCTION, CO 81505
 (1) TELEPHONE 248-9708 NO. OF BLDGS ON PARCEL
 BEFORE: 0 AFTER: 1 THIS CONSTRUCTION
 (2) APPLICANT owner USE OF EXISTING BLDGS NO
 (2) ADDRESS _____ DESCRIPTION OF WORK AND INTENDED USE: _____
 (2) TELEPHONE _____ SFR

REQUIRED: One plot plan, on 8 1/2" x 11" paper, showing all existing & proposed structure location(s), parking, setbacks to all property lines, ingress/egress to the property, driveway location & width & all easements & rights-of-way which abut the parcel.

THIS SECTION TO BE COMPLETED BY COMMUNITY DEVELOPMENT DEPARTMENT STAFF

ZONE PR 2.9 Maximum coverage of lot by structures _____
 SETBACKS: Front Garage 20' 15' from property line (PL) Parking Req'mt 2
 or _____ from center of ROW, whichever is greater Special Conditions _____
 Side 10' from PL Rear 20' from PL
 Maximum Height 32' CENSUS 9 TRAFFIC 19 ANN# _____

Modifications to this Planning Clearance must be approved, in writing, by the Director of the Community Development Department. The structure authorized by this application cannot be occupied until a final inspection has been completed and a Certificate of Occupancy has been issued by the Building Department (Section 305, Uniform Building Code).

I hereby acknowledge that I have read this application and the information is correct; I agree to comply with any and all codes, ordinances, laws, regulations or restrictions which apply to the project. I understand that failure to comply shall result in legal action, which may include but not necessarily be limited to non-use of the building(s).

Applicant Signature Melanie D. Horn Date 8-3-98

Department Approval Shirley J. Castello Date 8-3-98

Additional water and/or sewer tap fee(s) are required: YES NO _____ W/O No. 11489


Utility Accounting R. Raymond Date 8/3/98

VALID FOR SIX MONTHS FROM DATE OF ISSUANCE (Section 9-3-2C Grand Junction Zoning & Development Code)

(White: Planning) (Yellow: Customer) (Pink: Building Department) (Goldenrod: Utility Accounting)

FALL VALLEY SUBDIVISION
BLOCK 1, LOT 12
FILING 2

636
1850 L

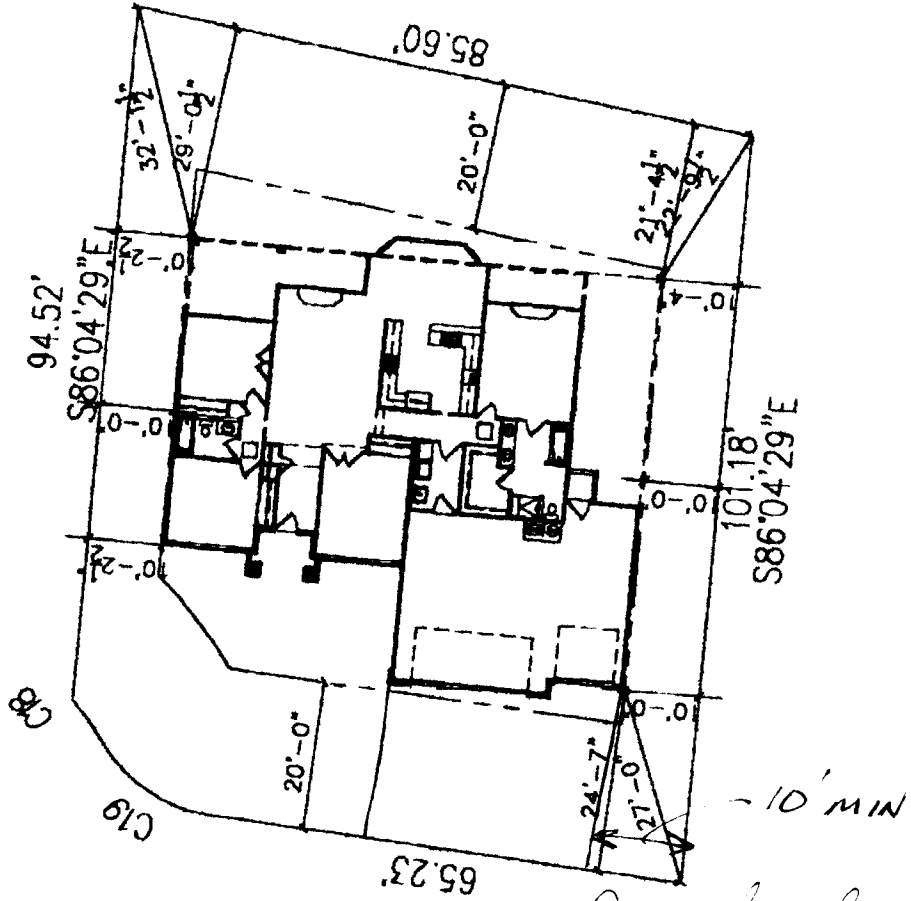

CLEARWATER COURT

Drive location O.K.
Rich Davis
89-62-7
7-29-98

ACCEPTED SIC 8-3-98
ANY CHANGE OF SETBACKS MUST BE APPROVED BY THE CITY PLANNING DEPT. IT IS THE APPLICANT'S RESPONSIBILITY TO PROPERLY LOCATE AND IDENTIFY EASEMENTS AND PROPERTY LINES.

APPROVED

TO THE CITY OF FALL VALLEY, COLORADO