

FEE \$	10 <sup>00</sup>
TCP \$	0
SIF \$	292 <sup>00</sup>



BLDG PERMIT NO. 04463

### PLANNING CLEARANCE

(Single Family Residential and Accessory Structures)

#### Community Development Department

BLDG ADDRESS 2557 FALL VALLEY AVE. TAX SCHEDULE NO. 2945-034-45-002

SUBDIVISION FALL VALLEY SUB. SQ. FT. OF PROPOSED BLDG(S)/ADDITION 1856

FILING 1 BLK 1 LOT 2 SQ. FT. OF EXISTING BLDG(S) —

(1) OWNER CASTLE HOMES, INC. NO. OF DWELLING UNITS  
BEFORE: 0 AFTER: 1 THIS CONSTRUCTION

(1) ADDRESS 556 25 ROAD NO. OF BLDGS ON PARCEL  
BEFORE: — AFTER: — THIS CONSTRUCTION

(1) TELEPHONE 248-9708 USE OF EXISTING BLDGS NO

(2) APPLICANT OWNER DESCRIPTION OF WORK AND INTENDED USE: SFR

(2) ADDRESS \_\_\_\_\_

(2) TELEPHONE \_\_\_\_\_

**REQUIRED: One plot plan, on 8 1/2" x 11" paper, showing all existing & proposed structure location(s), parking, setbacks to all property lines, ingress/egress to the property, driveway location & width & all easements & rights-of-way which abut the parcel.**

**THIS SECTION TO BE COMPLETED BY COMMUNITY DEVELOPMENT DEPARTMENT STAFF**

ZONE PR 2.9 Maximum coverage of lot by structures \_\_\_\_\_

Garage 20'

SETBACKS: Front 15' from property line (PL) Parking Req'mt 2  
or — from center of ROW, whichever is greater

Side 10' from PL Rear 20' from PL Special Conditions \_\_\_\_\_

Maximum Height 32' CENSUS 10 TRAFFIC 19 ANN# \_\_\_\_\_

Modifications to this Planning Clearance must be approved, in writing, by the Director of the Community Development Department. The structure authorized by this application cannot be occupied until a final inspection has been completed and a Certificate of Occupancy has been issued by the Building Department (Section 305, Uniform Building Code).

I hereby acknowledge that I have read this application and the information is correct; I agree to comply with any and all codes, ordinances, laws, regulations or restrictions which apply to the project. I understand that failure to comply shall result in legal action, which may include but not necessarily be limited to non-use of the building(s).

Applicant Signature Melanie D. Koch Date 3-23-98

Department Approval Antonia Costello Date 3-26-98

Additional water and/or sewer tap fee(s) are required: YES  NO  W/O No. 10632

Utility Accounting J. Adams Date 3-26-98

VALID FOR SIX MONTHS FROM DATE OF ISSUANCE (Section 9-3-2C Grand Junction Zoning & Development Code)

(White: Planning) (Yellow: Customer) (Pink: Building Department) (Goldenrod: Utility Accounting)

NO.	REVISIONS
1	
2	
3	
4	
5	
6	
7	


CASTLE HOMES INC. 10101 1/2" = 1'-0" DRAFT



CASTLE HOMES INC. F.V. PLOT PLANS

DATE: 3/24/18  
 DRAWN BY: [Signature]  
 CHECKED BY: [Signature]  
 SCALE: 1/8" = 1'-0"  
 SHEET 1

FALL VALLEY SUBDIVISION  
 BLOCK 1, LOT 2  
 FILING 1

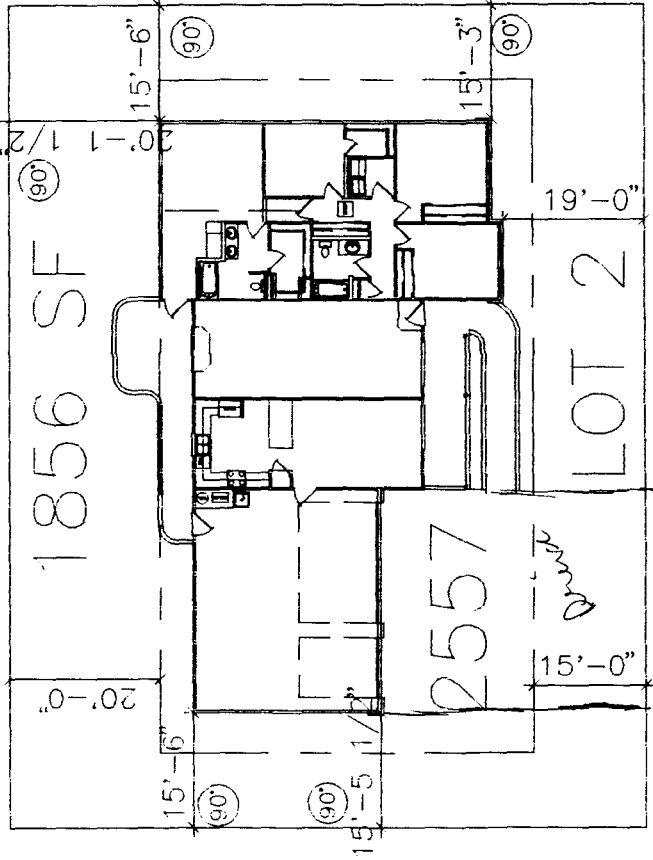

FALL VALLEY AVENUE

APPROVED

NOTE:  
 1. IT IS THE RESPONSIBILITY OF THE BUILDER OR OWNER TO VERIFY DIMENSIONS AND DIMENSIONS PRIOR TO CONSTRUCTION.

ACCEPTED SLC 3.26.98  
 ANY CHANGE OF SETBACKS MUST BE APPROVED BY THE CITY PLANNING DEPT. IT IS THE APPLICANT'S RESPONSIBILITY TO PROPERLY LOCATE AND IDENTIFY EASEMENTS AND PROPERTY LINES.

HAZENAY LOCATION O.K.  
 W. [Signature] 3/24/18

PLOT PLAN  
 SCALE: 1/8" = 1'-0" (EXCEPT WHERE NOTED)