

FEE \$ 10.00
 TCP \$ 0.00
 SIF \$ 292.00



BLDG PERMIT NO. 05080

PLANNING CLEARANCE

(Single Family Residential and Accessory Structures)

Community Development Department

BLDG ADDRESS 654 Grandview Drive TAX SCHEDULE NO. 2943-062-23-605
 SUBDIVISION Grand View SQ. FT. OF PROPOSED BLDG(S)/ADDITION 1900
 FILING 2 BLK 6 LOT 1 SQ. FT. OF EXISTING BLDG(S) None
 (1) OWNER SKELTON CONSTRUCTION NO. OF DWELLING UNITS
 BEFORE: 0 AFTER: 1 THIS CONSTRUCTION
 (1) ADDRESS 706 104 PL.
 (1) TELEPHONE 245-9008 NO. OF BLDGS ON PARCEL
 BEFORE: 0 AFTER: 1 THIS CONSTRUCTION
 (2) APPLICANT SKELTON CONSTRUCTION USE OF EXISTING BLDGS N/A
 (2) ADDRESS 706 104 PL. DESCRIPTION OF WORK AND INTENDED USE:
 (2) TELEPHONE 245-9008 NEW HOME

REQUIRED: One plot plan, on 8 1/2" x 11" paper, showing all existing & proposed structure location(s), parking, setbacks to all property lines, ingress/egress to the property, driveway location & width & all easements & rights-of-way which abut the parcel.

THIS SECTION TO BE COMPLETED BY COMMUNITY DEVELOPMENT DEPARTMENT STAFF

ZONE RSF-5 Maximum coverage of lot by structures 35%
 SETBACKS: Front 20' from property line (PL)
 of 45' from center of ROW, whichever is greater Parking Req'mt _____
 Side 5' from PL Rear 25' from PL Special Conditions _____
 Maximum Height 32' CENSUS 10 TRAFFIC 22 ANN# _____

Modifications to this Planning Clearance must be approved, in writing, by the Director of the Community Development Department. The structure authorized by this application cannot be occupied until a final inspection has been completed and a Certificate of Occupancy has been issued by the Building Department (Section 305, Uniform Building Code).

I hereby acknowledge that I have read this application and the information is correct; I agree to comply with any and all codes, ordinances, laws, regulations or restrictions which apply to the project. I understand that failure to comply shall result in legal action, which may include but not necessarily be limited to non-use of the building(s).

Applicant Signature [Signature] Date 5/4/98
 Department Approval [Signature] Date 5-7-98

Additional water and/or sewer tap fee(s) are required: YES NO _____ W/O No. 11275
 Utility Accounting [Signature] Date 5/12/98

VALID FOR SIX MONTHS FROM DATE OF ISSUANCE (Section 9-3-2C Grand Junction Zoning & Development Code)

(White: Planning) (Yellow: Customer) (Pink: Building Department) (Goldenrod: Utility Accounting)

FEE \$ 10.00
 TCP \$ 0
 SIF \$ 292.00



BLDG PERMIT NO. U5080

PLANNING CLEARANCE

(Single Family Residential and Accessory Structures)
Community Development Department

BLDG ADDRESS 654 Grand View Drive TAX SCHEDULE NO. 2943-062-33-005
 SUBDIVISION Grand View SQ. FT. OF PROPOSED BLDG(S)/ADDITION 1900
 FILING 2 BLK 6 LOT 1 SQ. FT. OF EXISTING BLDG(S) None
 (1) OWNER SKELTON CONSTRUCTION NO. OF DWELLING UNITS
 BEFORE: 0 AFTER: 1 THIS CONSTRUCTION
 (1) ADDRESS 706 104 PL.
 (1) TELEPHONE 245-9008 NO. OF BLDGS ON PARCEL
 BEFORE: 0 AFTER: 1 THIS CONSTRUCTION
 (2) APPLICANT SKELTON CONSTRUCTION USE OF EXISTING BLDGS N/A
 (2) ADDRESS 706 104 PL DESCRIPTION OF WORK AND INTENDED USE:
 (2) TELEPHONE 245-9008 NEW HOME

REQUIRED: One plot plan, on 8 1/2" x 11" paper, showing all existing & proposed structure location(s), parking, setbacks to all property lines, ingress/egress to the property, driveway location & width & all easements & rights-of-way which abut the parcel.

THIS SECTION TO BE COMPLETED BY COMMUNITY DEVELOPMENT DEPARTMENT STAFF

ZONE RSF-5 Maximum coverage of lot by structures 35%
 SETBACKS: Front 20' from property line (PL) Parking Req'mt _____
 of 45' from center of ROW, whichever is greater Special Conditions _____
 Side 5' from PL Rear 25' from PL
 Maximum Height 32'
 CENSUS 10 TRAFFIC 22 ANN# _____

Modifications to this Planning Clearance must be approved, in writing, by the Director of the Community Development Department. The structure authorized by this application cannot be occupied until a final inspection has been completed and a Certificate of Occupancy has been issued by the Building Department (Section 305, Uniform Building Code).

I hereby acknowledge that I have read this application and the information is correct; I agree to comply with any and all codes, ordinances, laws, regulations or restrictions which apply to the project. I understand that failure to comply shall result in legal action, which may include but not necessarily be limited to non-use of the building(s).


Applicant Signature [Signature] Date 5/4/98
 Department Approval [Signature] Date 5-7-98

Additional water and/or sewer tap fee(s) are required: YES NO _____ W/O No. 11275
 Utility Accounting [Signature] Date 5/12/98

VALID FOR SIX MONTHS FROM DATE OF ISSUANCE (Section 9-3-2C Grand Junction Zoning & Development Code)

(White: Planning) (Yellow: Customer) (Pink: Building Department) (Goldenrod: Utility Accounting)

ACCEPTED SLC 5-7-98
ANY CHANGE OF SETBACKS MUST BE
APPROVED BY THE CITY PLANNING
DEPT. IT IS THE APPLICANT'S
RESPONSIBILITY TO PROPERLY
LOCATE AND IDENTIFY EASEMENTS
AND PROPERTY LINES.

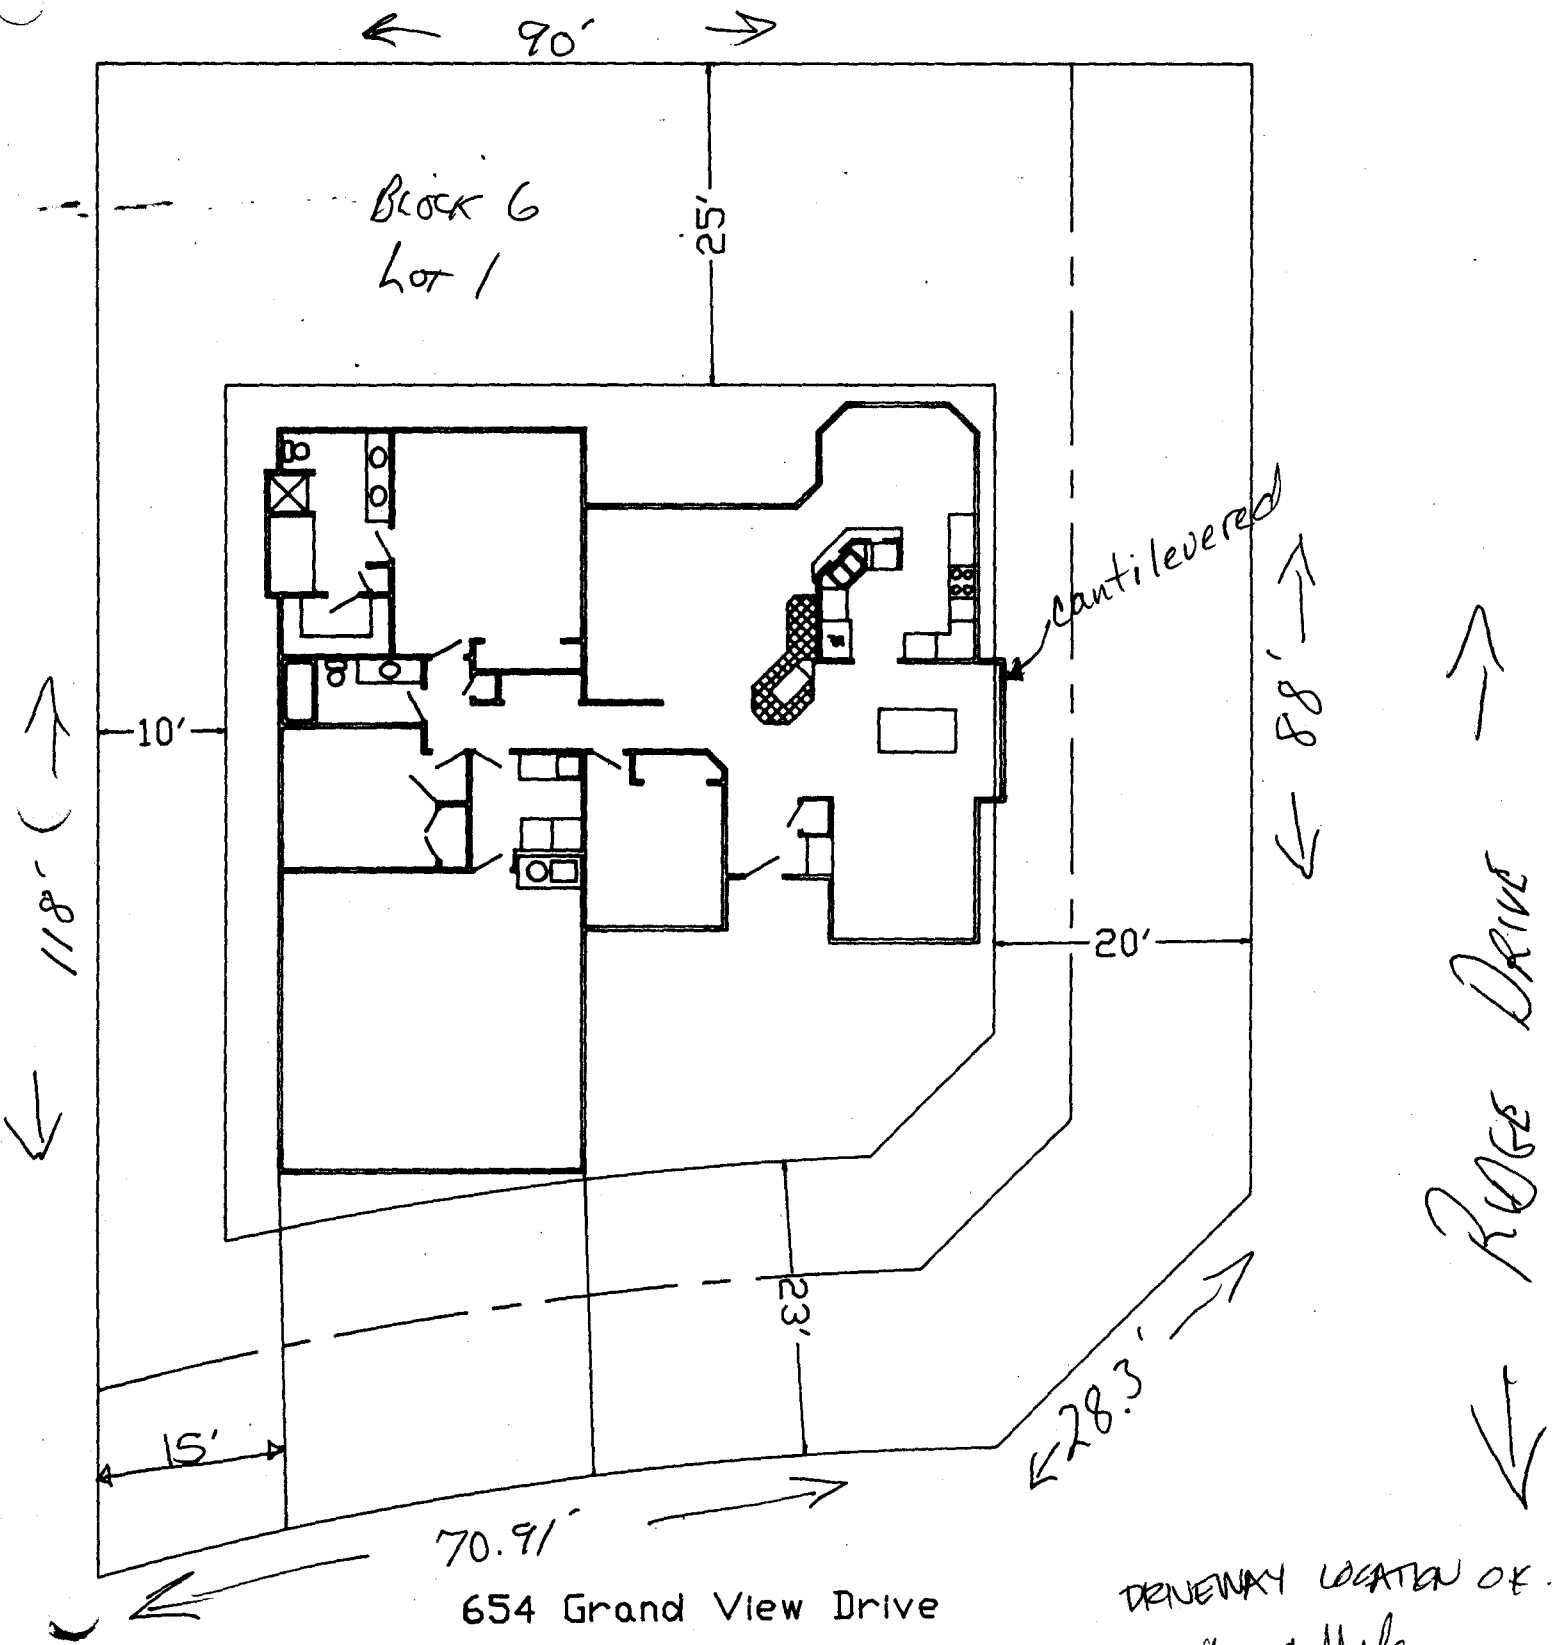

DRAINWAY LOCATION OF
M. Ashlock

5/4/98