

Planning \$ <u>10⁰⁰</u>	Drainage \$ _____
TCP \$ _____	School Impact \$ _____

BLDG PERMIT NO <u>666309</u>
FILE # _____

PLANNING CLEARANCE

(site plan review, multi-family development, non-residential development)
Grand Junction Community Development Department

\$ - 4 places

** THIS SECTION TO BE COMPLETED BY APPLICANT **

BLDG ADDRESS 474, 476, 478, 480 Haines Rd TAX SCHEDULE NO. 2743-181-00-000, 030, 018, 019

SUBDIVISION _____ SQ. FT. OF PROPOSED BLDG(S)/ADDITION ---0---

FILING _____ BLK _____ LOT _____ SQ. FT. OF EXISTING BLDG(S) ---0---

(1) OWNER Grand Junction Pipe & Supply Co. NO. OF DWELLING UNITS
 BEFORE ---0--- AFTER ---0--- CONSTRUCTION

(1) ADDRESS P.O. Box 1849

(1) TELEPHONE 243-4004 NO. OF BLDGS ON PARCEL
 BEFORE ---0--- AFTER ---0--- CONSTRUCTION

(2) APPLICANT Grand Junction Pipe & Supply Co. USE OF ALL EXISTING BLDGS _____

(2) ADDRESS P.O. Box 1849 DESCRIPTION OF WORK & INTENDED USE: _____

(2) TELEPHONE 243-4004 9' High Wall

✓ Submittal requirements are outlined in the SSID (Submittal Standards for Improvements and Development) document.

** THIS SECTION TO BE COMPLETED BY COMMUNITY DEVELOPMENT DEPARTMENT STAFF **

ZONE I-2 Landscaping / Screening Required YES _____ NO _____

SETBACKS: Front _____ from Property Line (PL) or _____ from center of ROW, whichever is greater Parking Req'mt _____

Side _____ from PL Rear _____ from PL Special Conditions: 5' inside property line

Maximum Height _____

Maximum coverage of lot by structures _____ Genus Tract 7 Traffic Zone 99 Annx # _____

Modifications to this Planning Clearance must be approved, in writing, by the Community Development Department Director. The structure authorized by this application cannot be occupied until a final inspection has been completed and a Certificate of Occupancy has been issued by the Building Department (Section 307, Uniform Building Code). Required improvements in the public right-of-way must be guaranteed prior to issuance of a Planning Clearance. All other required site improvements must be completed or guaranteed prior to issuance of a Certificate of Occupancy. Any landscaping required by this permit shall be maintained in an acceptable and healthy condition. The replacement of any vegetation materials that die or are in an unhealthy condition is required by the G.J. Zoning and Development Code.

Four (4) sets of final construction drawings must be submitted and stamped by City Engineering prior to issuing the Planning Clearance. One stamped set must be available on the job site at all times.

I hereby acknowledge that I have read this application and the information is correct; I agree to comply with any and all codes, ordinances, laws, regulations, or restrictions which apply to the project. I understand that failure to comply shall result in legal action, which may include but not necessarily be limited to non-use of the building(s).

Applicant's Signature [Signature] Date 3-4-98


Department Approval [Signature] Date 3-4-98

Additional water and/or sewer tap fee(s) are required: YES _____ NO W/O No. _____

Utility Accounting [Signature] Date 3-4-98


VALID FOR SIX MONTHS FROM DATE OF ISSUANCE (Section 9-3-2C Grand Junction Zoning & Development Code)

(White: Planning) (Yellow: Customer) (Pink: Building Department) (Goldenrod: Utility Accounting)

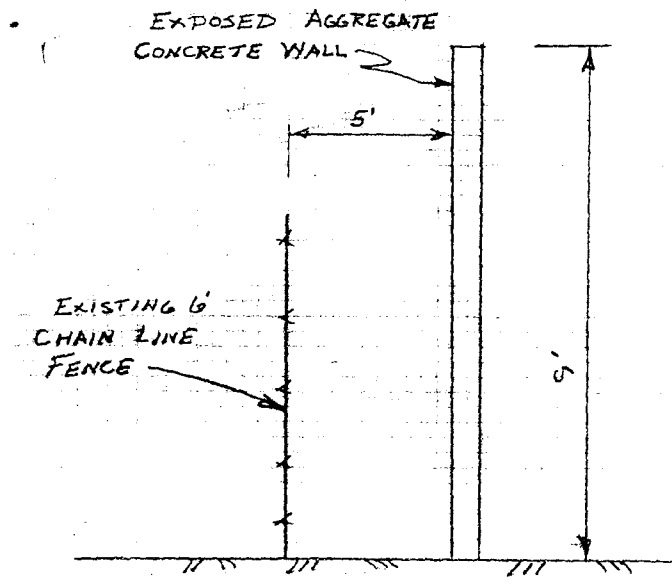


SECTION A-A

GJ PIPE

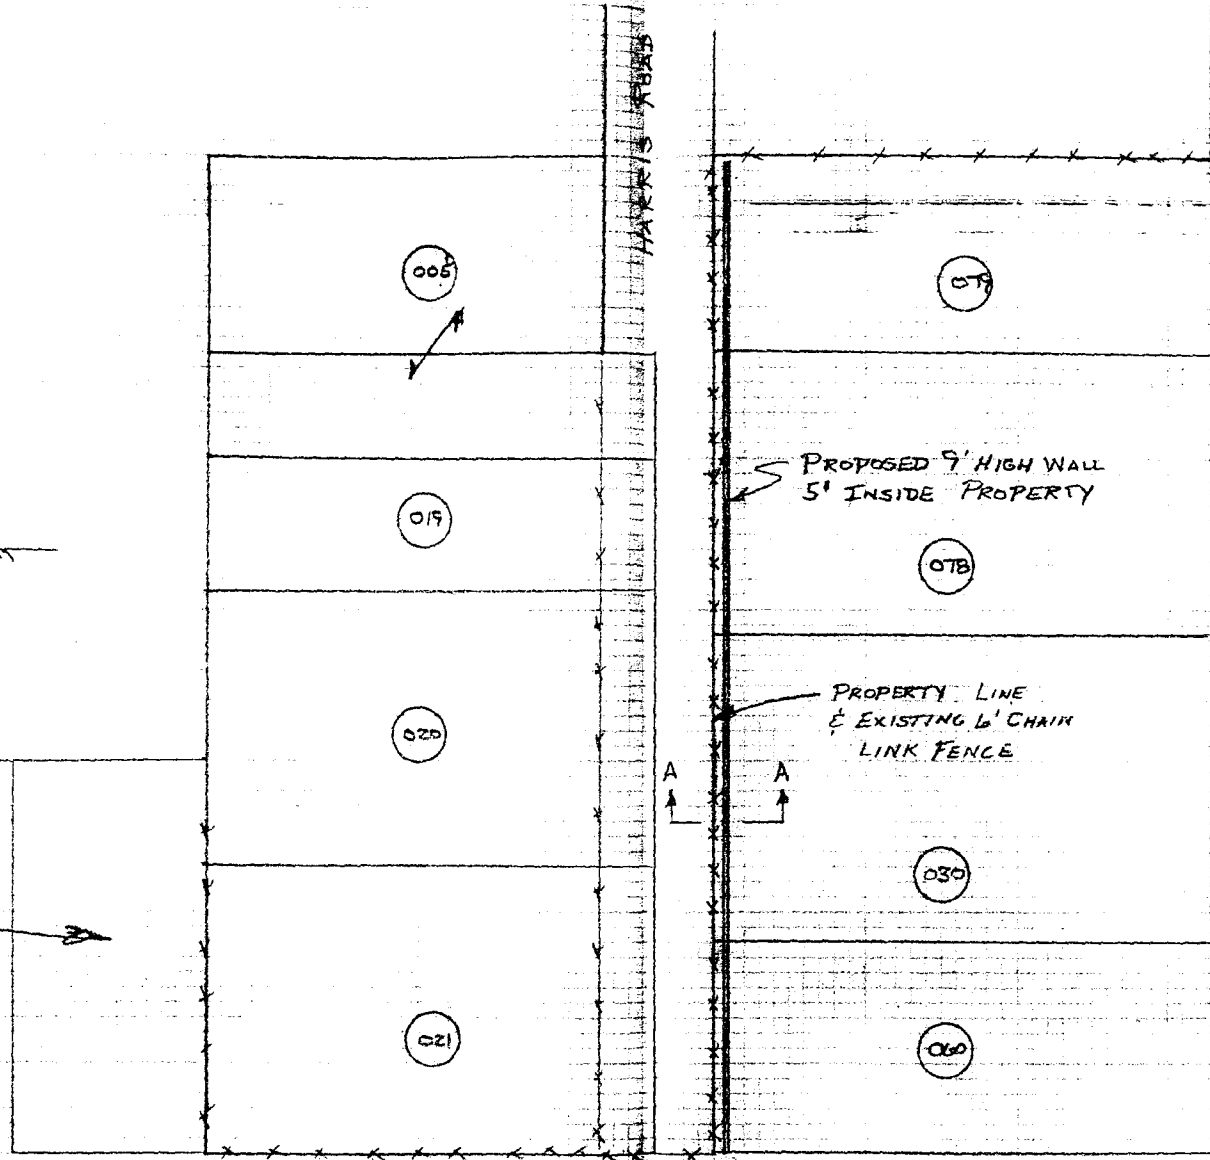

GUNNISON AVE

GJ PIPE

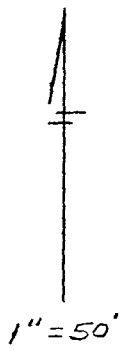

GJ PIPE

ACCEPTED SL 3-4-98
 ANY CHANGE OF SETBACKS MUST BE APPROVED BY THE CITY PLANNING DEPT. IT IS THE APPLICANT'S RESPONSIBILITY TO PROPERLY LOCATE AND IDENTIFY EASEMENTS AND PROPERTY LINES.

VARIANCE REQUEST
 for
 9' HIGH WALL
 GRAND JUNCTION PIPE & SUPPLY CO.
 2868 I-708

2-6-98