

Planning \$ <u>10</u>	Drainage \$ _____
TCP \$ _____	School Impact \$ _____

BLDG PERMIT NO. <u>W025</u>
FILE # _____

PLANNING CLEARANCE

(site plan review, multi-family development, non-residential development)
Grand Junction Community Development Department

** THIS SECTION TO BE COMPLETED BY APPLICANT **

BLDG ADDRESS <u>2175 HRD</u>	TAX SCHEDULE NO. <u>2007-361-00-003</u>
SUBDIVISION _____	SQ. FT. OF PROPOSED BLDG(S)/ADDITION <u>1500.00</u>
FILING _____ BLK _____ LOT _____	SQ. FT. OF EXISTING BLDG(S) <u>5000.00</u>
(1) OWNER <u>Richard Spangler</u>	NO. OF DWELLING UNITS BEFORE: <u>1</u> AFTER: <u>1</u> CONSTRUCTION
(1) ADDRESS <u>2175 HRD</u>	NO. OF BLDGS ON PARCEL BEFORE: <u>2</u> AFTER: <u>3</u> CONSTRUCTION
(1) TELEPHONE <u>970 245 4556</u>	USE OF ALL EXISTING BLDGS <u>Repair House-Residence</u>
(2) APPLICANT <u>Richard Spangler</u>	DESCRIPTION OF WORK & INTENDED USE: <u>open</u>
(2) ADDRESS <u>2175 HRD</u>	<u>Storage</u>
(2) TELEPHONE <u>245 4556</u>	

Submittal requirements are outlined in the SSID (Submittal Standards for Improvements and Development) document.

** THIS SECTION TO BE COMPLETED BY COMMUNITY DEVELOPMENT DEPARTMENT STAFF **

ZONE <u>I-1</u>	Landscaping / Screening Required: YES _____ NO <u>X</u>
SETBACKS: Front _____ from Property Line (PL) or <u>35'</u> from center of ROW, whichever is greater	Parking Req'mt <u>NONE</u>
Side <u>0'</u> from PL Rear <u>0'</u> from PL	Special Conditions: <u>NONE</u>
Maximum Height <u>105'</u>	
Maximum coverage of lot by structures _____	Census Tract <u>15</u> Traffic Zone <u>1</u> Annx # _____

Modifications to this Planning Clearance must be approved, in writing, by the Community Development Department Director. The structure authorized by this application cannot be occupied until a final inspection has been completed and a Certificate of Occupancy has been issued by the Building Department (Section 307, Uniform Building Code). Required improvements in the public right-of-way must be guaranteed prior to issuance of a Planning Clearance. All other required site improvements must be completed or guaranteed prior to issuance of a Certificate of Occupancy. Any landscaping required by this permit shall be maintained in an acceptable and healthy condition. The replacement of any vegetation materials that die or are in an unhealthy condition is required by the G.J. Zoning and Development Code.

Four (4) sets of final construction drawings must be submitted and stamped by City Engineering prior to issuing the Planning Clearance. One stamped set must be available on the job site at all times.

I hereby acknowledge that I have read this application and the information is correct; I agree to comply with any and all codes, ordinances, laws, regulations, or restrictions which apply to the project. I understand that failure to comply shall result in legal action, which may include but not necessarily be limited to non-use of the building(s).

Applicant's Signature <u>Richard Spangler</u>	Date <u>5-9-98</u>
Department Approval <u>[Signature]</u>	Date <u>5-8-98</u>
Additional water and/or sewer tap fee(s) are required: YES _____ NO <u>X</u>	
Utility Accounting <u>[Signature]</u>	Date <u>5-8-98</u>

VALID FOR SIX MONTHS FROM DATE OF ISSUANCE (Section 9-3-2C Grand Junction Zoning & Development Code)


(White: Planning) (Yellow: Customer) (Pink: Building Department) (Goldenrod: Utility Accounting)

SLOPE

Revised 7-9-98
X per KP
X. Valdez

SEED 05'30"E

ACCEPTED ~~PROJ. CR-208~~
ANY CHANGE OF SETBACKS MUST BE APPROVED BY THE CITY PLANNING DEPT. IT IS THE APPLICANT'S RESPONSIBILITY TO PROPERLY LOCATE AND IDENTIFY EASEMENTS AND PROPERTY LINES.

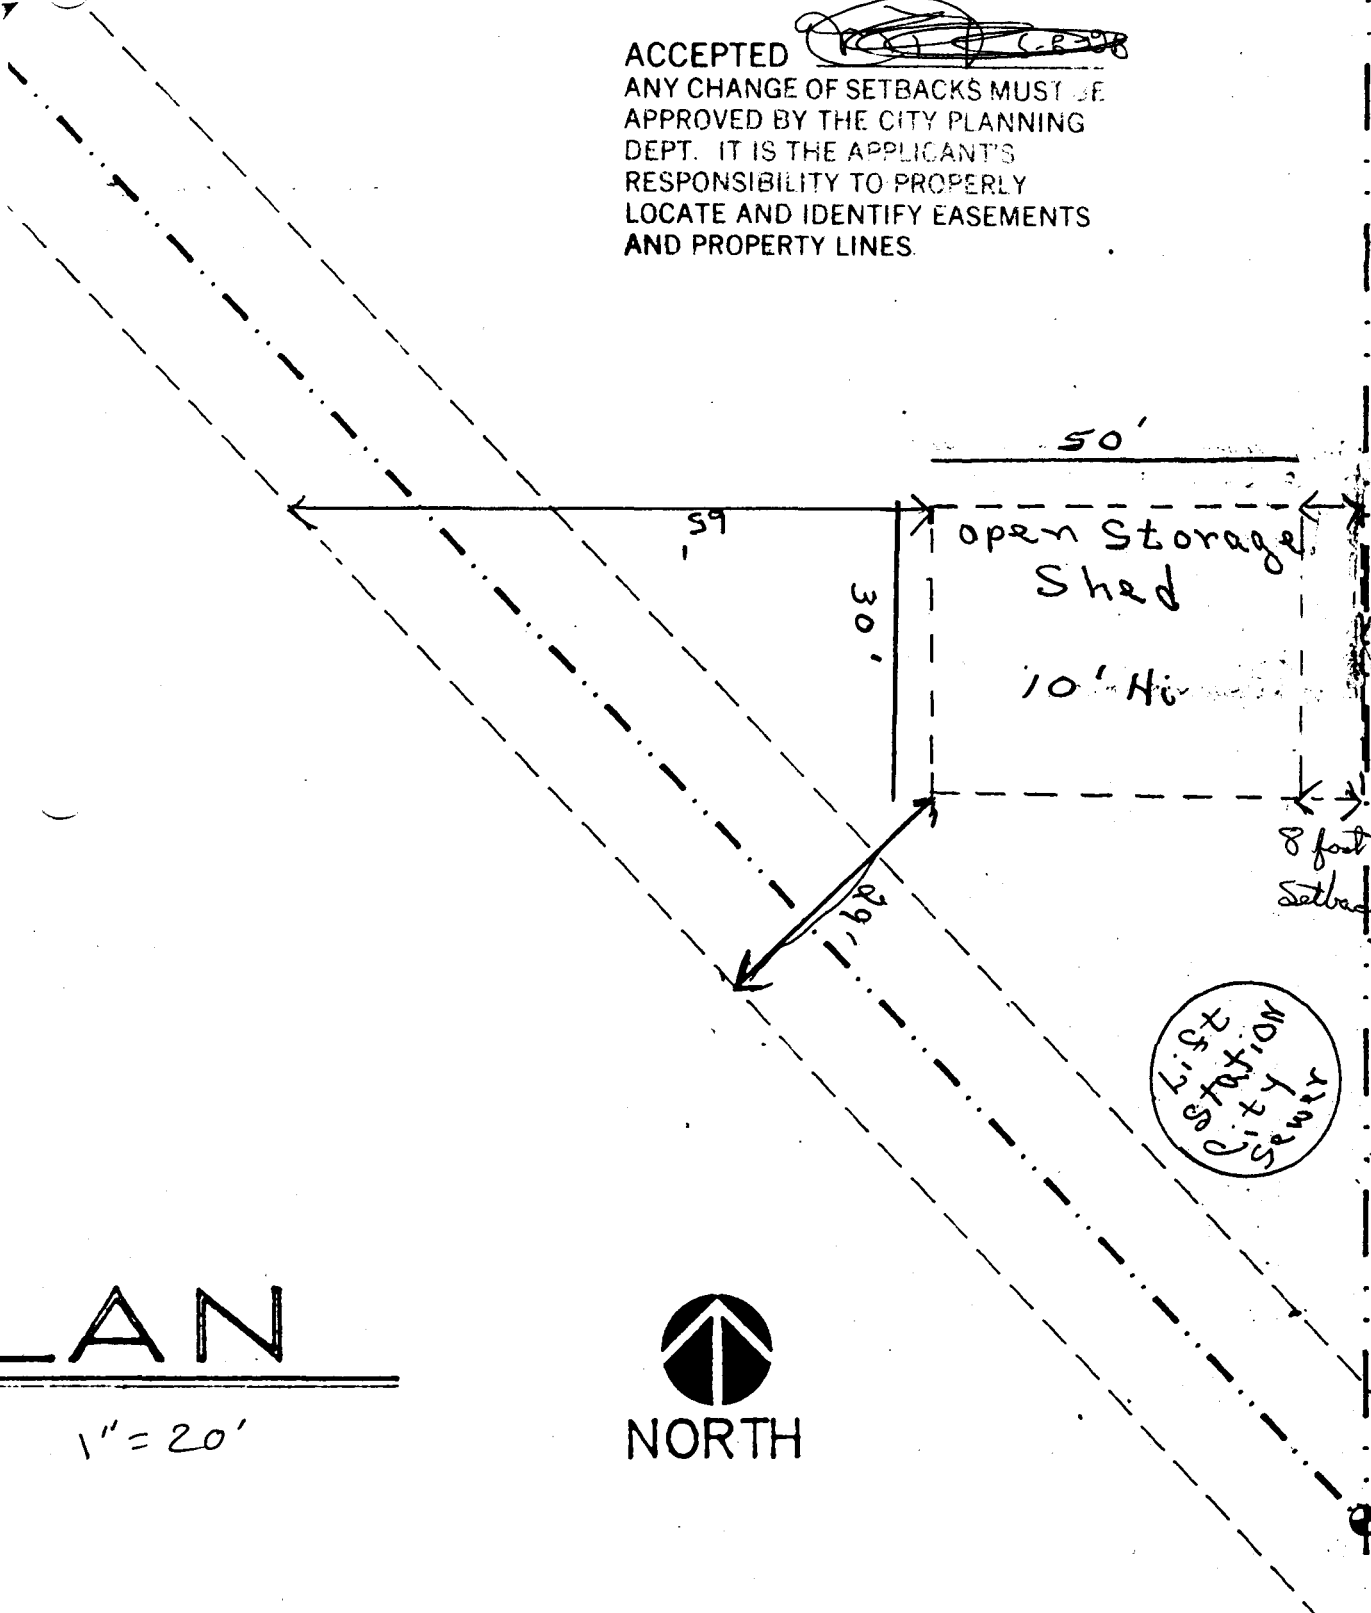

8 foot Setback

List Station City Sewer

AN

1" = 20'




NORTH

SLOPE

S120D 05'50"E

ACCEPTED M1 5-8-98
ANY CHANGE OF SETBACKS MUST BE APPROVED BY THE CITY PLANNING DEPT. IT IS THE APPLICANT'S RESPONSIBILITY TO PROPERLY LOCATE AND IDENTIFY EASEMENTS AND PROPERTY LINES.

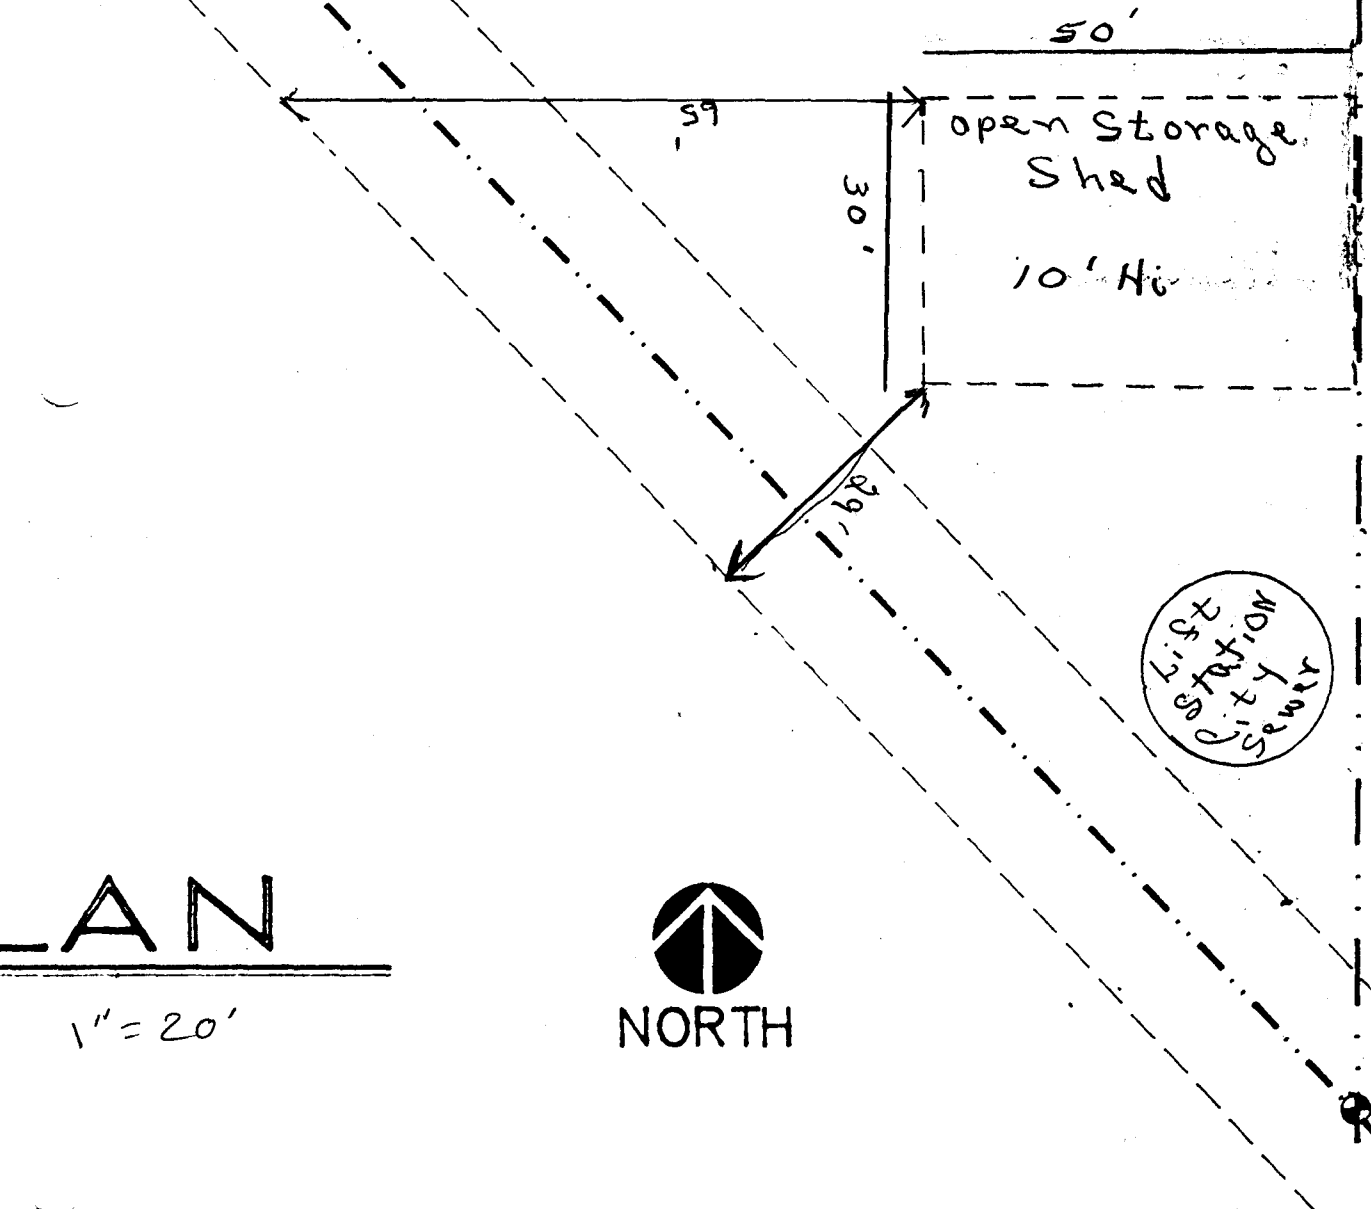

LAN
1" = 20'



1st STATION
City Sewer