

FEE \$	10-
TCP \$	0
SIF \$	292-



BLDG PERMIT NO. 63977

PLANNING CLEARANCE

(Single Family Residential and Accessory Structures)

Community Development Department

BLDG ADDRESS 625 Hunter Creek TAX SCHEDULE NO. 2945-03A-45-CC3
 SUBDIVISION Fall Valley SQ. FT. OF PROPOSED BLDG(S)/ADDITION 1665
 FILING 1 BLK 1 LOT 3 SQ. FT. OF EXISTING BLDG(S) _____
 (1) OWNER John Davis NO. OF DWELLING UNITS BEFORE: 0 AFTER: 1 THIS CONSTRUCTION
 (1) ADDRESS P.O. Box 2861
 (1) TELEPHONE 243-2308 NO. OF BLDGS ON PARCEL BEFORE: _____ AFTER: _____ THIS CONSTRUCTION
 (2) APPLICANT Castle Homes USE OF EXISTING BLDGS NO
 (2) ADDRESS 556 25 Road DESCRIPTION OF WORK AND INTENDED USE: GF
 (2) TELEPHONE 248-9708

REQUIRED: One plot plan, on 8 1/2" x 11" paper, showing all existing & proposed structure location(s), parking, setbacks to all property lines, ingress/egress to the property, driveway location & width & all easements & rights-of-way which abut the parcel.

THIS SECTION TO BE COMPLETED BY COMMUNITY DEVELOPMENT DEPARTMENT STAFF

ZONE PR 2.9 Maximum coverage of lot by structures _____
Garage 20'
 SETBACKS: Front 15' from property line (PL) Parking Req'mt 2
 or _____ from center of ROW, whichever is greater
 Side 10' from PL Rear 20' from PL Special Conditions _____
 Maximum Height 32'
 CENSUS 10 TRAFFIC 19 ANN# _____

Modifications to this Planning Clearance must be approved, in writing, by the Director of the Community Development Department. The structure authorized by this application cannot be occupied until a final inspection has been completed and a Certificate of Occupancy has been issued by the Building Department (Section 305, Uniform Building Code).

I hereby acknowledge that I have read this application and the information is correct; I agree to comply with any and all codes, ordinances, laws, regulations or restrictions which apply to the project. I understand that failure to comply shall result in legal action, which may include but not necessarily be limited to non-use of the building(s).

Applicant Signature Melanie Horn Date 2-13-98
 Department Approval Leita J. Castello Date 2-18-98

Additional water and/or sewer tap fee(s) are required: YES NO _____ W/O No. 11010
 Utility Accounting [Signature] Date 2/18/98


VALID FOR SIX MONTHS FROM DATE OF ISSUANCE (Section 9-3-2C Grand Junction Zoning & Development Code)

(White: Planning) (Yellow: Customer) (Pink: Building Department) (Goldenrod: Utility Accounting)

HUNTER CREEK DRIVE 625 HUNTER CREEK

FALL VALLEY SUBDIVISION BLOCK 1, LOT 3

FILING 1 LOT 3

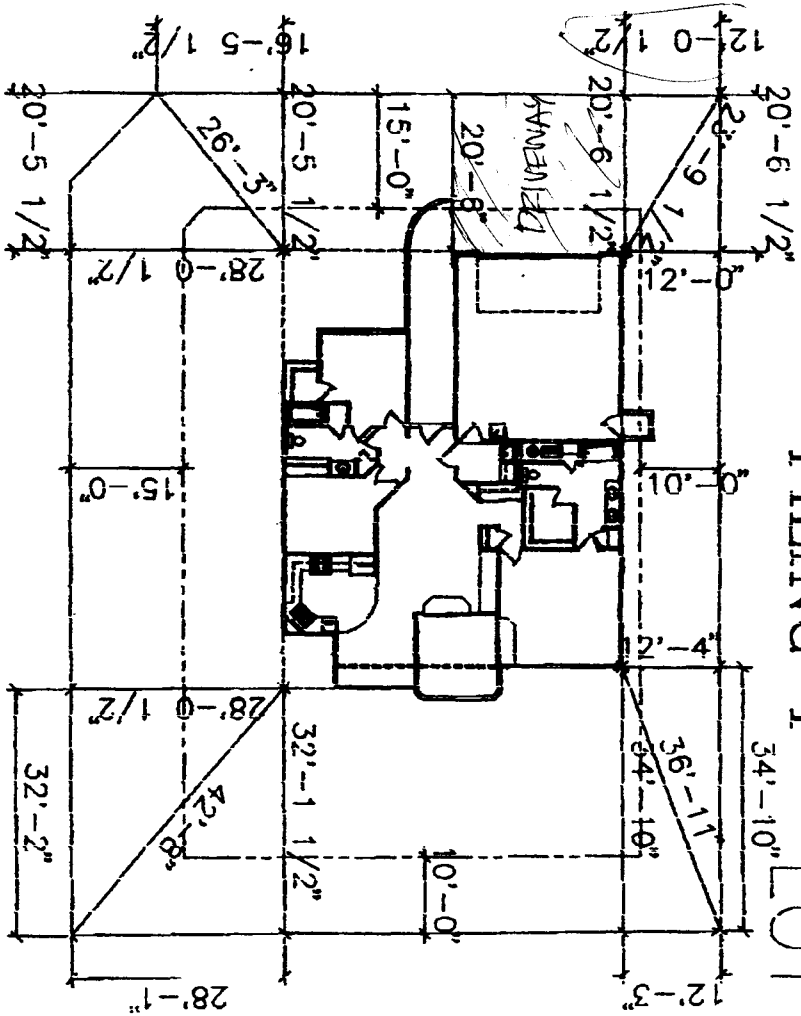

1465 SF

FALL VALLEY AVENUE

ACCEPTED *SLC 2.18.98*
 ANY CHANGE OF SETBACKS MUST BE APPROVED BY THE CITY PLANNING DEPT. IT IS THE APPLICANT'S RESPONSIBILITY TO PROPERLY LOCATE AND IDENTIFY EASEMENTS AND PROPERTY LINES.

APPROVED

PAVEMENT LOCATIONS OK
 W. Caldwell 2/18/98

BLIND PLAN
 SCALE 1/8" = 1'-0" (CHECK NUMBER NOTED)