

FEE \$ 10⁰⁰
TCP \$ 0

BLDG PERMIT NO. 05853

PLANNING CLEARANCE
(Single Family Residential and Accessory Structures)
Grand Junction Community Development Department

THIS SECTION TO BE COMPLETED BY APPLICANT

BLDG ADDRESS 2808 Niagara Circle N. TAX SCHEDULE NO. 2943-182-19-001
SUBDIVISION Niagara Village SQ. FT. OF PROPOSED BLDG(S)/ADDITION approx. 1200
FILING II BLK 1 LOT 6 SQ. FT. OF EXISTING BLDG(S) NA
(1) OWNER A & G Partnership NO. OF DWELLING UNITS
BEFORE: 0 AFTER: 1 THIS CONSTRUCTION
(1) ADDRESS 710 S. 15th Street NO. OF BLDGS ON PARCEL
BEFORE: 0 AFTER: 1 THIS CONSTRUCTION
(2) APPLICANT SAME USE OF EXISTING BLDGS NA
(2) ADDRESS SAME DESCRIPTION OF WORK AND INTENDED USE: Place new
(2) TELEPHONE SAME single family home

ONE (1)

REQUIRED: ~~copy~~ plot plans, on 8 1/2" x 11" paper, showing all existing and proposed structure location(s), parking, setbacks to all property lines, ingress/egress to the property, and all easements and rights-of-way which abut the parcel.

THIS SECTION TO BE COMPLETED BY COMMUNITY DEVELOPMENT DEPARTMENT STAFF

ZONE PR 5.8 Maximum coverage of lot by structures _____
SETBACKS: Front ~~20~~ 15' from property line (PL) Parking Req'mt _____
or _____ from center of ROW, whichever is greater Special Conditions _____
Side 7.5' from PL Rear 10' from PL
Maximum Height _____
CENSUS TRACT 7 TRAFFIC ZONE 39

Modifications to this Planning Clearance must be approved, in writing, by the Director of the Community Development Department. The structure authorized by this application cannot be occupied until a final inspection has been completed and a Certificate of Occupancy has been issued by the Building Department (Section 305, Uniform Building Code).

I hereby acknowledge that I have read this application and the information is correct; I agree to comply with any and all codes, ordinances, laws, regulations or restrictions which apply to the project. I understand that failure to comply shall result in legal action, which may include but not necessarily be limited to non-use of the building(s).

Applicant Signature [Signature] Date 6/23/98
Department Approval [Signature] Date 6-24-98

Additional water and/or sewer tap fee(s) are required: YES X NO _____ W/O No. 11398

Utility Accounting [Signature] Date 6/24/98

VALID FOR SIX MONTHS FROM DATE OF ISSUANCE (Section 9-3-2C Grand Junction Zoning & Development Code)

(White: Planning) (Yellow: Customer) (Pink: Building Department) (Goldenrod: Utility Accounting)


9°59'51" E - 662.44"

ACCEPTED *8-26-9 JK*
ANY CHANGE OF SETBACKS MUST BE APPROVED BY THE CITY PLANNING DEPT. IT IS THE APPLICANT'S RESPONSIBILITY TO PROPERLY LOCATE AND IDENTIFY EASEMENTS AND PROPERTY LINES.

FRUITVAULT WATER & SAN DISI
CL 10' SETBACK EASEMENT
BOOK 946, PAGE 733

CL 10' PUBLIC SERVICE CO EASEMENT
BOOK 1162, PAGE 530

KIMMARDI

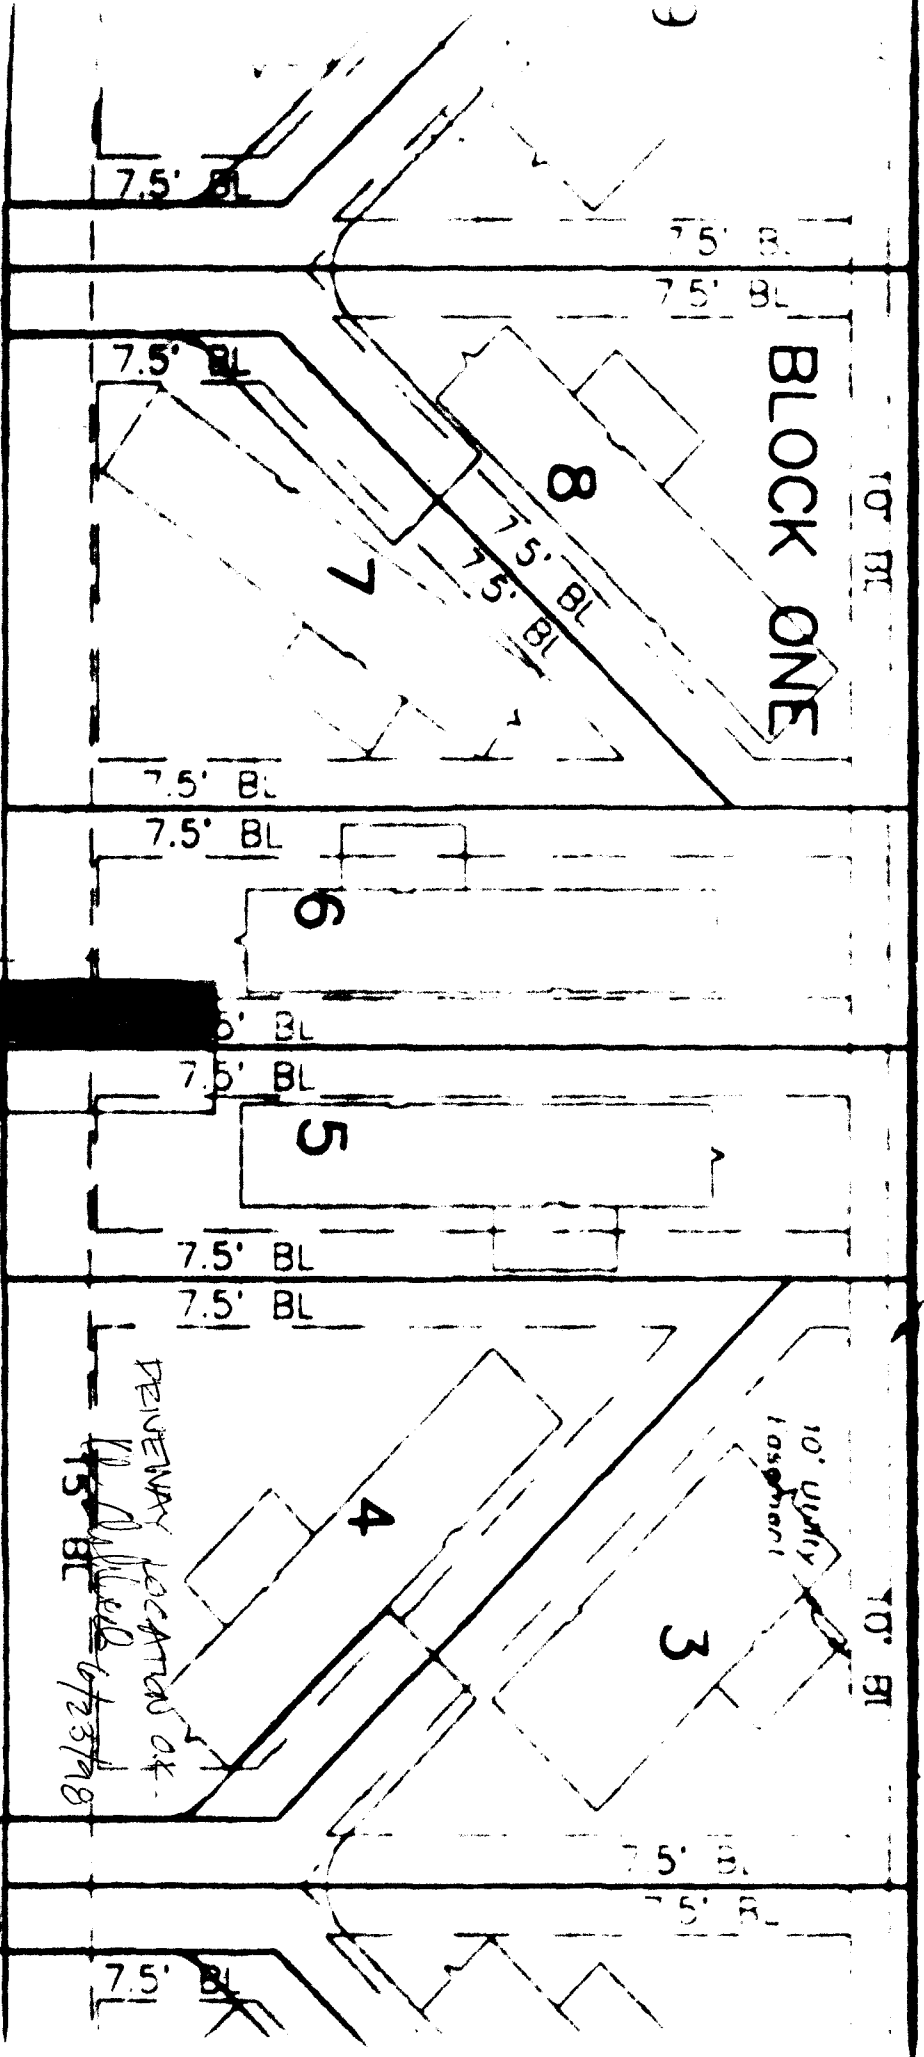

NIAGARA CIRCLE NORTH

N 89°57'30" E 477.54'

Proposed Structures

DRIVEWAY/PARKING SPACE
CEMENT