




ACCEPTED KV 5-28-98 (SC)  
ANY CHANGE OF SETBACKS MUST BE APPROVED BY THE CITY PLANNING DEPT. IT IS THE APPLICANT'S RESPONSIBILITY TO PROPERLY LOCATE AND IDENTIFY EASEMENTS AND PROPERTY LINES.

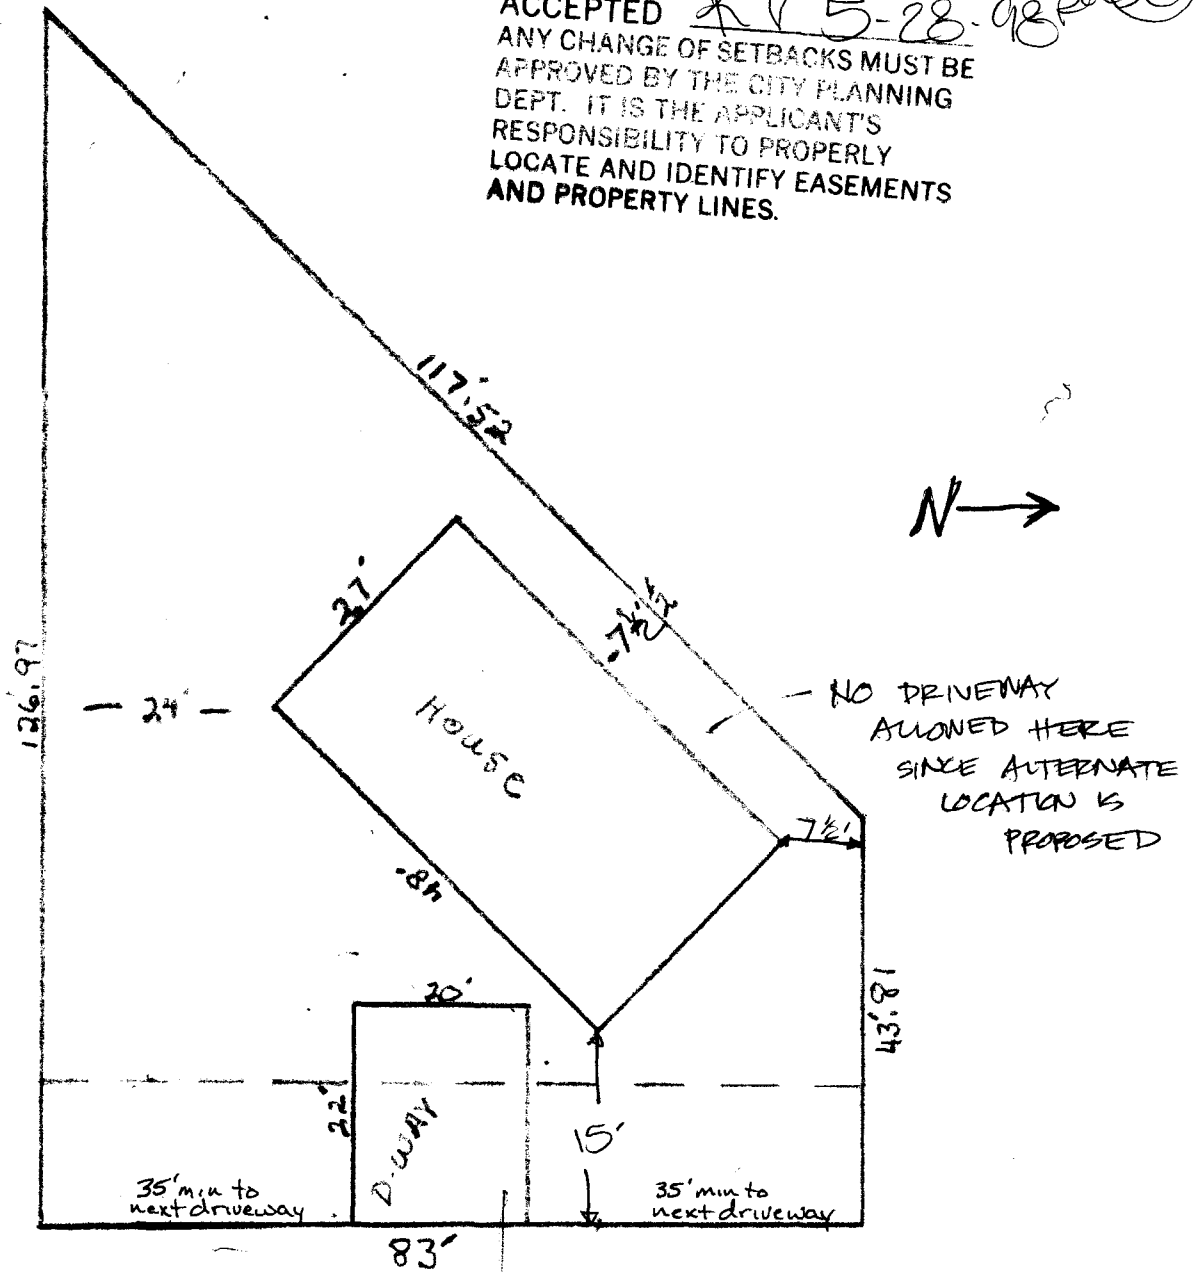

2812 Niagara Circle North

DRIVEWAY LOCATION O.K.  
W. Ashford 5/27/98