

FEE \$ 10⁰⁰
TCP \$ —

BLDG PERMIT NO. 03970

SIF # 292⁰⁰

PLANNING CLEARANCE
(Single Family Residential and Accessory Structures)
Grand Junction Community Development Department

THIS SECTION TO BE COMPLETED BY APPLICANT

BLDG ADDRESS 477 Niagara Circle W. TAX SCHEDULE NO. 2943-182-19-001
SUBDIVISION Niagara Village SQ. FT. OF PROPOSED BLDG(S)/ADDITION approx. 1200
FILING II BLK 1 LOT 22 SQ. FT. OF EXISTING BLDG(S) NA
(1) OWNER A & G Partnership NO. OF DWELLING UNITS
BEFORE: 0 AFTER: 1 THIS CONSTRUCTION
(1) ADDRESS 710 S. 15th Street NO. OF BLDGS ON PARCEL
BEFORE: 0 AFTER: 1 THIS CONSTRUCTION
(1) TELEPHONE 970-242-8134 USE OF EXISTING BLDGS NA
(2) APPLICANT SAME DESCRIPTION OF WORK AND INTENDED USE: Place new
(2) ADDRESS SAME single family home
(2) TELEPHONE SAME

REQUIRED: ^{ONE} ~~TWO~~ (2) plot plans, on 8 1/2" x 11" paper, showing all existing and proposed structure location(s), parking, setbacks to all property lines, ingress/egress to the property, and all easements and rights-of-way which abut the parcel.

THIS SECTION TO BE COMPLETED BY COMMUNITY DEVELOPMENT DEPARTMENT STAFF

ZONE PR S. 8 Maximum coverage of lot by structures _____
SETBACKS: Front 15' from property line (PL) Parking Req'mt _____
or — from center of ROW, whichever is greater
Special Conditions HUD # N-3092812
Side N-7.5' from PL Rear 10' from PL
ut.l. East. ut.l. East.
Maximum Height _____
CENSUS TRACT 7 TRAFFIC ZONE 39

Modifications to this Planning Clearance must be approved, in writing, by the Director of the Community Development Department. The structure authorized by this application cannot be occupied until a final inspection has been completed and a Certificate of Occupancy has been issued by the Building Department (Section 305, Uniform Building Code).

I hereby acknowledge that I have read this application and the information is correct; I agree to comply with any and all codes, ordinances, laws, regulations or restrictions which apply to the project. I understand that failure to comply shall result in legal action, which may include but not necessarily be limited to non-use of the building(s).

Applicant Signature Phyllis Sun Date 1-30-98

Department Approval Santa J. Costello Date 2-3-98


Additional water and/or sewer tap fee(s) are required: YES NO W/O No. 10900

Utility Accounting J. Adams Date 2-3-98

VALID FOR SIX MONTHS FROM DATE OF ISSUANCE (Section 9-3-2C Grand Junction Zoning & Development Code)

(White: Planning) (Yellow: Customer) (Pink: Building Department) (Goldenrod: Utility Accounting)


N 00'08.59 W 611.41

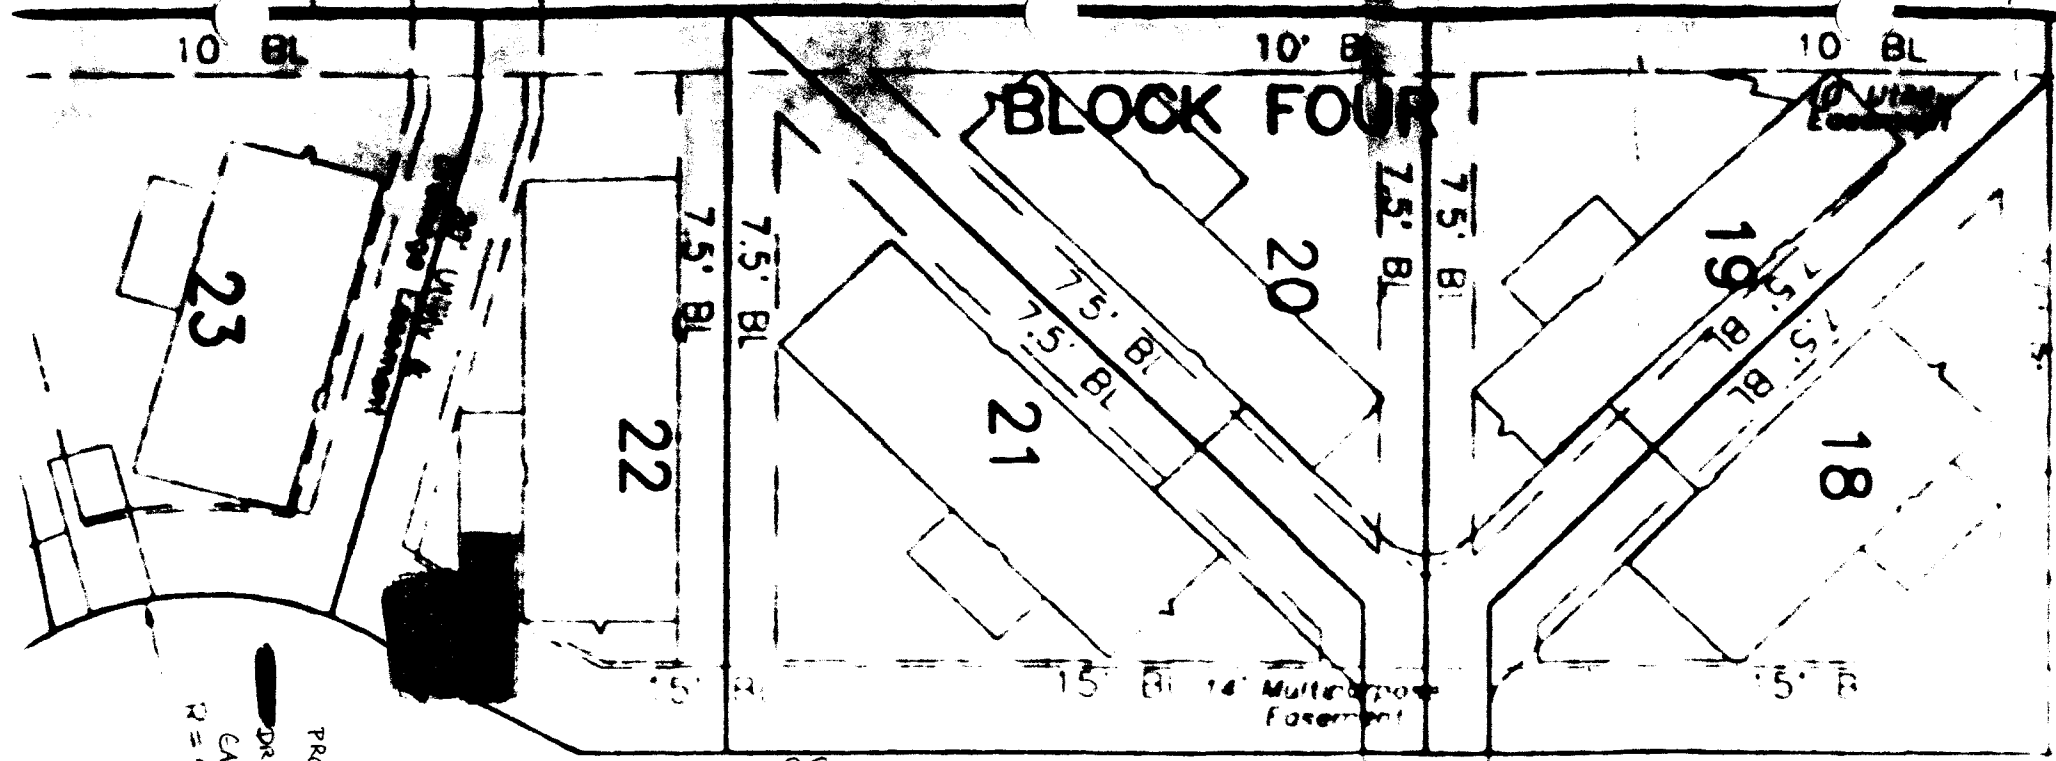

NIAGARA CIRCLE WEST

S 00'08.10" E 367.46'

ACCEPTED SLC 2.3.98
 ANY CHANGE OF SETBACKS MUST BE APPROVED BY THE CITY PLANNING DEPT. IT IS THE APPLICANT'S RESPONSIBILITY TO PROPERLY LOCATE AND IDENTIFY EASEMENTS AND PROPERTY LINES.

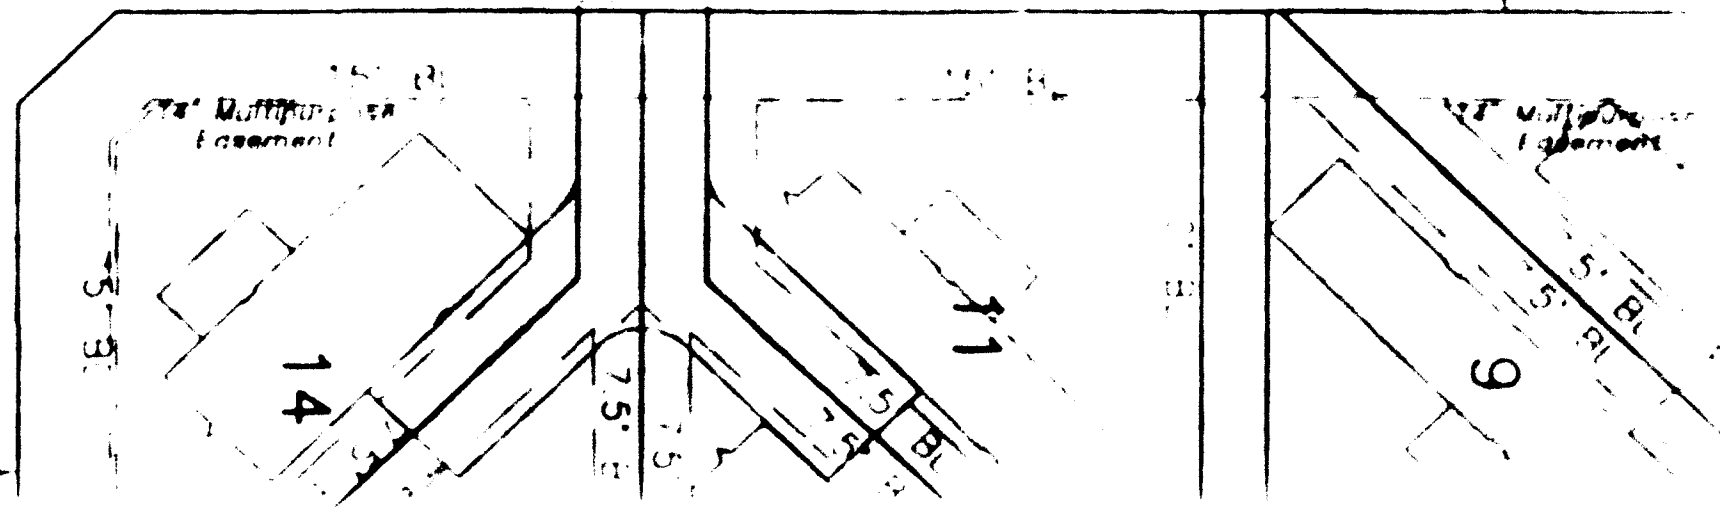

PROPOSED STRUCTURE
 DRIVEWAY/PARKING SPACE
 CASEMENT
 R = 45'

PERMANENT LOCATION O.K.
 VE Deleted 1/30/98

NIAGARA CIRCLE S →