

Planning \$ <u>5<sup>00</sup></u>	Drainage \$ <u>—</u>
TCP \$ <u>—</u>	School Impact \$ <u>—</u>

BLDG PERMIT NO. <u>U3734</u>
FILE #

## PLANNING CLEARANCE

(site plan review, multi-family development, non-residential development)

### Grand Junction Community Development Department

THIS SECTION TO BE COMPLETED BY APPLICANT

BLDG ADDRESS 747 ~~NORTH~~ AVE TAX SCHEDULE NO. 2945-141-02-002/003

SUBDIVISION City of G.J. SQ. FT. OF PROPOSED BLDG(S)/ADDITION —

FILING — BLK 5 LOT 15-18 SQ. FT. OF EXISTING BLDG(S) 5425 SQ FT

(1) OWNER World of Tile NO. OF DWELLING UNITS  
BEFORE: 9 AFTER: — CONSTRUCTION

(1) ADDRESS DENVER NO. OF BLDGS ON PARCEL  
BEFORE: 1 AFTER: 1 CONSTRUCTION

(1) TELEPHONE 303-794-0136 USE OF ALL EXISTING BLDGS —

(2) APPLICANT Alco Building Co DESCRIPTION OF WORK & INTENDED USE: whole sale -  
RETAIL TILE

(2) ADDRESS 529 25<sup>1</sup>/<sub>2</sub> Rd.

(2) TELEPHONE 970-242-1423

✓ Submittal requirements are outlined in the SSID (Submittal Standards for Improvements and Development) document.

THIS SECTION TO BE COMPLETED BY COMMUNITY DEVELOPMENT DEPARTMENT STAFF

ZONE C-1 Landscaping / Screening Required: YES — NO —

SETBACKS: Front — from Property Line (PL) or — from center of ROW, whichever is greater Parking Req'mt 11 as per attached plan

Side — from PL Rear — from PL Special Conditions: interior remodel No Change in use, STRIPING FOR PARKING MUST BE IN PRIOR TO CO.

Maximum Height — Census Tract 2 Traffic Zone 36 Annx # —

Maximum coverage of lot by structures —

Modifications to this Planning Clearance must be approved, in writing, by the Community Development Department Director. The structure authorized by this application cannot be occupied until a final inspection has been completed and a Certificate of Occupancy has been issued by the Building Department (Section 307, Uniform Building Code). Required improvements in the public right-of-way must be guaranteed prior to issuance of a Planning Clearance. All other required site improvements must be completed or guaranteed prior to issuance of a Certificate of Occupancy. Any landscaping required by this permit shall be maintained in an acceptable and healthy condition. The replacement of any vegetation materials that die or are in an unhealthy condition is required by the G.J. Zoning and Development Code.

Four (4) sets of final construction drawings must be submitted and stamped by City Engineering prior to issuing the Planning Clearance. One stamped set must be available on the job site at all times.

I hereby acknowledge that I have read this application and the information is correct; I agree to comply with any and all codes, ordinances, laws, regulations, or restrictions which apply to the project. I understand that failure to comply shall result in legal action, which may include but not necessarily be limited to non-use of the building(s).

Applicant's Signature [Signature] Date 1/27/98

Department Approval [Signature] Date 1/28/98


Additional water and/or sewer tap fee(s) are required: YES — NO — W/O No. —

Utility Accounting [Signature] Date 1-28-98

VALID FOR SIX MONTHS FROM DATE OF ISSUANCE (Section 9-3-2C Grand Junction Zoning & Development Code)

(White: Planning) (Yellow: Customer) (Pink: Building Department) (Goldenrod: Utility Accounting)

NORTH AVE

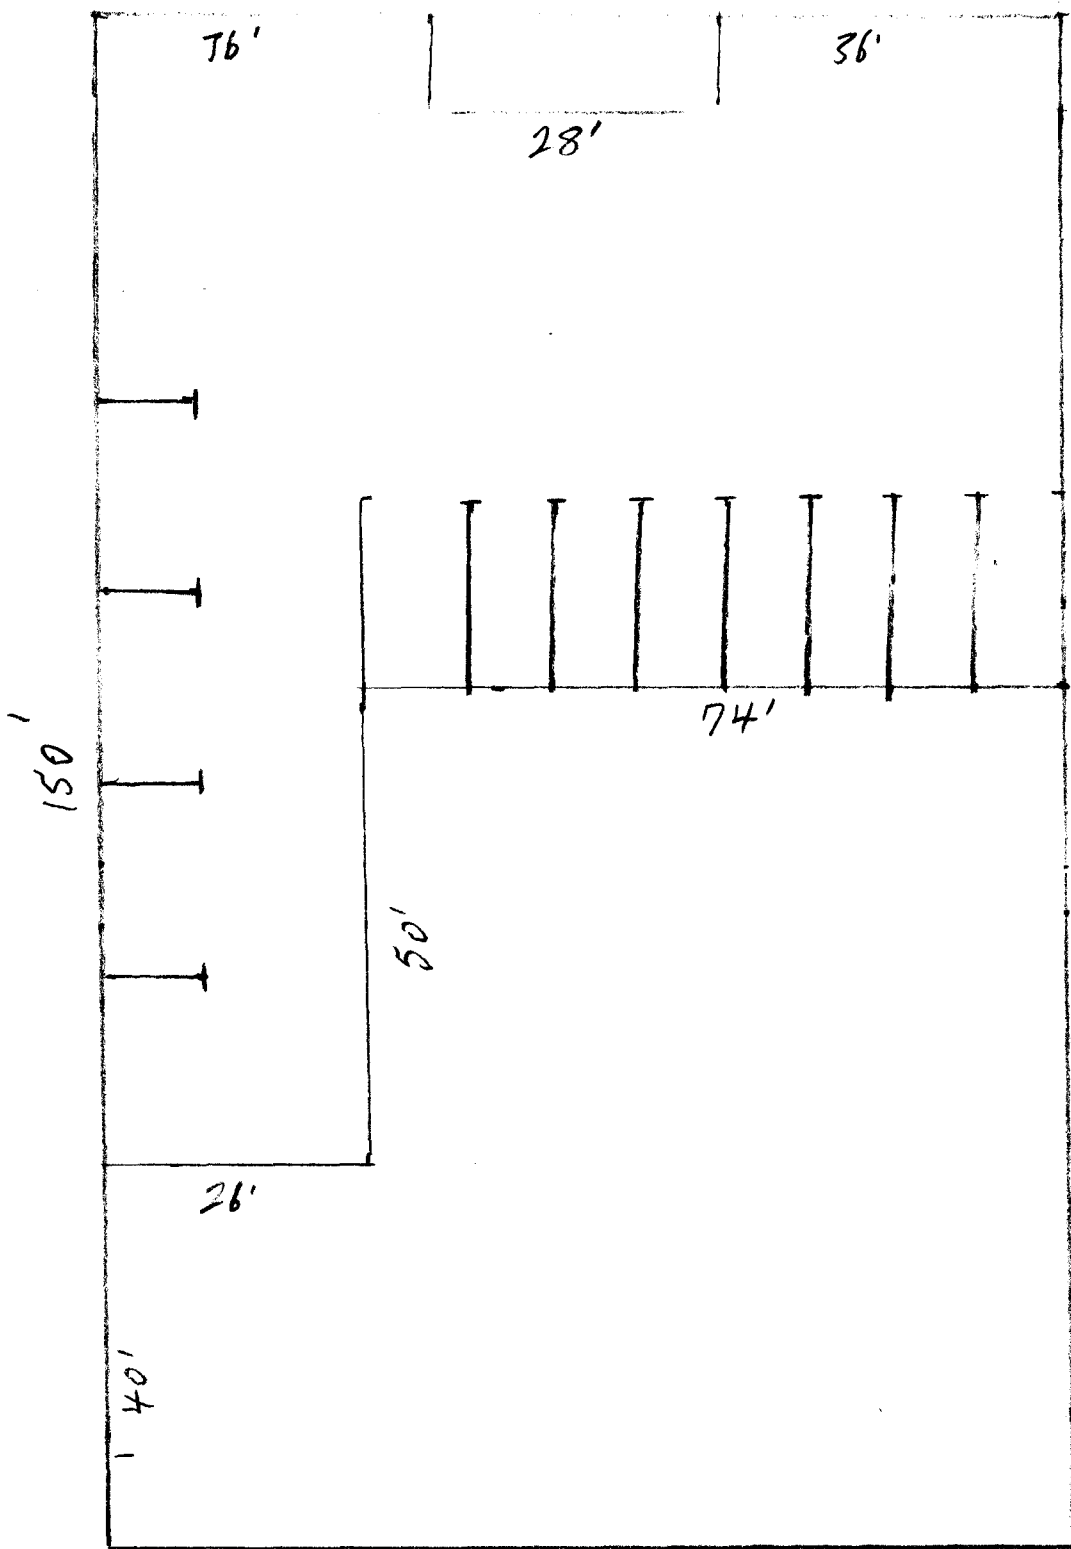

100'

ACCEPTED SLC per MTD 1-28-98  
ANY CHANGE OF SETBACKS MUST BE  
APPROVED BY THE CITY PLANNING  
DEPT. IT IS THE APPLICANT'S  
RESPONSIBILITY TO PROPERLY  
LOCATE AND IDENTIFY EASEMENTS  
AND PROPERTY LINES.