

FEE \$	10 ⁰⁰
TCP \$	500 ⁰⁰
SIF \$	292 ⁰⁰



BLDG PERMIT NO. 104289

PLANNING CLEARANCE

(Single Family Residential and Accessory Structures)

Community Development Department

BLDG ADDRESS 2415 Pheasant Trail TAX SCHEDULE NO. 2945-014-89-014

SUBDIVISION Pheasant Ridge Estates SQ. FT. OF PROPOSED BLDG(S)/ADDITION _____

FILING _____ BLK 1 LOT 14 SQ. FT. OF EXISTING BLDG(S) _____

(1) OWNER Just Companies Inc NO. OF DWELLING UNITS BEFORE: 0 AFTER: 1 THIS CONSTRUCTION

(1) ADDRESS 826 2 1/2 Rd.

(1) TELEPHONE 245-9316 NO. OF BLDGS ON PARCEL BEFORE: 0 AFTER: 1 THIS CONSTRUCTION

(2) APPLICANT Just Companies Inc USE OF EXISTING BLDGS _____

(2) ADDRESS 826 2 1/2 Rd. DESCRIPTION OF WORK AND INTENDED USE: _____

(2) TELEPHONE 245-9316 Single family detached residence

REQUIRED: One plot plan, on 8 1/2" x 11" paper, showing all existing & proposed structure location(s), parking, setbacks to all property lines, ingress/egress to the property, driveway location & width & all easements & rights-of-way which abut the parcel.

THIS SECTION TO BE COMPLETED BY COMMUNITY DEVELOPMENT DEPARTMENT STAFF

ZONE PR 8

Maximum coverage of lot by structures _____

SETBACKS: Front 20' from property line (PL) or _____ from center of ROW, whichever is greater

Parking Req'mt 2

Side 5' from PL Rear 15' from PL

Special Conditions _____

Maximum Height _____

CENSUS 10 TRAFFIC 21 ANN# _____

Modifications to this Planning Clearance must be approved, in writing, by the Director of the Community Development Department. The structure authorized by this application cannot be occupied until a final inspection has been completed and a Certificate of Occupancy has been issued by the Building Department (Section 305, Uniform Building Code).

I hereby acknowledge that I have read this application and the information is correct; I agree to comply with any and all codes, ordinances, laws, regulations or restrictions which apply to the project. I understand that failure to comply shall result in legal action, which may include but not necessarily be limited to non-use of the building(s).

Applicant Signature Sandra Bauland Date 3/6/98


Department Approval Santa Costello Date 3-12-98

Additional water and/or sewer tap fee(s) are required: YES NO _____ W/O No. 84137 11A67

Utility Accounting CM Cole Date 3/13/98

VALID FOR SIX MONTHS FROM DATE OF ISSUANCE (Section 9-3-2C Grand Junction Zoning & Development Code)

(White: Planning) (Yellow: Customer) (Pink: Building Department) (Goldenrod: Utility Accounting)

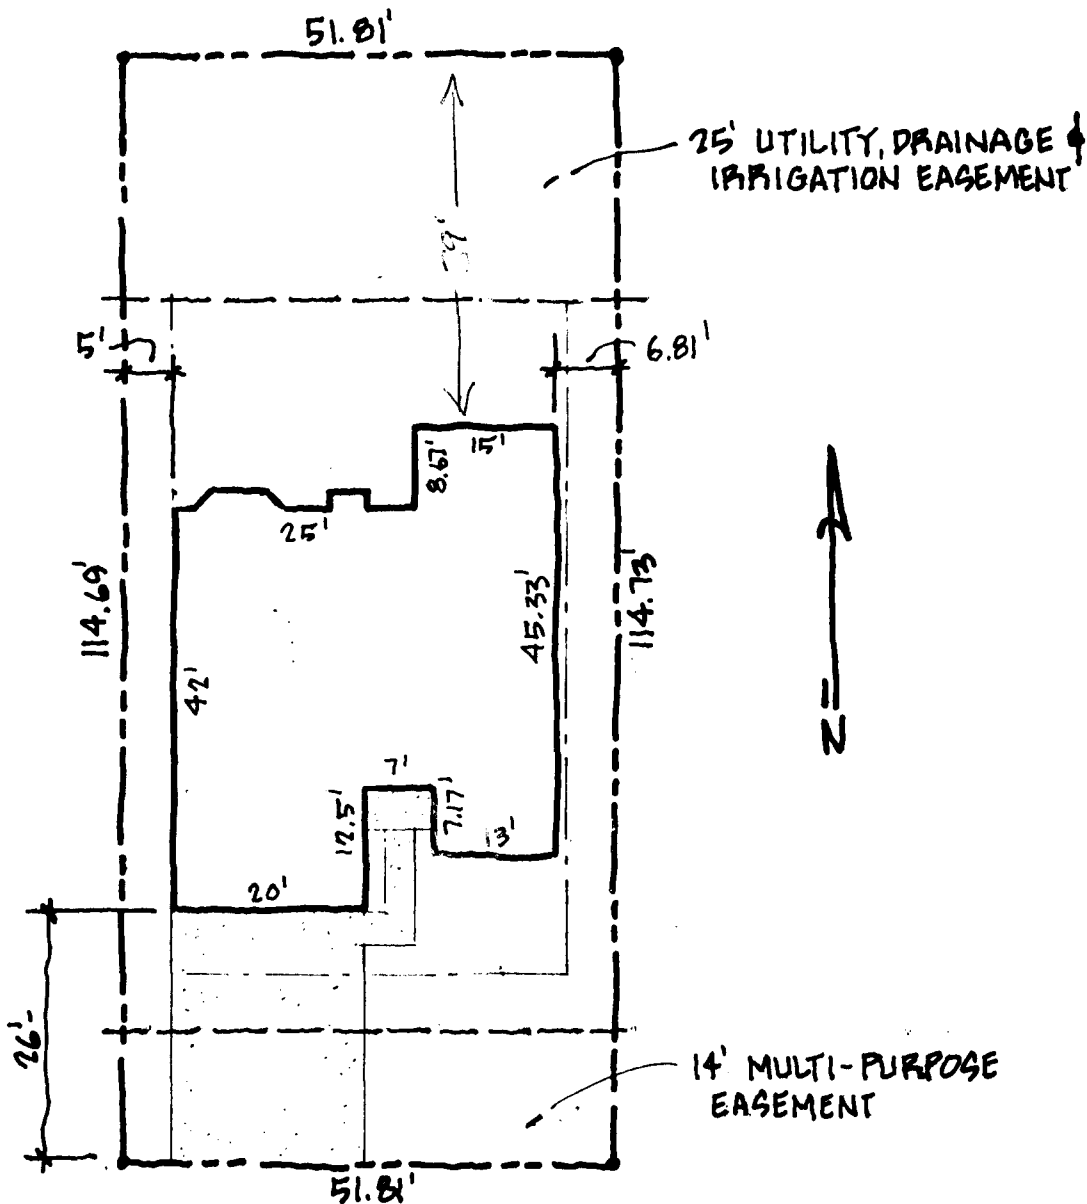

PRIVATE DRIVE

ACCEPTED SUC 3-12-98
 ANY CHANGE OF SETBACKS MUST BE APPROVED BY THE CITY PLANNING DEPT. IT IS THE APPLICANT'S RESPONSIBILITY TO PROPERLY LOCATE AND IDENTIFY EASEMENTS AND PROPERTY LINES.

2415 PHEASANT TRAIL CT
PHEASANT RIDGE ESTATE
 BLOCK 1 LOT 14
PLOT PLAN
 1" = 20'

DRIVEWAY LOCATION O.K.
 W. Chubb
 3/11/99