

FEE \$	10-
TCP \$	500-
SIF \$	242-



BLDG PERMIT NO. 66837

### PLANNING CLEARANCE

(Single Family Residential and Accessory Structures)  
**Community Development Department**

BLDG ADDRESS 2430 Pheasant Trail TAX SCHEDULE NO. 2945-014-90-005

SUBDIVISION Pheasant Ridge Estates SQ. FT. OF PROPOSED BLDG(S)/ADDITION 1036

FILING \_\_\_\_\_ BLK 2 LOT 5 SQ. FT. OF EXISTING BLDG(S) —

(1) OWNER Just Companies, Inc NO. OF DWELLING UNITS BEFORE: 0 AFTER: 1 THIS CONSTRUCTION

(1) ADDRESS 826 2 1/2 Rd.

(1) TELEPHONE 245-9316 NO. OF BLDGS ON PARCEL BEFORE: 0 AFTER: 1 THIS CONSTRUCTION

(2) APPLICANT Just Companies, Inc USE OF EXISTING BLDGS 0

(2) ADDRESS 826 2 1/2 Rd. DESCRIPTION OF WORK AND INTENDED USE: \_\_\_\_\_

(2) TELEPHONE 245-9316 single family detached residence

**REQUIRED: One plot plan, on 8 1/2" x 11" paper, showing all existing & proposed structure location(s), parking, setbacks to all property lines, ingress/egress to the property, driveway location & width & all easements & rights-of-way which abut the parcel.**

**THIS SECTION TO BE COMPLETED BY COMMUNITY DEVELOPMENT DEPARTMENT STAFF**

ZONE R-0 Maximum coverage of lot by structures \_\_\_\_\_

SETBACKS: Front 20' from property line (PL) Parking Req'mt 2  
 or \_\_\_\_\_ from center of ROW, whichever is greater

Side 5' from PL Rear 15' from PL Special Conditions As per building envelope

Maximum Height \_\_\_\_\_ CENSUS 10 TRAFFIC 1 ANNEX# \_\_\_\_\_

Modifications to this Planning Clearance must be approved, in writing, by the Director of the Community Development Department. The structure authorized by this application cannot be occupied until a final inspection has been completed and a Certificate of Occupancy has been issued by the Building Department (Section 305, Uniform Building Code).

I hereby acknowledge that I have read this application and the information is correct; I agree to comply with any and all codes, ordinances, laws, regulations or restrictions which apply to the project. I understand that failure to comply shall result in legal action, which may include but not necessarily be limited to non-use of the building(s).


Applicant Signature Sandra Bowland Date 9/10/98

Department Approval Walter L. Helbeck Date 9/25/98

Additional water and/or sewer tap fee(s) are required: YES  NO \_\_\_\_\_ W/O No. 11616

Utility Accounting J. Adams Date 9-25-98

VALID FOR SIX MONTHS FROM DATE OF ISSUANCE (Section 9-3-2C Grand Junction Zoning & Development Code)

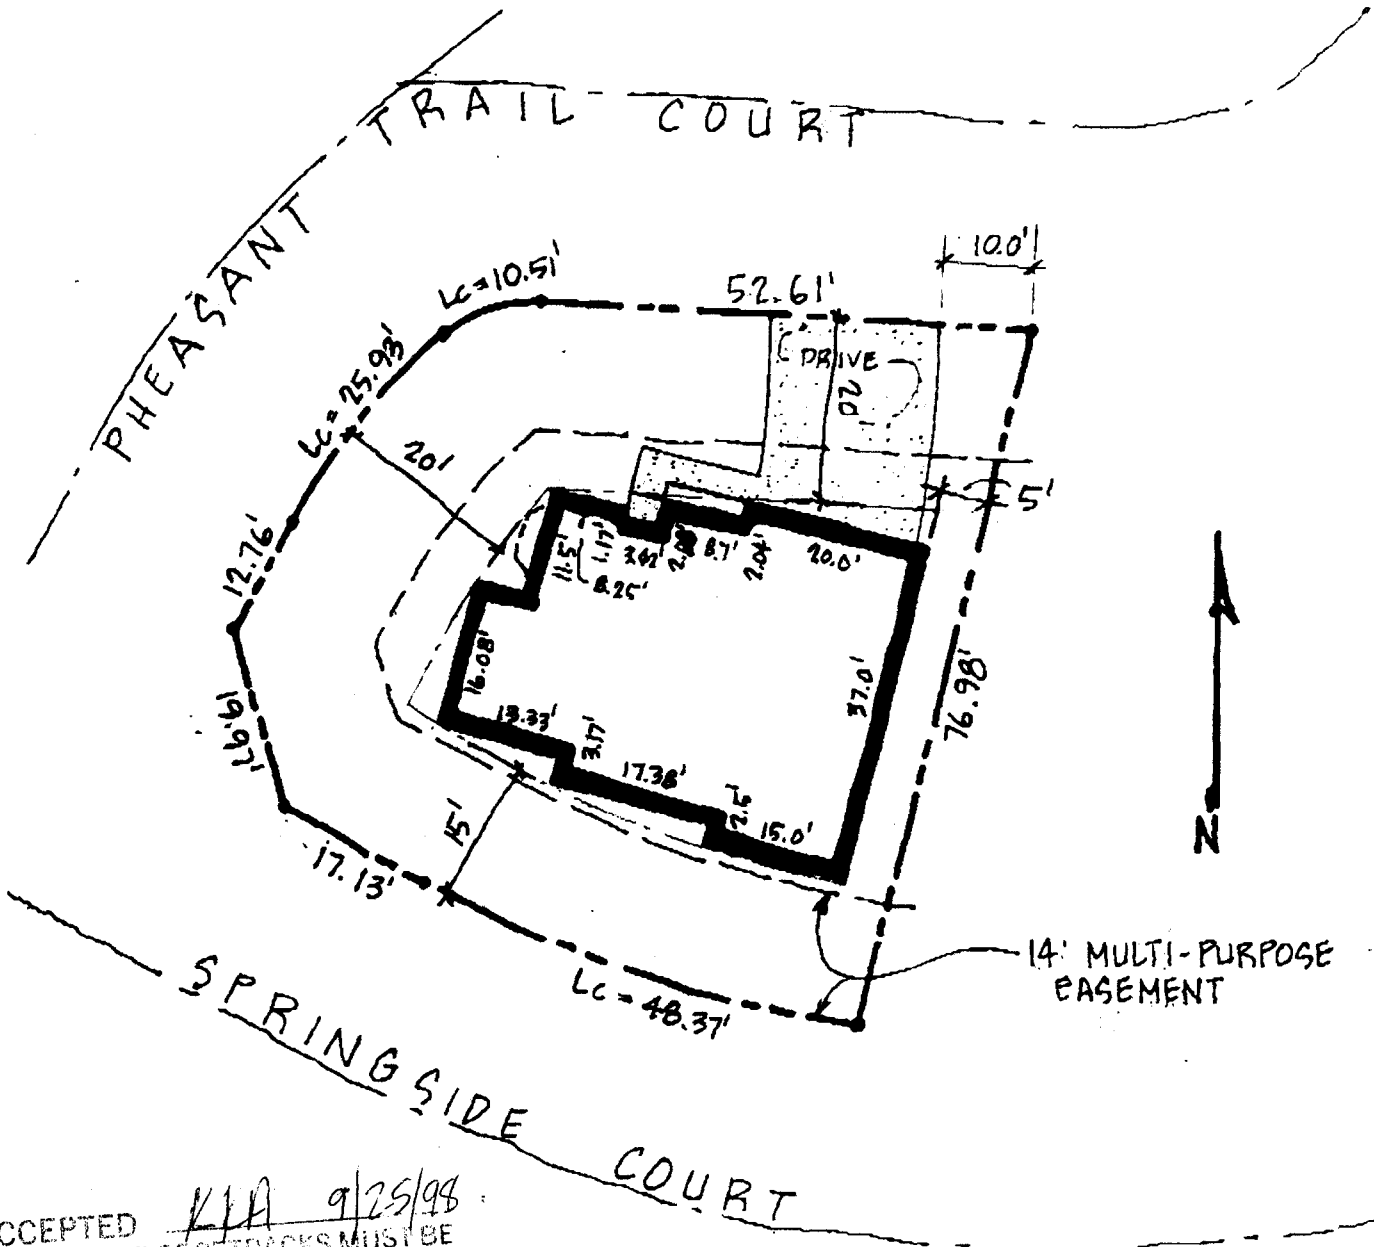

ACCEPTED KJA 9/25/98  
 ANY CHANGE OF SETBACKS MUST BE APPROVED BY THE CITY PLANNING DEPT. IT IS THE APPLICANT'S RESPONSIBILITY TO PROPERLY LOCATE AND IDENTIFY EASEMENTS AND PROPERTY LINES.

2430 PHEASANT TRAIL CT  
PHEASANT RIDGE ESTATE  
 BLOCK 2 LOT 5  
PLOT PLAN  
 1" = 20'

*Drive OK*  
*Tick Dennis*  
*9-14-98*