

FEE \$	10 ⁰⁰
TCP \$	—
SIF \$	—



BLDG PERMIT NO. 67080

PLANNING CLEARANCE

(Single Family Residential and Accessory Structures)

Community Development Department

BLDG ADDRESS 312 Pinon ST. TAX SCHEDULE NO. 2945-243-30-002
 SUBDIVISION Mesa Verde Est. SQ. FT. OF PROPOSED BLDG(S)/ADDITION 606
 FILING — BLK — LOT 2 SQ. FT. OF EXISTING BLDG(S) ~~1280~~ 1280
 (1) OWNER NORBERT H. & JUDY E. ERICKSON NO. OF DWELLING UNITS
 BEFORE: 1 AFTER: 1 THIS CONSTRUCTION
 (1) ADDRESS 312 PINON ST
 (1) TELEPHONE 242-4489 NO. OF BLDGS ON PARCEL
 BEFORE: 2 AFTER: 2 THIS CONSTRUCTION
 (2) APPLICANT NORBERT ERICKSON USE OF EXISTING BLDGS our house
 (2) ADDRESS 312 PINON ST DESCRIPTION OF WORK AND INTENDED USE: Living
 (2) TELEPHONE 242-4489 ADDITION ON EXISTING HOUSE

REQUIRED: One plot plan, on 8 1/2" x 11" paper, showing all existing & proposed structure location(s), parking, setbacks to all property lines, ingress/egress to the property, driveway location & width & all easements & rights-of-way which abut the parcel.

THIS SECTION TO BE COMPLETED BY COMMUNITY DEVELOPMENT DEPARTMENT STAFF

ZONE RSE-8 Maximum coverage of lot by structures 45%
 SETBACKS: Front 20' from property line (PL) Parking Req'mt _____
 or 45' from center of ROW, whichever is greater Special Conditions _____
 Side 5' from PL Rear 15' from PL
 Maximum Height 32' CENSUS 13 TRAFFIC 80 ANN# _____

Modifications to this Planning Clearance must be approved, in writing, by the Director of the Community Development Department. The structure authorized by this application cannot be occupied until a final inspection has been completed and a Certificate of Occupancy has been issued by the Building Department (Section 305, Uniform Building Code).

I hereby acknowledge that I have read this application and the information is correct; I agree to comply with any and all codes, ordinances, laws, regulations or restrictions which apply to the project. I understand that failure to comply shall result in legal action, which may include but not necessarily be limited to non-use of the building(s).


Applicant Signature Norbert H. Erickson Date Sept-28-1998
 Department Approval Antonia Castella Date 9-28-98

Additional water and/or sewer tap fee(s) are required: YES _____ NO X W/O No. _____

Utility Accounting [Signature] Date 9/28/98

VALID FOR SIX MONTHS FROM DATE OF ISSUANCE (Section 9-3-2C Grand Junction Zoning & Development Code)

(White: Planning) (Yellow: Customer) (Pink: Building Department) (Goldenrod: Utility Accounting)

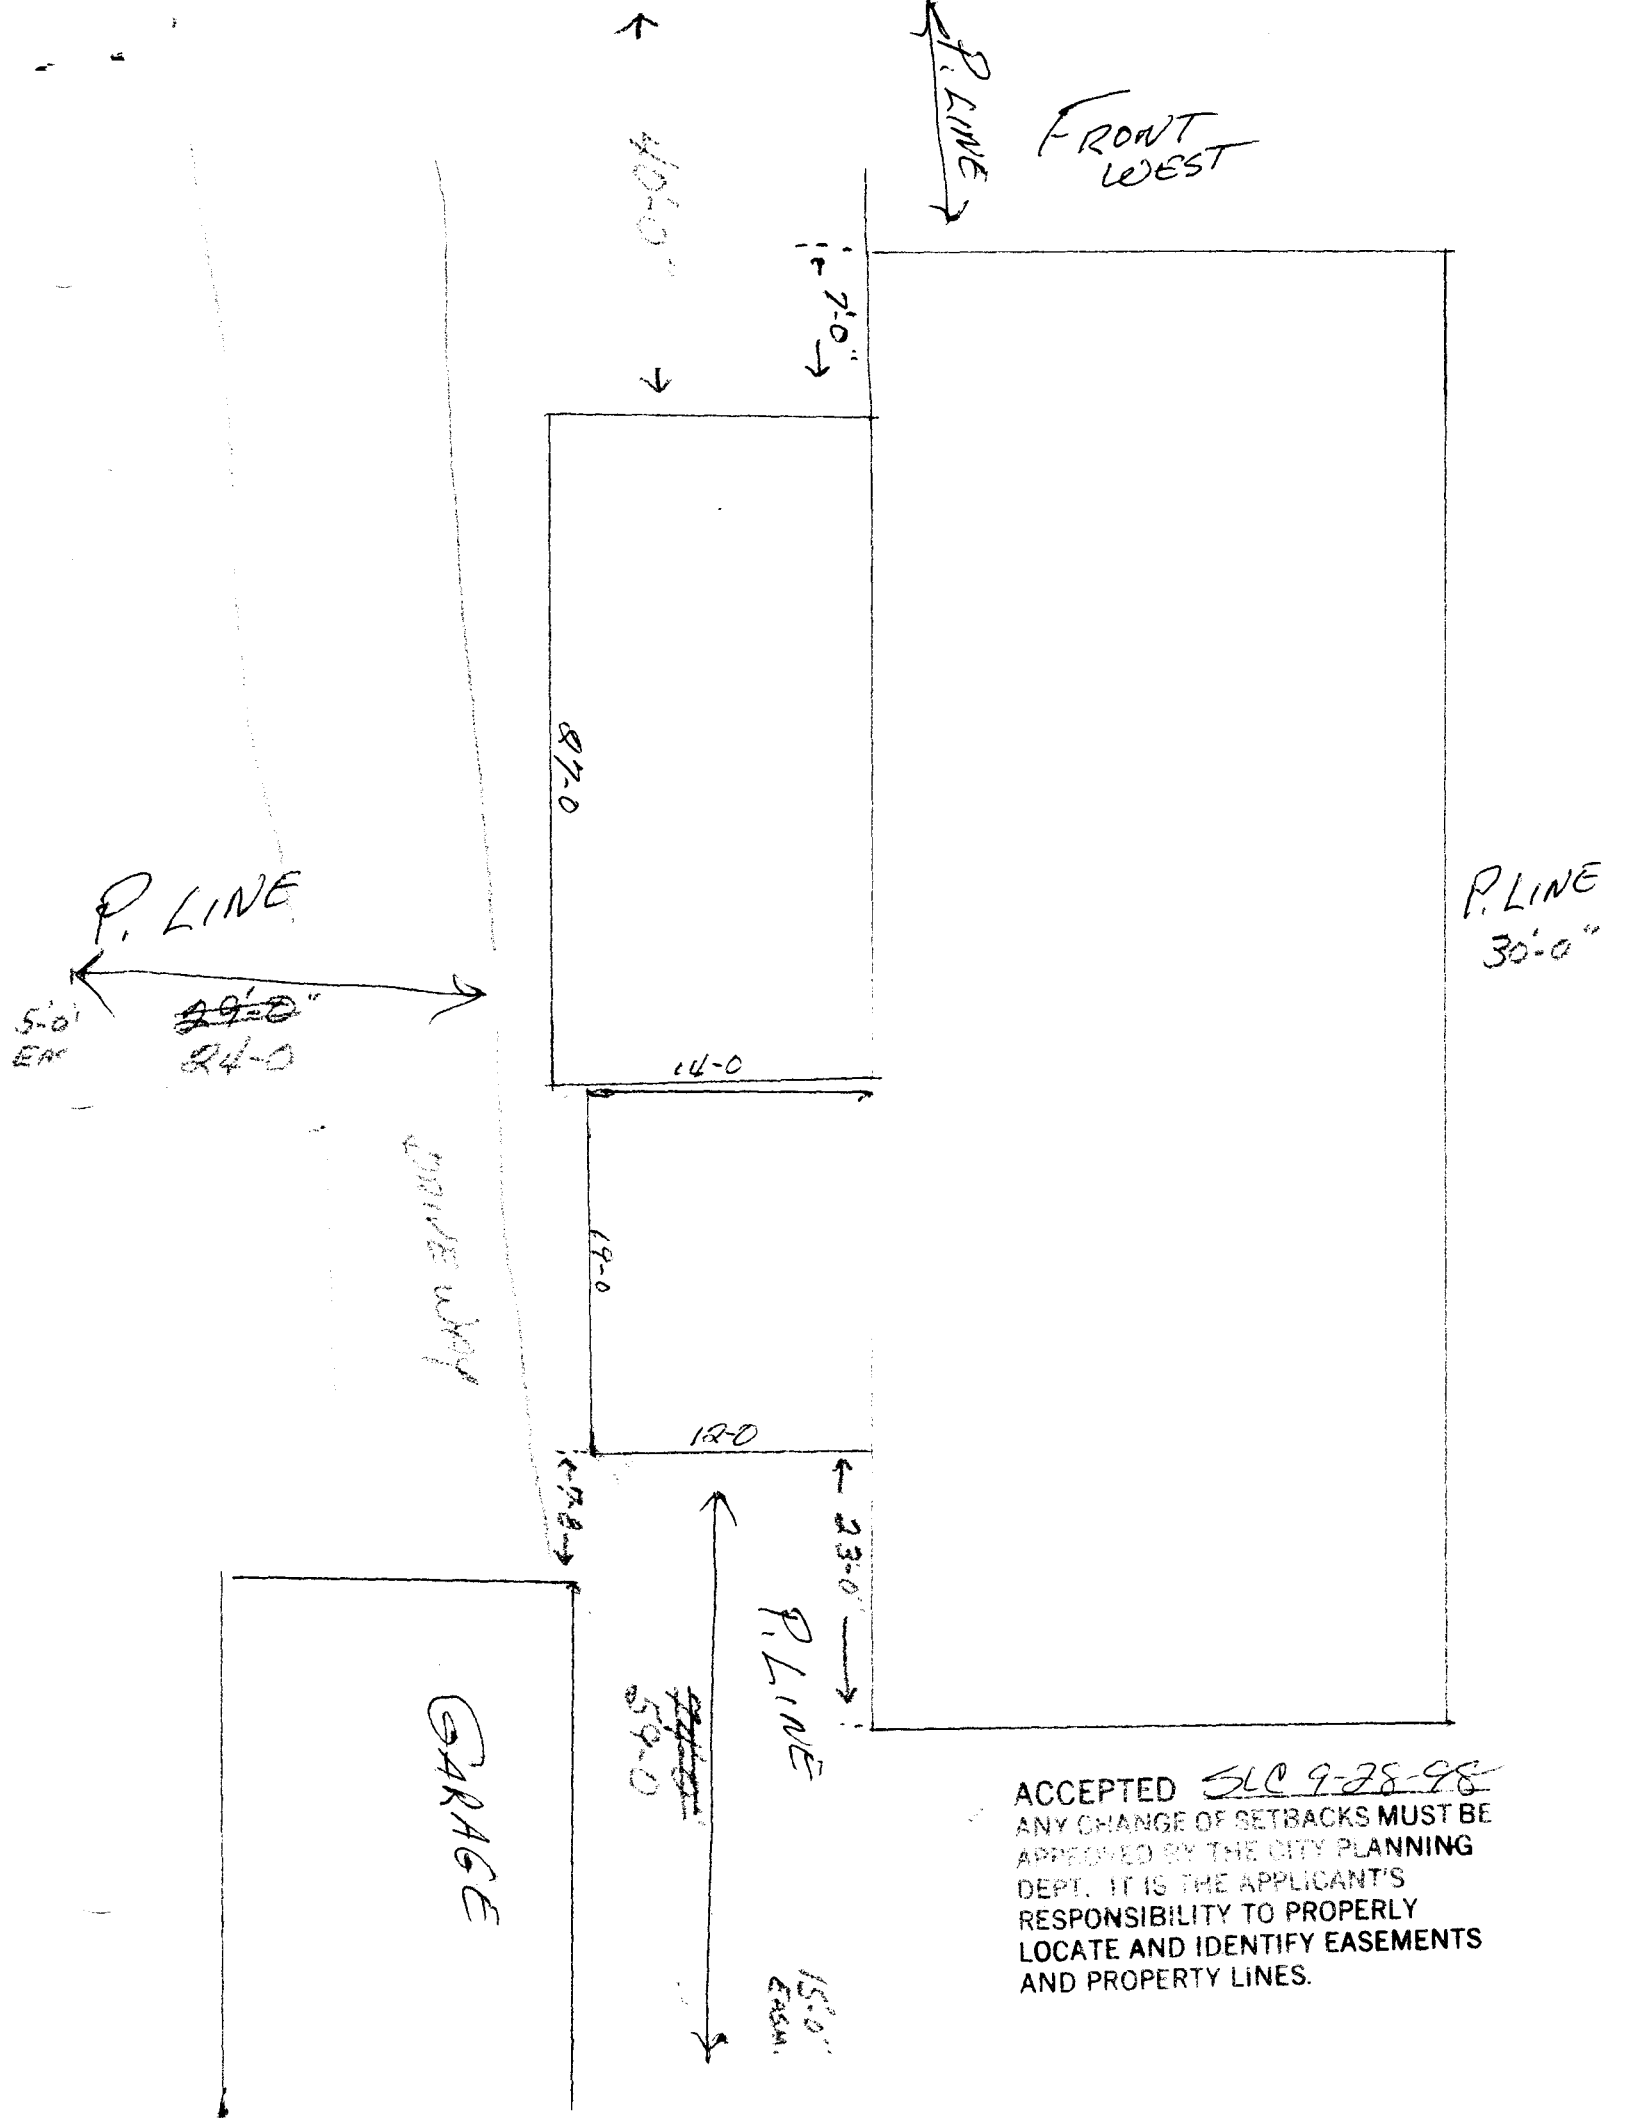

ACCEPTED SLC 9-28-98
 ANY CHANGE OF SETBACKS MUST BE
 APPROVED BY THE CITY PLANNING
 DEPT. IT IS THE APPLICANT'S
 RESPONSIBILITY TO PROPERLY
 LOCATE AND IDENTIFY EASEMENTS
 AND PROPERTY LINES.