

FEE \$	10.-
TCP \$	50.-
SIF \$	292.-



BLDG PERMIT NO. 64822

**PLANNING CLEARANCE**

(Single Family Residential and Accessory Structures)  
**Community Development Department**

BLDG ADDRESS 2385 Spring Side Ct TAX SCHEDULE NO. 2945-014-89-003  
SUBDIVISION PHEASANT RIDGE ESTATE SQ. FT. OF PROPOSED BLDG(S)/ADDITION 1251  
FILING \_\_\_\_\_ BLK 1 LOT 3 SQ. FT. OF EXISTING BLDG(S) \_\_\_\_\_  
(1) OWNER JUST COMPANIES, INC NO. OF DWELLING UNITS BEFORE: 0 AFTER: 1 THIS CONSTRUCTION  
(1) ADDRESS 826 2 1/2 RD  
(1) TELEPHONE 970-245-9316 NO. OF BLDGS ON PARCEL BEFORE: 0 AFTER: 1 THIS CONSTRUCTION  
(2) APPLICANT JUST COMPANIES, INC. USE OF EXISTING BLDGS \_\_\_\_\_  
(2) ADDRESS 826 2 1/2 RD DESCRIPTION OF WORK AND INTENDED USE: \_\_\_\_\_  
(2) TELEPHONE 970-245-9316 SINGLE FAMILY DETACHED RESIDENCE

**REQUIRED: One plot plan, on 8 1/2" x 11" paper, showing all existing & proposed structure location(s), parking, setbacks to all property lines, ingress/egress to the property, driveway location & width & all easements & rights-of-way which abut the parcel.**

**THIS SECTION TO BE COMPLETED BY COMMUNITY DEVELOPMENT DEPARTMENT STAFF**

ZONE PR-8 Maximum coverage of lot by structures \_\_\_\_\_  
SETBACKS: Front 20' from property line (PL) Parking Req'mt 2  
or \_\_\_\_\_ from center of ROW, whichever is greater  
Side 5' from PL Rear 15' from PL Special Conditions As per wldg envelope  
Maximum Height \_\_\_\_\_ CENSUS 1402 TRAFFIC 8 ANN# \_\_\_\_\_

Modifications to this Planning Clearance must be approved, in writing, by the Director of the Community Development Department. The structure authorized by this application cannot be occupied until a final inspection has been completed and a Certificate of Occupancy has been issued by the Building Department (Section 305, Uniform Building Code).

I hereby acknowledge that I have read this application and the information is correct; I agree to comply with any and all codes, ordinances, laws, regulations or restrictions which apply to the project. I understand that failure to comply shall result in legal action, which may include but not necessarily be limited to non-use of the building(s).

Applicant Signature Patricia Bowland Just Co Date 4/30/98  
Department Approval X. Valdez Date 4-30-98

Additional water and/or sewer tap fee(s) are required: YES  NO \_\_\_\_\_ W/O No. 11245

Utility Accounting [Signature] Date 4/30/98


VALID FOR SIX MONTHS FROM DATE OF ISSUANCE (Section 9-3-2C Grand Junction Zoning & Development Code)

(White: Planning) (Yellow: Customer) (Pink: Building Department) (Goldenrod: Utility Accounting)

ACCEPTED *XV 430-98*  
 ANY CHANGE OF SETBACKS MUST BE APPROVED BY THE CITY PLANNING DEPT. IT IS THE APPLICANT'S RESPONSIBILITY TO PROPERLY LOCATE AND IDENTIFY EASEMENTS AND PROPERTY LINES.

DRIVEWAY LOCATION? Need 10' FROM PROPERTY LINE OR 4-17-98

SEPARATION FROM ADJACENT OR *J. [Signature]*

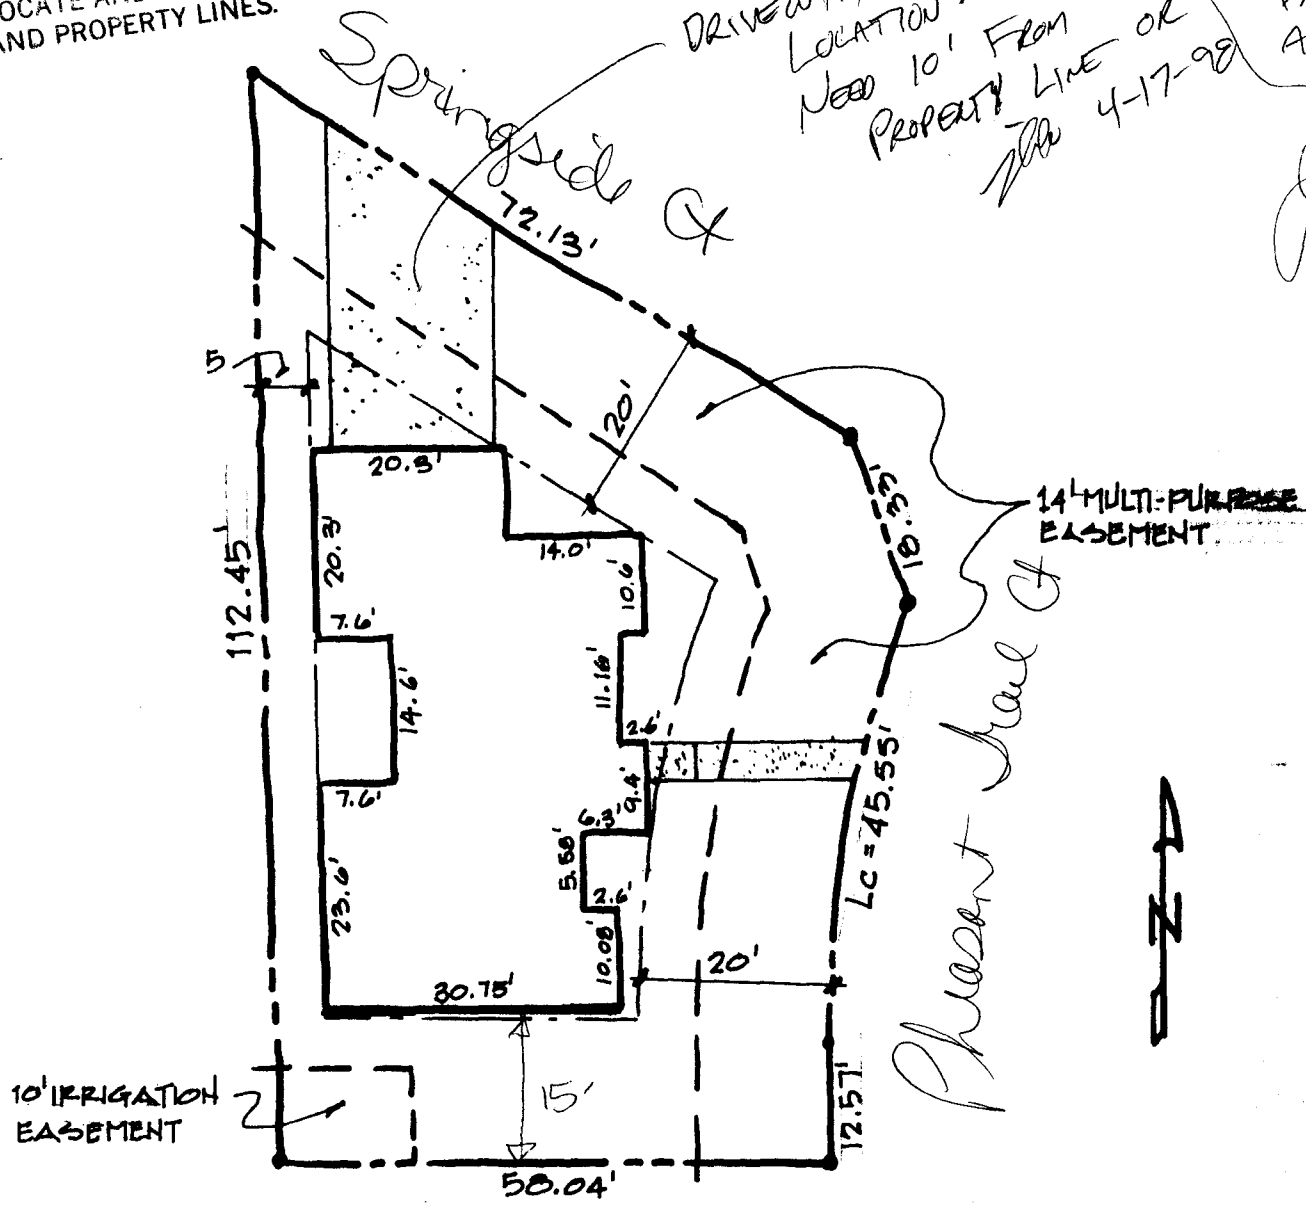

2385 SPRINGSIDE CT.  
PHEASANT RIDGE ESTATE  
 BLOCK 1 LOT 3  
PLOT PLAN  
 1" = 20'