

Planning \$ <u>500</u>	Drainage \$ <u>—</u>
TCP \$ <u>—</u>	School Impact \$ <u>—</u>

BLDG PERMIT NO. <u>63609</u>
FILE #

PLANNING CLEARANCE

(site plan review, multi-family development, non-residential development)
Grand Junction Community Development Department

** THIS SECTION TO BE COMPLETED BY APPLICANT **

BLDG ADDRESS <u>2800 SUNSTRAND WAY</u>	TAX SCHEDULE NO. <u>2701-361-38-001</u>
SUBDIVISION <u>CH Four Comm. PK.</u>	SQ. FT. OF PROPOSED BLDG(S)/ADDITION <u>360 SF</u>
FILING <u>2</u> BLK <u>—</u> LOT <u>1</u>	SQ. FT. OF EXISTING BLDG(S) <u>120,000 SF</u>
(1) OWNER <u>SUNSTRAND AREOSPACE</u>	NO. OF DWELLING UNITS BEFORE: <u>N/A</u> AFTER: _____ CONSTRUCTION
(1) ADDRESS <u>2800 SUNSTRAND WAY</u>	NO. OF BLDGS ON PARCEL BEFORE: <u>1</u> AFTER: _____ CONSTRUCTION
(1) TELEPHONE <u>248-8124</u>	USE OF ALL EXISTING BLDGS <u>INDUSTRIAL</u>
(2) APPLICANT <u>CENTRAL CONST</u>	DESCRIPTION OF WORK & INTENDED USE: <u>ADDITION</u>
(2) ADDRESS <u>535 GRAND AVE</u>	<u>TO MAIN BLDG 20'x18' METAL BLDG</u>
(2) TELEPHONE <u>263-0871</u>	<u>8'x11' (air compressor)</u>

✓ Submittal requirements are outlined in the SSID (Submitter Standards for Improvements and Development) document.

** THIS SECTION TO BE COMPLETED BY COMMUNITY DEVELOPMENT DEPARTMENT STAFF **

ZONE <u>PC</u>	Landscaping / Screening Required: YES _____ NO _____
SETBACKS: Front _____ from Property Line (PL) or _____ from center of ROW, whichever is greater	Parking Req't _____
Side _____ from PL Rear _____ from PL	Special Conditions: _____
Maximum Height _____	Genus Tract <u>16</u> Traffic Zone <u>15</u> Annx # _____

Modifications to this Planning Clearance must be approved, in writing, by the Community Development Department Director. The structure authorized by this application cannot be occupied until a final inspection has been completed and a Certificate of Occupancy has been issued by the Building Department (Section 307, Uniform Building Code). Required improvements in the public right-of-way must be guaranteed prior to issuance of a Planning Clearance. All other required site improvements must be completed or guaranteed prior to issuance of a Certificate of Occupancy. Any landscaping required by this permit shall be maintained in an acceptable and healthy condition. The replacement of any vegetation materials that die or are in an unhealthy condition is required by the G.J. Zoning and Development Code.


Four (4) sets of final construction drawings must be submitted and stamped by City Engineering prior to issuing the Planning Clearance. One stamped set must be available on the job site at all times.

I hereby acknowledge that I have read this application and the information is correct; I agree to comply with any and all codes, ordinances, laws, regulations, or restrictions which apply to the project. I understand that failure to comply shall result in legal action, which may include but not necessarily be limited to non-use of the building(s).

Applicant's Signature <u>[Signature]</u>	Date <u>JAN 21, 1998</u>
Department Approval <u>[Signature]</u>	Date <u>January 26, 1998</u>
Additional water and/or sewer tap fee(s) are required: YES _____ NO <u>✓</u> W/O No. <u>13874-8677</u>	
Utility Accounting <u>[Signature]</u>	Date <u>1-26-98</u>

VALID FOR SIX MONTHS FROM DATE OF ISSUANCE (Section 9-3-2C Grand Junction Zoning & Development Code)

(White: Planning) (Yellow: Customer) (Pink: Building Department) (Goldenrod: Utility Accounting)

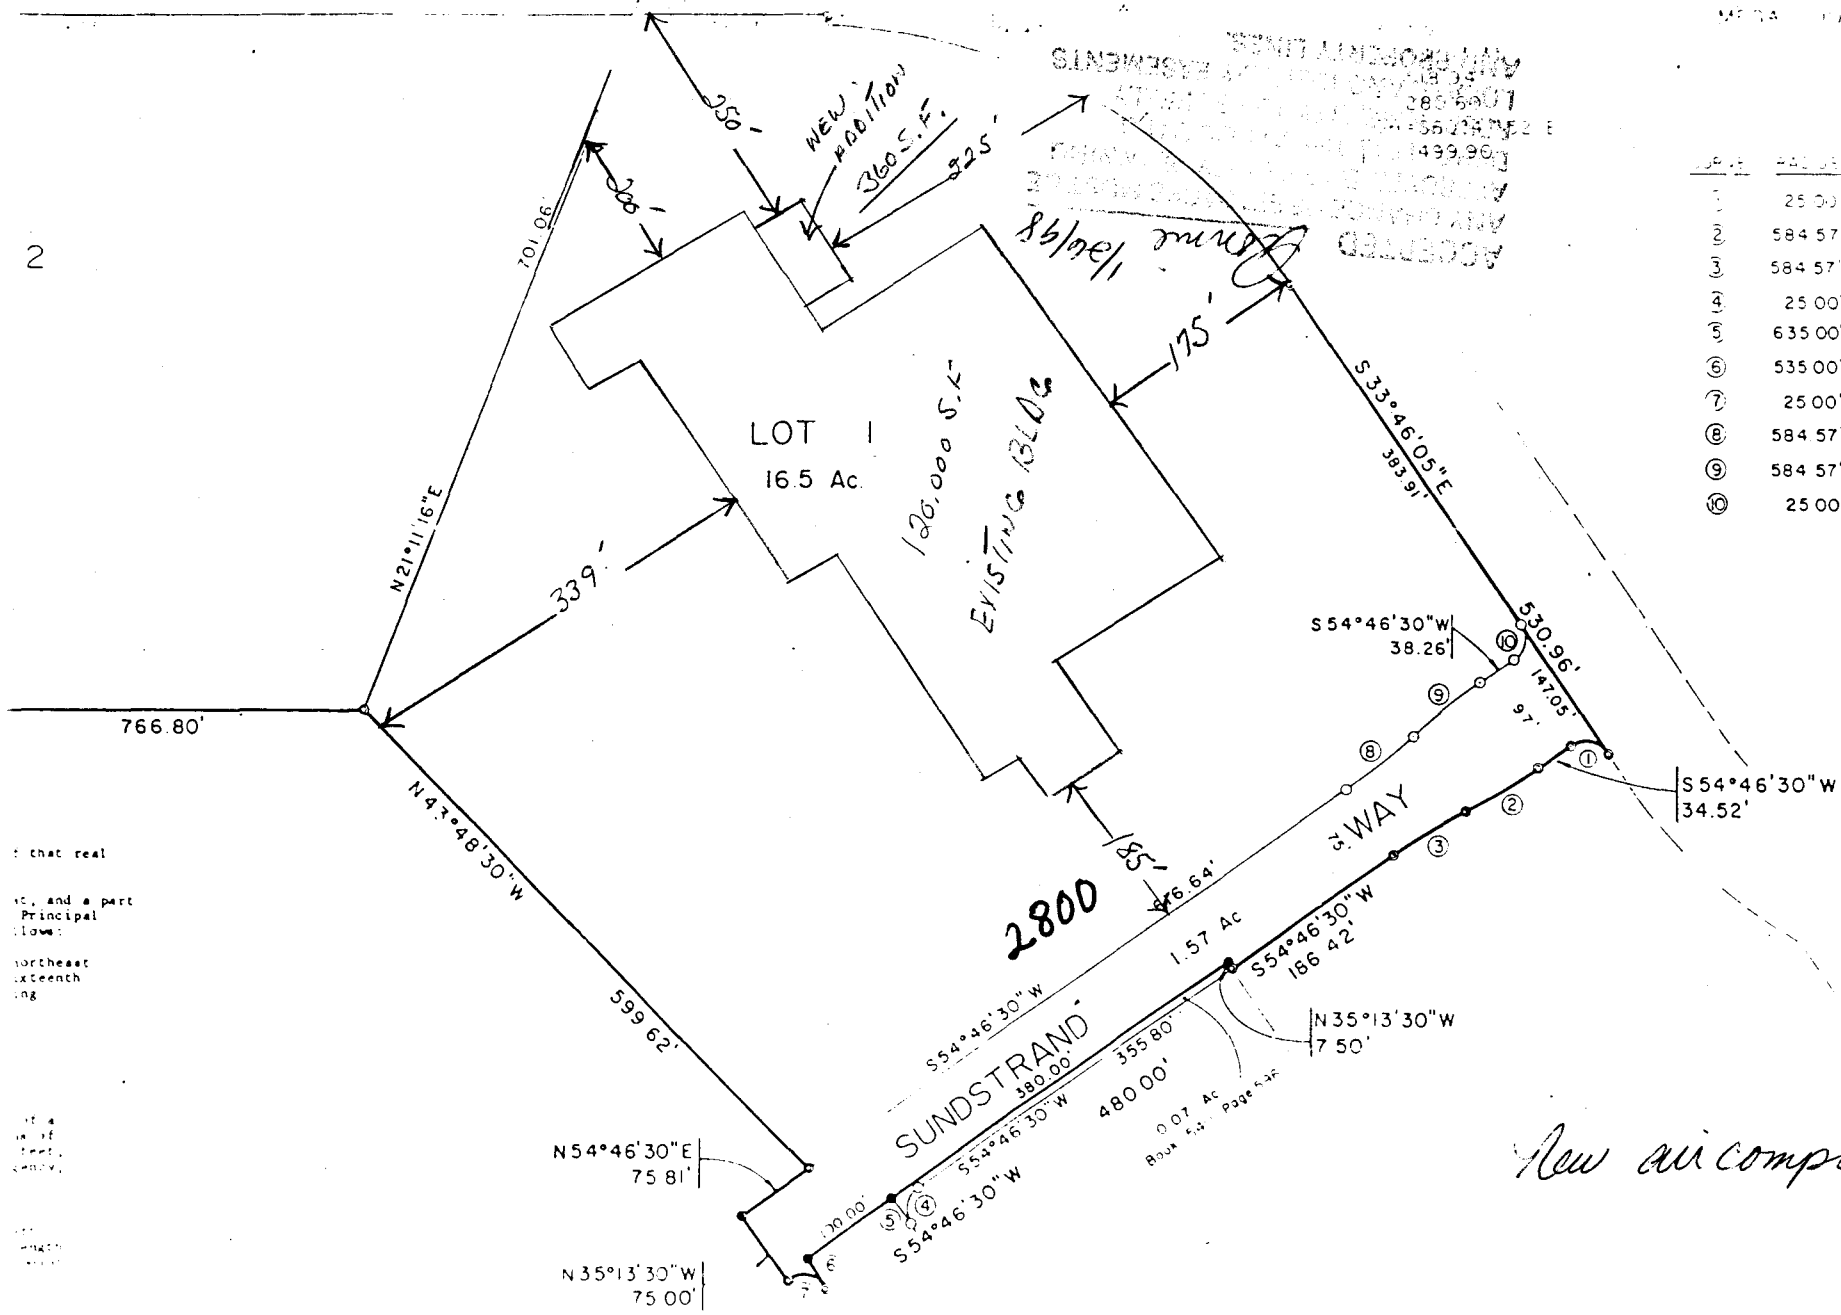

2

that real
and a part
Principal
flow:
southeast
sixteenth
ing

It a
of
feet
only

111
111111

SCALE



Existing Concrete Pad

10' Door

18'

Air Inlet

150 HP Air
Compressor

Proposed 20' by 18'
Air Compressor Room

20'

4' Door

Air
Dryer

Existing Air
Compressor Room

Boiler Room

