

Planning \$ <u>10⁰⁰</u>	Drainage \$ <u>—</u>
TCP \$ <u>—</u>	School Impact \$ <u>—</u>

BLDG PERMIT NO. <u>N/A</u>
FILE #

PLANNING CLEARANCE

(site plan review, multi-family development, non-residential development)

Grand Junction Community Development Department

THIS SECTION TO BE COMPLETED BY APPLICANT

BLDG ADDRESS <u>24 West Ave</u>	TAX SCHEDULE NO. <u>2945-154-19-945</u>
SUBDIVISION <u>Bower's</u>	SQ. FT. OF PROPOSED BLDG(S)/ADDITION <u>3x12</u>
FILING _____ BLK <u>9</u> LOT <u>4252 53-58</u>	SQ. FT. OF EXISTING BLDG(S) _____
(1) OWNER <u>City of Grand Junction</u>	NO. OF DWELLING UNITS BEFORE: _____ AFTER: _____ CONSTRUCTION
(1) ADDRESS <u>250 N. 5th St</u>	NO. OF BLDGS ON PARCEL BEFORE: _____ AFTER: _____ CONSTRUCTION
(1) TELEPHONE <u>244-1656</u>	USE OF ALL EXISTING BLDGS _____
(2) APPLICANT <u>Rocky Mt Head Start</u>	DESCRIPTION OF WORK & INTENDED USE: <u>8x12 Tool Shed</u>
(2) ADDRESS <u>255 N. 26th St</u>	
(2) TELEPHONE <u>243-9318</u>	

Submittal requirements are outlined in the SSID (Submittal Standards for Improvements and Development) document.

THIS SECTION TO BE COMPLETED BY COMMUNITY DEVELOPMENT DEPARTMENT STAFF

ZONE <u>PZ</u>	Landscaping / Screening Required: YES _____ NO _____
SETBACKS: Front <u>—</u> from Property Line (PL) or <u>40'</u> from center of ROW, whichever is greater	Parking Req'mt _____
Side <u>10'</u> from PL Rear <u>10'</u> from PL	Special Conditions: _____
Maximum Height <u>65'</u>	
Maximum coverage of lot by structures <u>—</u>	Census Tract <u>9</u> Traffic Zone <u>101</u> Annx # _____

Modifications to this Planning Clearance must be approved, in writing, by the Community Development Department Director. The structure authorized by this application cannot be occupied until a final inspection has been completed and a Certificate of Occupancy has been issued by the Building Department (Section 307, Uniform Building Code). Required improvements in the public right-of-way must be guaranteed prior to issuance of a Planning Clearance. All other required site improvements must be completed or guaranteed prior to issuance of a Certificate of Occupancy. Any landscaping required by this permit shall be maintained in an acceptable and healthy condition. The replacement of any vegetation materials that die or are in an unhealthy condition is required by the G.J. Zoning and Development Code.

Four (4) sets of final construction drawings must be submitted and stamped by City Engineering prior to issuing the Planning Clearance. One stamped set must be available on the job site at all times.

I hereby acknowledge that I have read this application and the information is correct; I agree to comply with any and all codes, ordinances, laws, regulations, or restrictions which apply to the project. I understand that failure to comply shall result in legal action, which may include but not necessarily be limited to non-use of the building(s).


Applicant's Signature <u>[Signature]</u>	Date <u>3/20/98</u>
Department Approval <u>[Signature]</u>	Date <u>3/20/98</u>
Additional water and/or sewer tap fee(s) are required: YES _____ NO <input checked="" type="checkbox"/> W/O No. _____	
Utility Accounting <u>[Signature]</u>	Date <u>3/20/98</u>

VALID FOR SIX MONTHS FROM DATE OF ISSUANCE (Section 9-3-2C Grand Junction Zoning & Development Code)

(White: Planning) (Yellow: Customer) (Pink: Building Department) (Goldenrod: Utility Accounting)

Scale 1" = 15'

Riverside Center

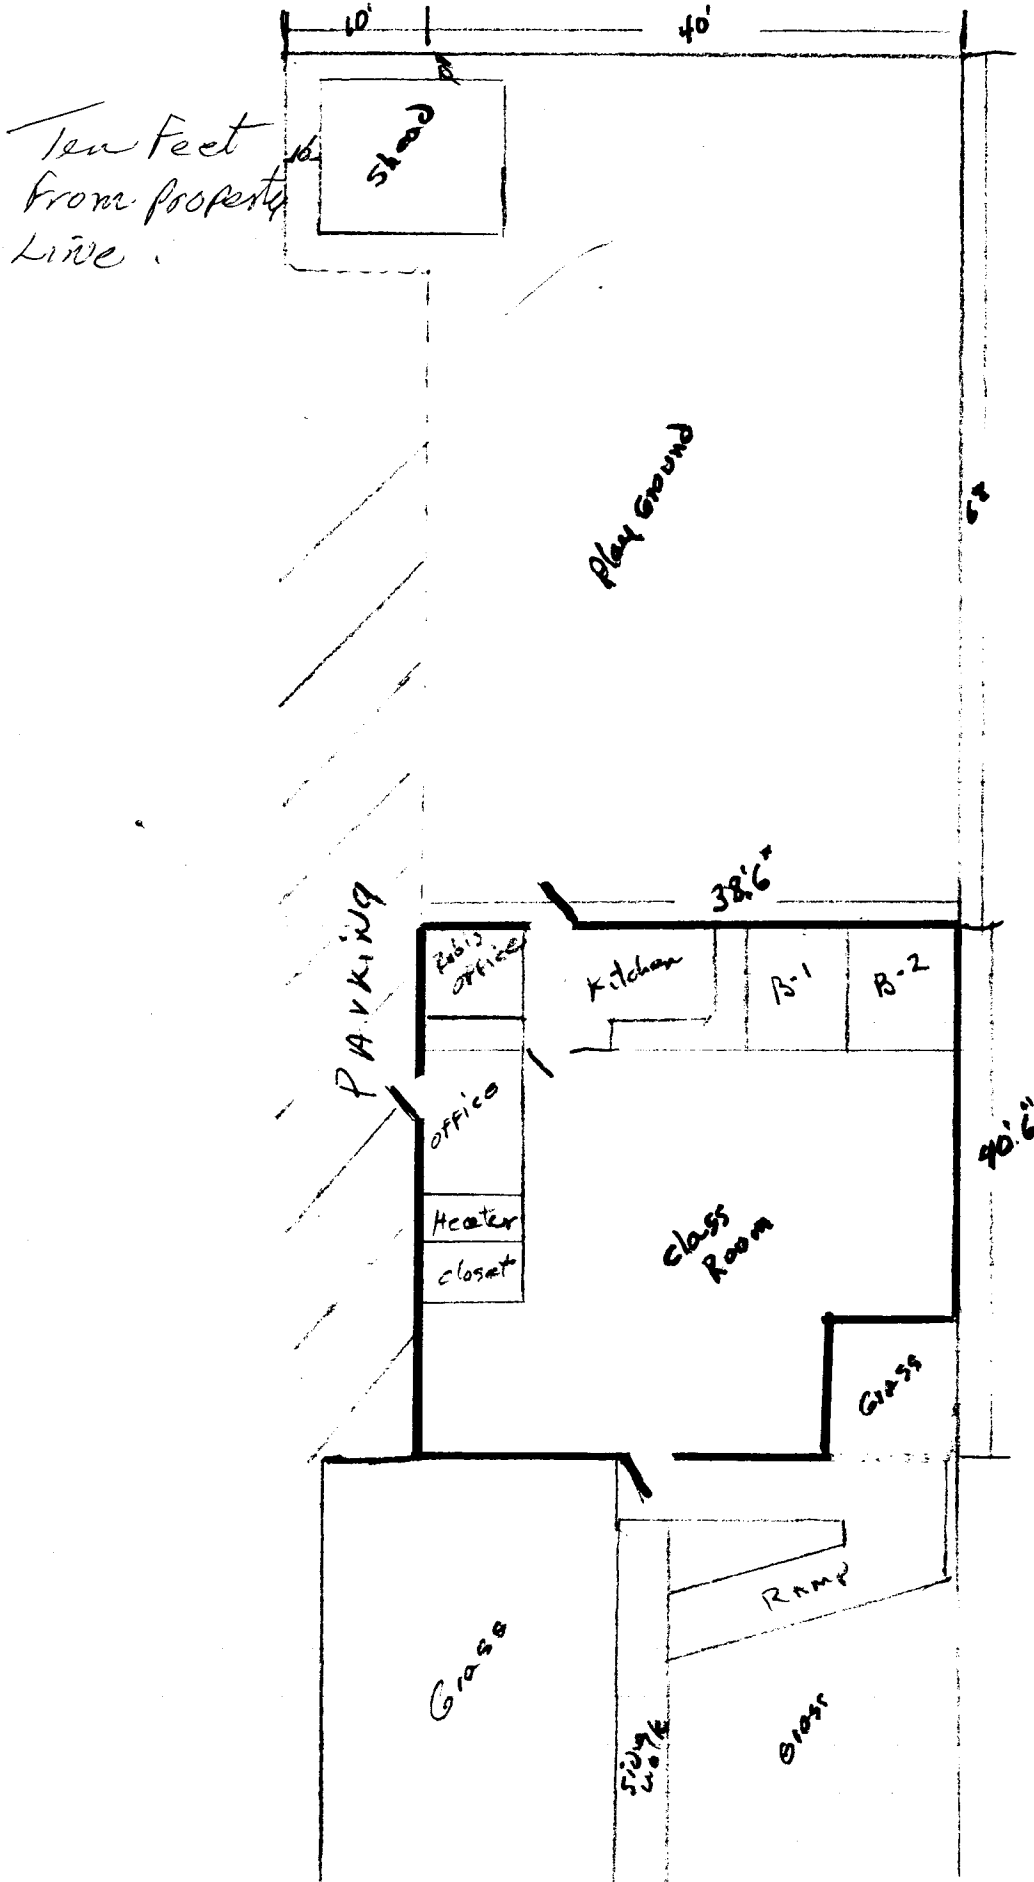

ACCEPTED 5/10/88
 ANY CHANGE OF SETBACKS MUST BE APPROVED BY THE CITY PLANNING DEPT. IT IS THE APPLICANT'S RESPONSIBILITY TO PROPERLY LOCATE AND IDENTIFY EASEMENTS AND PROPERTY LINES.

Kitchen 50 sq. ft.
 Classroom 900 sq. ft.
 Total 950 sq. ft.


Playground 2720 sq. ft.

Kitchen 50 sq. ft.
 Classroom
 Total

Playground - 2720 sq. ft.

Scale 1" = 15'

Riverside Center

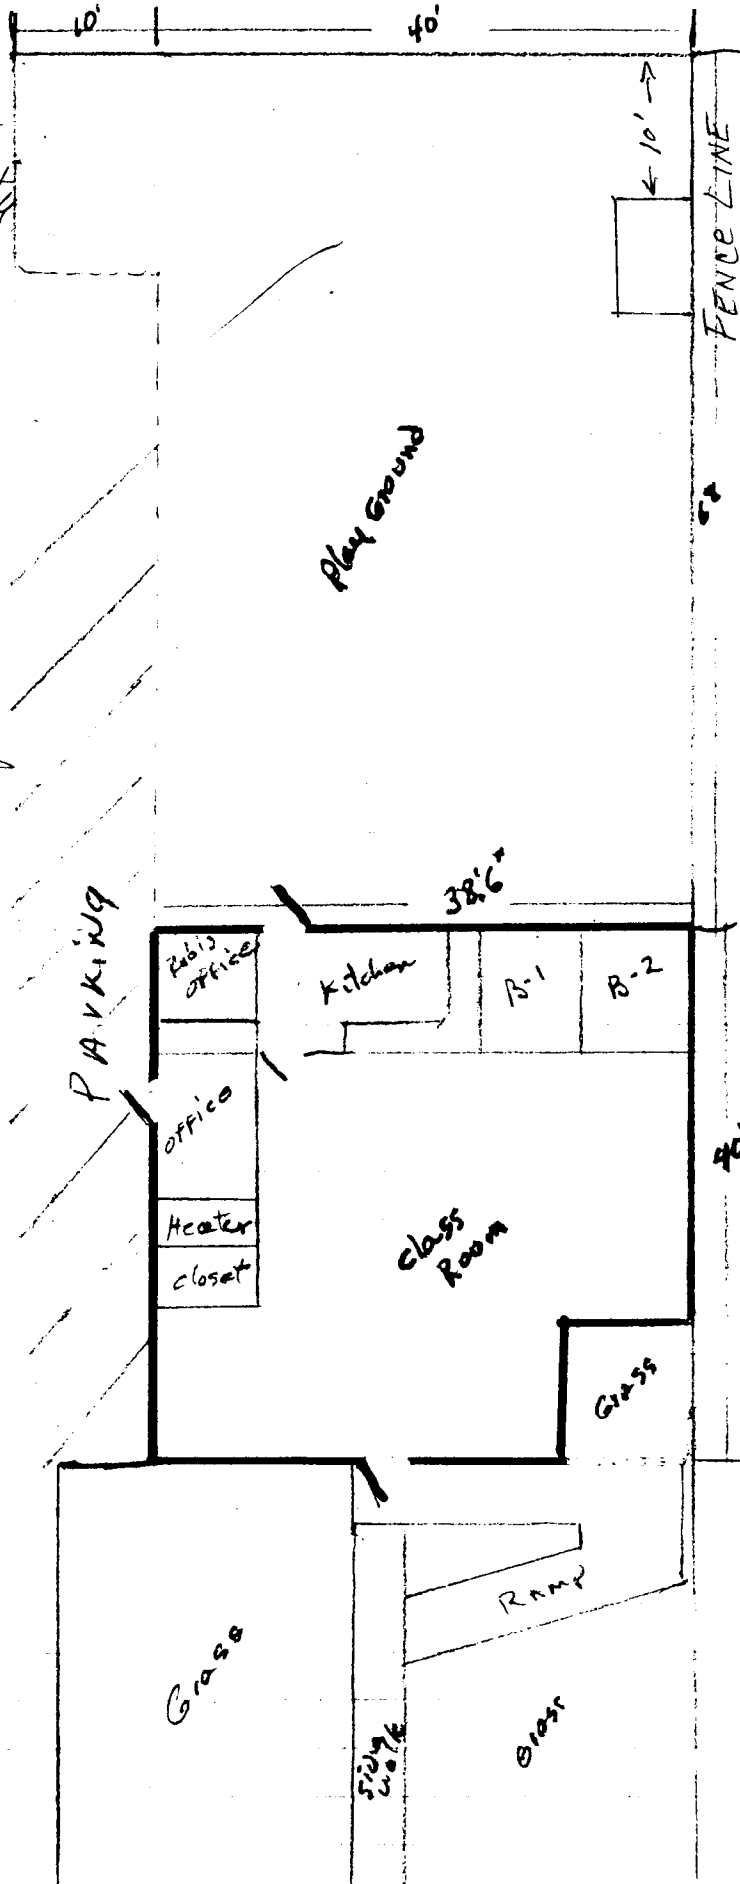

ten feet from property line

100' +/- to R.L.

ACCEPTED SL 3-24-98
 ANY CHANGE OF SETBACKS MUST BE APPROVED BY THE CITY PLANNING DEPT. IT IS THE APPLICANT'S RESPONSIBILITY TO PROPERLY LOCATE AND IDENTIFY EASEMENTS AND PROPERTY LINES.

Amended

ACCEPTED SL 3-24-98
 ANY CHANGE OF SETBACKS MUST BE APPROVED BY THE CITY PLANNING DEPT. IT IS THE APPLICANT'S RESPONSIBILITY TO PROPERLY LOCATE AND IDENTIFY EASEMENTS AND PROPERTY LINES.

- Kitchen 50 sq ft
- Class room 900 sq ft
- Total 950 sq ft
- Playground 2720 sq ft
- Kitchen 50 sq ft
- Class room
- Total
- Playground - 2720 sq ft