

Planning \$ <u>10</u> —	Drainage \$ —
TCP \$ —	School Impact \$ —

BLDG PERMIT NO. <u>63514</u>
FILE # _____

PLANNING CLEARANCE

(site plan review, multi-family development, non-residential development)

Grand Junction Community Development Department

** THIS SECTION TO BE COMPLETED BY APPLICANT **

BLDG ADDRESS <u>134 West Ave</u>	TAX SCHEDULE NO. <u>2945-154.19-945</u>
SUBDIVISION <u>Grand River</u>	SQ. FT. OF PROPOSED BLDG(S)/ADDITION <u>—</u>
FILING _____ BLK _____ LOT _____	SQ. FT. OF EXISTING BLDG(S) <u>1600 ±</u>
(1) OWNER <u>City of Grand Junction</u>	NO. OF DWELLING UNITS BEFORE: _____ AFTER: _____ CONSTRUCTION
(1) ADDRESS <u>250 N. 5th</u>	NO. OF BLDGS ON PARCEL BEFORE: <u>1</u> AFTER: <u>1</u> CONSTRUCTION
(1) TELEPHONE _____	USE OF ALL EXISTING BLDGS <u>headstart</u>
(2) APPLICANT <u>Headstart</u>	DESCRIPTION OF WORK & INTENDED USE: <u>Handy cap</u>
(2) ADDRESS <u>835 N 26 St.</u>	<u>Ramp.</u>
(2) TELEPHONE <u>243-9318</u>	

✓ Submittal requirements are outlined in the SSID (Submittal Standards for Improvements and Development) document.

** THIS SECTION TO BE COMPLETED BY COMMUNITY DEVELOPMENT DEPARTMENT STAFF **

ZONE <u>PZ</u>	Landscaping / Screening Required: YES _____ NO _____
SETBACKS: Front _____ from Property Line (PL) or _____ from center of ROW, whichever is greater	Parking Req'mt _____
Side <u>3'</u> from PL Rear <u>3'</u> from PL	Special Conditions: <u>Ramp cannot be closer than 3' to property lines</u>
Maximum Height _____	Genusus Tract <u>9</u> Traffic Zone <u>101</u> Annx # _____

Modifications to this Planning Clearance must be approved, in writing, by the Community Development Department Director. The structure authorized by this application cannot be occupied until a final inspection has been completed and a Certificate of Occupancy has been issued by the Building Department (Section 307, Uniform Building Code). Required improvements in the public right-of-way must be guaranteed prior to issuance of a Planning Clearance. All other required site improvements must be completed or guaranteed prior to issuance of a Certificate of Occupancy. Any landscaping required by this permit shall be maintained in an acceptable and healthy condition. The replacement of any vegetation materials that die or are in an unhealthy condition is required by the G.J. Zoning and Development Code.


Four (4) sets of final construction drawings must be submitted and stamped by City Engineering prior to issuing the Planning Clearance. One stamped set must be available on the job site at all times.

I hereby acknowledge that I have read this application and the information is correct; I agree to comply with any and all codes, ordinances, laws, regulations, or restrictions which apply to the project. I understand that failure to comply shall result in legal action, which may include but not necessarily be limited to non-use of the building(s).

Applicant's Signature <u>[Signature]</u>	Date <u>1/5/98</u>
Department Approval <u>[Signature]</u> (KA)	Date <u>1-5-98</u>
Additional water and/or sewer tap fee(s) are required: YES _____ NO <input checked="" type="checkbox"/> W/O No. <u>No Charge</u>	
Utility Accounting <u>[Signature]</u>	Date <u>1/5/98</u>

VALID FOR SIX MONTHS FROM DATE OF ISSUANCE (Section 9-3-2C Grand Junction Zoning & Development Code)

(White: Planning) (Yellow: Customer) (Pink: Building Department) (Goldenrod: Utility Accounting)

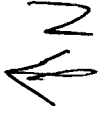

Entrance
36"

HAND rail

LANDING


10'

36"

LANDING

1/4" = 1 Ft.

side walk

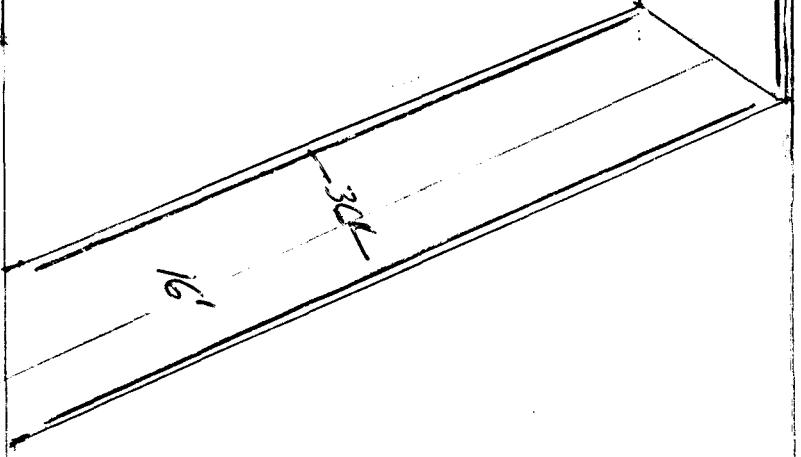

Riverside Ramp

Chain Link Fence

ACCEPTED SLC per KA 1-5-98
ANY CHANGE OF SETBACKS MUST BE
APPROVED BY THE CITY PLANNING
DEPT. IT IS THE APPLICANT'S
RESPONSIBILITY TO PROPERLY
LOCATE AND IDENTIFY EASEMENTS
AND PROPERTY LINES.

West Ave