

Planning \$ <u>5.00</u>	Drainage \$ <u>—</u>
TCP \$ <u>—</u>	School Impact \$ <u>—</u>

BLDG PERMIT NO. <u>72772</u>
FILE #

PLANNING CLEARANCE

(site plan review, multi-family development, non-residential development)

Grand Junction Community Development Department

THIS SECTION TO BE COMPLETED BY APPLICANT

BUILDING ADDRESS <u>225 N. 5th St. 3rd Floor</u>	TAX SCHEDULE NO. <u>2945-143-09-010</u>
SUBDIVISION <u>—</u>	SQ. FT. OF PROPOSED BLDG(S)/ADDITION <u>960</u>
FILING _____ BLK _____ LOT _____	SQ. FT OF EXISTING BLDG(S) <u>960</u>
OWNER <u>Alpine Bank of Bryce Co.</u>	NO. OF DWELLING UNITS: BEFORE <u>0</u> AFTER <u>0</u>
ADDRESS <u>225 N. 5th St. G.J. 81501</u>	CONSTRUCTION _____
TELEPHONE <u>970-243-5060</u>	NO. OF BLDGS ON PARCEL: BEFORE <u>1</u> AFTER <u>1</u>
APPLICANT <u>Sun King</u>	CONSTRUCTION _____
ADDRESS <u>P.O. Box 3299 G.J. 81502</u>	USE OF ALL EXISTING BLDGS _____
TELEPHONE <u>970-245-9173</u>	DESCRIPTION OF WORK & INTENDED USE: <u>Moving</u>
<input checked="" type="checkbox"/> Submittal requirements are outlined in the SSID (Submittal Standards for Improvements and Development) document.	<u>walls & office space.</u>
	<u>all interior-no add sewer.</u>

THIS SECTION TO BE COMPLETED BY COMMUNITY DEVELOPMENT DEPARTMENT STAFF

ZONE <u>B-3</u>	LANDSCAPING/SCREENING REQUIRED: YES _____ NO <u>X</u>
SETBACKS: FRONT: _____ from Property Line (PL) or _____ from center of ROW, whichever is greater	PARKING REQUIREMENT: _____
SIDE: _____ from PL REAR: _____ from PL	SPECIAL CONDITIONS: <u>Interior Remodel only.</u>
MAXIMUM HEIGHT _____	<u>(no change in use)</u>
MAXIMUM COVERAGE OF LOT BY STRUCTURES _____	CENSUS TRACT <u>6</u> TRAFFIC ZONE <u>31</u> ANNEX _____

Modifications to this Planning Clearance must be approved, in writing, by the Community Development Department Director. The structure authorized by this application cannot be occupied until a final inspection has been completed and a Certificate of Occupancy has been issued by the Building Department (Section 307, Uniform Building Code). Required improvements in the public right-of-way must be guaranteed prior to issuance of a Planning Clearance. All other required site improvements must be completed or guaranteed prior to issuance of a Certificate of Occupancy. Any landscaping required by this permit shall be maintained in an acceptable and healthy condition. The replacement of any vegetation materials that die or are in an unhealthy condition is required by the Grand Junction Zoning and Development Code.

Four (4) sets of final construction drawings must be submitted and stamped by City Engineering prior to issuing the Planning Clearance. One stamped set must be available on the job site at all times.


I hereby acknowledge that I have read this application and the information is correct; I agree to comply with any and all codes, ordinances, laws, regulations, or restrictions which apply to the project. I understand that failure to comply shall result in legal action, which may include but not necessarily be limited to non-use of the building(s).

Applicant's Signature <u>[Signature]</u>	Date <u>11-8-99</u>
Department Approval <u>Ronnie Edwards</u>	Date <u>11-8-99</u>

Additional water and/or sewer tap fee(s) are required:	YES	NO <input checked="" type="checkbox"/>	W/O No. _____
Utility Accounting <u>[Signature]</u>	Date <u>11/8/99</u>		

VALID FOR SIX MONTHS FROM DATE OF ISSUANCE (Section 9-3-2C Grand Junction Zoning and Development Code)

(White: Planning) (Yellow: Customer) (Pink: Building Department) (Goldenrod: Utility Accounting)

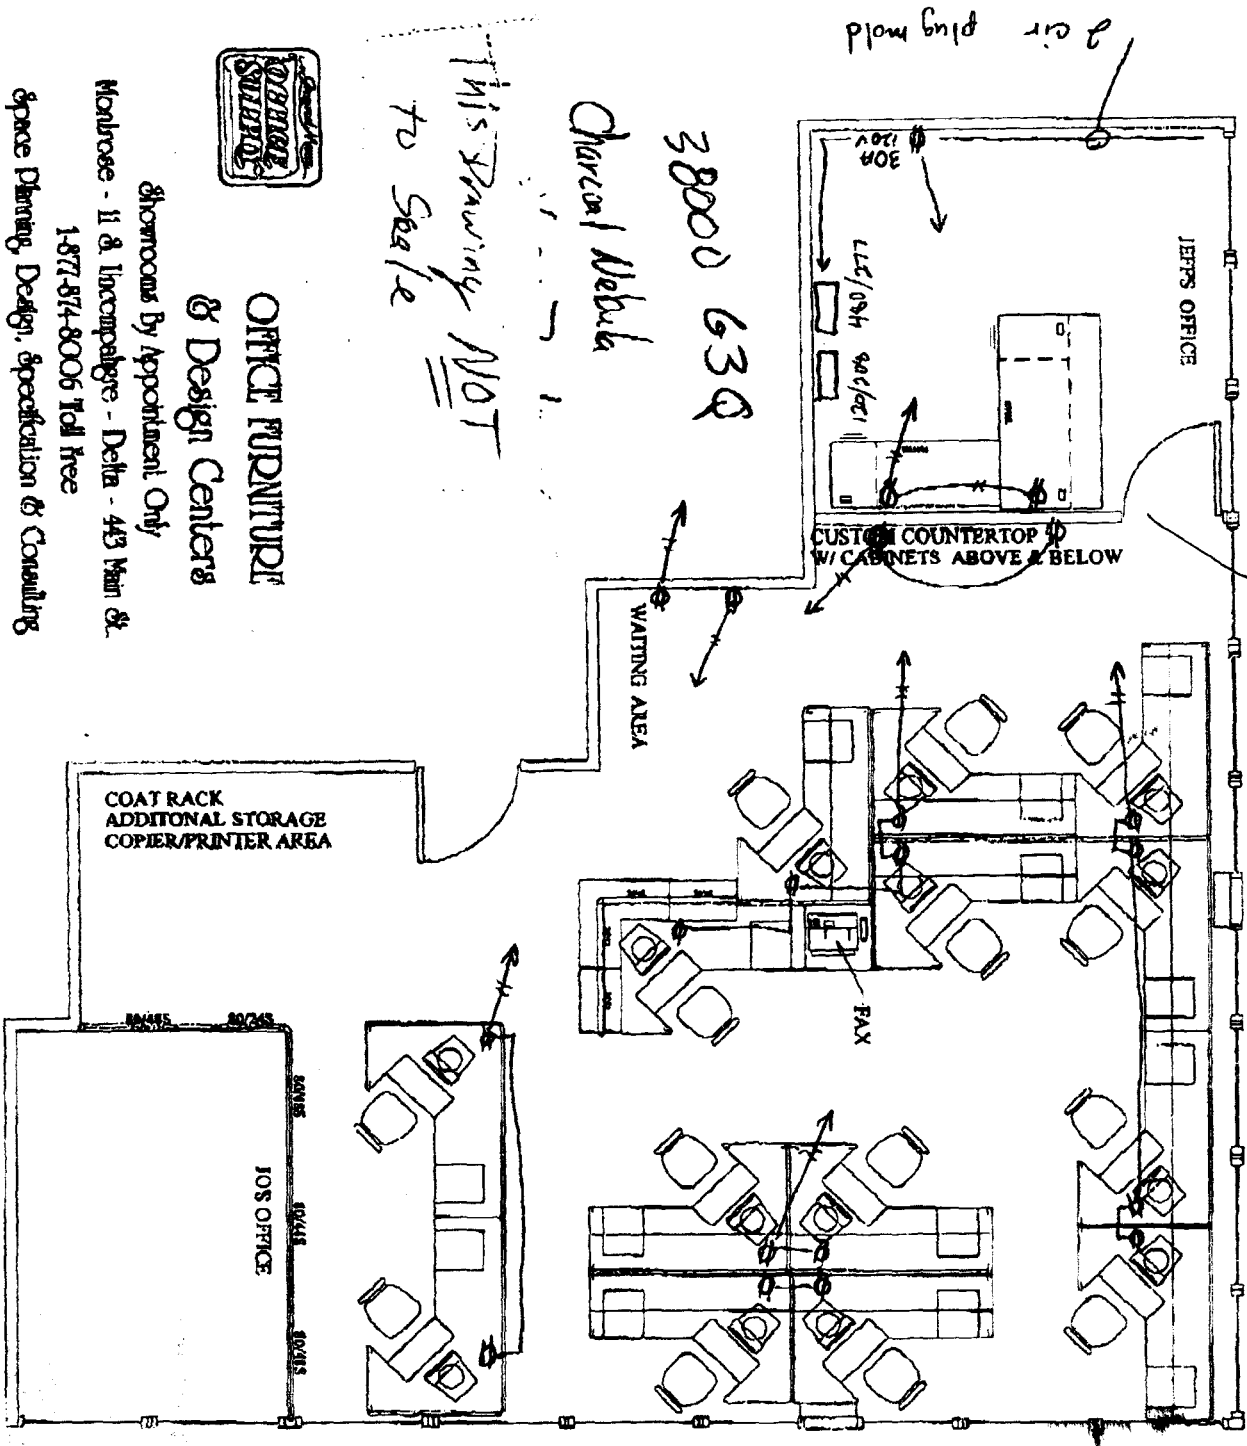

This Drawing NOT to Scale

*38000 630
Charcoal Nebula*

Moving wall back.

3rd floor



**OFFICE FURNITURE
& Design Centers**
Showrooms By Appointment Only
Montrose - 11 & Uncompahgre - Delta - 443 Main St.
1-877-874-8006 Toll Free
Space Planning, Design, Specification & Consulting

Mike Oregon 1/8

*From District @ DSA Electric
ATTN Steve*

*225 N. 5th St
Alpine Bank*