

FEE \$	—
TCP \$	—
SIF \$	292

up unit A

PLANNING CLEARANCE

(Single Family Residential and Accessory Structures)

Community Development Department

BLDG PERMIT NO. 73337



Your Bridge to a Better Community

BLDG ADDRESS 658 B LAREDO CT SQ. FT. OF PROPOSED BLDGS/ADDITION 1027 ~~φ~~

TAX SCHEDULE NO. 7445-032-0-130 SQ. FT. OF EXISTING BLDGS 2

SUBDIVISION WESTWOOD RAVENH TOTAL SQ. FT. OF EXISTING & PROPOSED 1027 ~~φ~~

FILING 2 BLK 1 LOT 2B NO. OF DWELLING UNITS:
 Before: 2 After: 1 this Construction
 NO. OF BUILDINGS ON PARCEL
 Before: 2 After: 1 this Construction

(1) OWNER Lee Hones USE OF EXISTING BUILDINGS 2

(1) ADDRESS 2755 N AVE DESCRIPTION OF WORK & INTENDED USE new Residence

(1) TELEPHONE 248-4612 TYPE OF HOME PROPOSED:
 Site Built Manufactured Home (UBC)
 Manufactured Home (HUD)
 Other (please specify) _____

(2) APPLICANT Lee Hones

(2) ADDRESS 2755 N Ave

(2) TELEPHONE 248-4612

REQUIRED: One plot plan, on 8 1/2" x 11" paper, showing all existing & proposed structure location(s), parking, setbacks to all property lines, ingress/egress to the property, driveway location & width & all easements & rights-of-way which abut the parcel.

THIS SECTION TO BE COMPLETED BY COMMUNITY DEVELOPMENT DEPARTMENT STAFF

ZONE FR4.3 Maximum coverage of lot by structures 40%

SETBACKS: Front 20' from property line (PL) Permanent Foundation Required: YES ___ NO ___
 or ___ from center of ROW, whichever is greater

Side 7' from PL, Rear 15' from PL Parking Req'mt _____

Maximum Height 32' Special Conditions _____

CENSUS _____ TRAFFIC _____ ANN# _____

Modifications to this Planning Clearance must be approved, in writing, by the Community Development Department. The structure authorized by this application cannot be occupied until a final inspection has been completed and a Certificate of Occupancy has been issued, if applicable, by the Building Department (Section 305, Uniform Building Code).

I hereby acknowledge that I have read this application and the information is correct; I agree to comply with any and all codes, ordinances, laws, regulations or restrictions which apply to the project. I understand that failure to comply shall result in legal action, which may include but not necessarily be limited to non-use of the building(s).

Applicant Signature [Signature] Date 21 Dec 99

Department Approval Ronnie Edwards Date 12-22-99


Additional water and/or sewer tap fee(s) are required:	YES	NO <input checked="" type="checkbox"/>	W/O No. <u>12748</u>
Utility Accounting <u>Rottie Vanover</u>		Date <u>12/22/99</u>	<u>12749</u>

VALID FOR SIX MONTHS FROM DATE OF ISSUANCE (Section 9-3-2C Grand Junction Zoning & Development Code)

(White: Planning) (Yellow: Customer) (Pink: Building Department) (Goldenrod: Utility Accounting)

WESTWOOD RANCH SUBDIVISION
FILING NO. TWO

ACCEPTED *Ronnie 12/22/99*
ANY CHANGE OF SETBACKS MUST BE
APPROVED BY THE CITY PLANNING
DEPT. IT IS THE APPLICANT'S
RESPONSIBILITY TO PROPERLY
LOCATE AND IDENTIFY EASEMENTS
AND PROPERTY LINES.

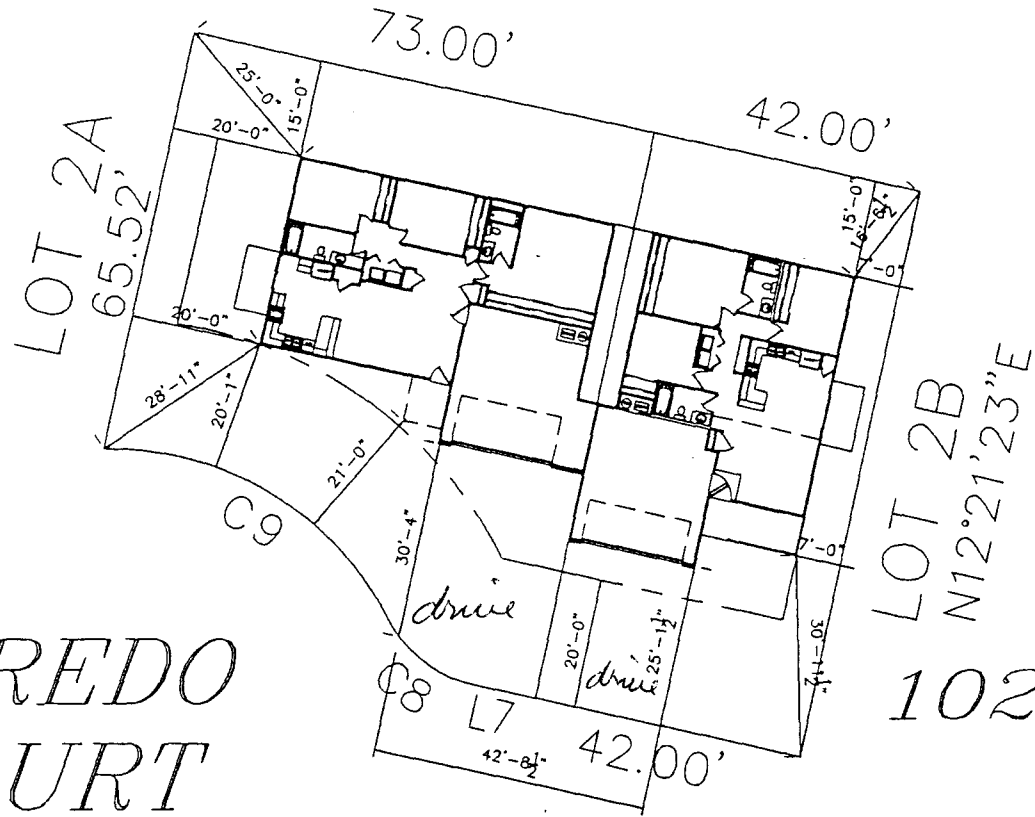

1229 SF

LOT 2B
N12°21'23"E
1027 SF

LAREDO
COURT

BLOCK 1 - LOT 2

658 B

12-21-99
North Drive OK
Rich Davis