

FEE \$	10.00
TCP \$	0
SIF \$	292.00



BLDG PERMIT NO. 70974

PLANNING CLEARANCE
(Single Family Residential and Accessory Structures)
Community Development Department

BLDG ADDRESS 681 Moonrise Court TAX SCHEDULE NO. 2945-031-67-003
 SUBDIVISION MOONRISE EAST SQ. FT. OF PROPOSED BLDG(S)/ADDITION 1479
 FILING BLK _____ LOT 3 SQ. FT. OF EXISTING BLDG(S) N/A
 (1) OWNER Grand Ridge Properties NO. OF DWELLING UNITS
 BEFORE: 0 AFTER: 1 THIS CONSTRUCTION
 (1) ADDRESS 3032 1-70 Bus Loop
 NO. OF BLDGS ON PARCEL
 BEFORE: 0 AFTER: 1 THIS CONSTRUCTION
 (1) TELEPHONE 434-4616
 USE OF EXISTING BLDGS N/A
 (2) APPLICANT Great Services
 (2) ADDRESS 3032 1-70 Bus Loop DESCRIPTION OF WORK AND INTENDED USE:
 (2) TELEPHONE 434-4616 Single family residence

REQUIRED: One plot plan, on 8 1/2" x 11" paper, showing all existing & proposed structure location(s), parking, setbacks to all property lines, ingress/egress to the property, driveway location & width & all easements & rights-of-way which abut the parcel.

THIS SECTION TO BE COMPLETED BY COMMUNITY DEVELOPMENT DEPARTMENT STAFF

ZONE RSF-4 Maximum coverage of lot by structures _____
 SETBACKS: Front 23' from property line (PL) Parking Req'mt _____
 or _____ from center of ROW, whichever is greater Special Conditions _____
 Side 7' from PL Rear 30' from PL
 Maximum Height _____ CENSUS 10 TRAFFIC 19 ANN# _____

Modifications to this Planning Clearance must be approved, in writing, by the Community Development Department. The structure authorized by this application cannot be occupied until a final inspection has been completed and a Certificate of Occupancy has been issued, if applicable, by the Building Department (Section 305, Uniform Building Code).

I hereby acknowledge that I have read this application and the information is correct; I agree to comply with any and all codes, ordinances, laws, regulations or restrictions which apply to the project. I understand that failure to comply shall result in legal action, which may include but not necessarily be limited to non-use of the building(s).

Applicant Signature [Signature] Date 6/24/99
 Department Approval Ronnie Edwards Date 6/25/99

Additional water and/or sewer tap fee(s) are required: YES NO _____ W/O No. 12402


Utility Accounting [Signature] Date 6/28/99

VALID FOR SIX MONTHS FROM DATE OF ISSUANCE (Section 9-3-2C Grand Junction Zoning & Development Code)

(White: Planning) (Yellow: Customer) (Pink: Building Department) (Goldenrod: Utility Accounting)

25 1/2 ROAD

5' ADDITIONAL RIGHT OF WAY

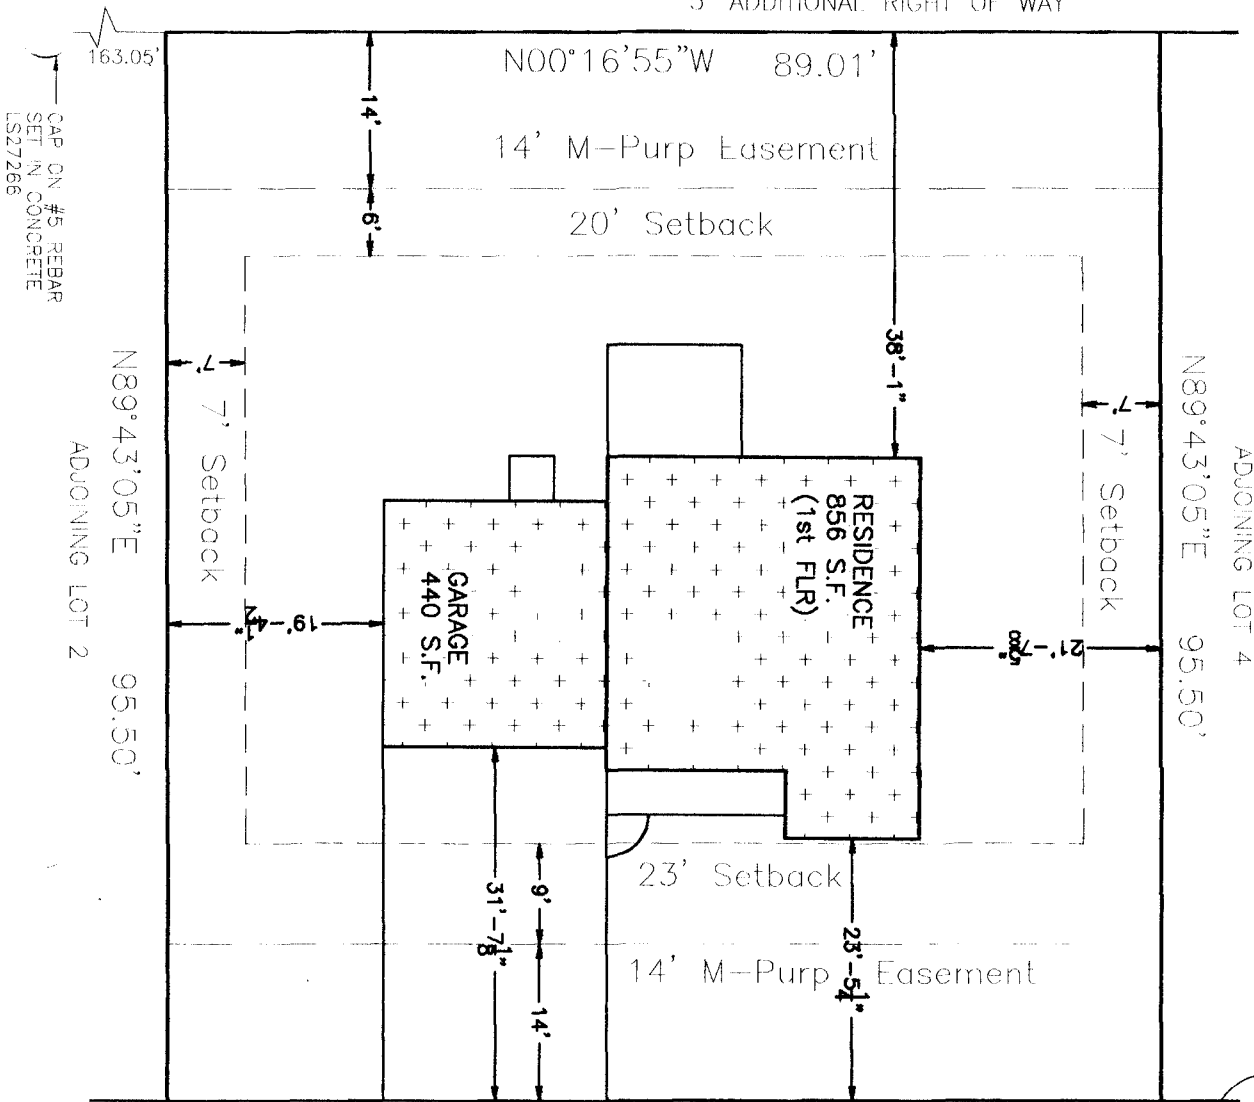


CAP ON #5 REBAR
SET IN CONCRETE
LS27266

681 MOONRISE COURT

Ronnie 6/25/99

PROPERTY RECORDS MUST BE
MAINTAINED AND PLANNING
COMMISSIONERS MUST
PROPERLY
LOCATE AND IDENTIFY EASEMENTS
AND PROPERTY LINES.

*6/25/99
DRIVE O.K.
Kw/Am*

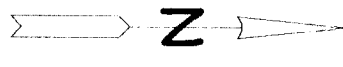

MOONRISE EAST
LOT 3
BLDG HT=21.58'