FEE\$	10
TCP\$	Ð
SIF \$	A -




BLDG PERMIT NO.

PLANNING CLEARANCE
(Single Family Residential and Accessory Structures)

Community Development Department

BLDG ADDRESS 2215 Radluga	TAX SCHEDULE NO. 2945-193-07-016	
SUBDIVISION Monument Valley	SQ. FT. OF PROPOSED BLDG(S)/ADDITION	
FILING BLK SELOT	SQ. FT. OF EXISTING BLDG(S)	
(1) OWNER Larry Osterburg	NO. OF DWELLING UNITS  BEFORE: (2) AFTER: 1 THIS CONSTRUCTION	
(1) ADDRESS 1128 Perch backe Rd	Wi 54521 NO. OF BLDGS ON PARCEL	
TTELEPHONE 715-477-1146	BEFORE: O AFTER: THIS CONSTRUCTION	
(2) APPLICANT Manes Const. Inc	USE OF EXISTING BLDGS Starte Forth Res	
(2) ADDRESS 1813 L. W. Fruk G. PISY	DESCRIPTION OF WORK AND INTENDED USE:	
(2) TELEPHONE 858-9642 -250-0441	Single Jamily Res	
	all existing & proposed structure location(s), parking, setbacks to all cation & width & all easements & rights-of-way which abut the parcel.	
THIS SECTION TO BE COMPLETED BY CO	DMMUNITY DEVELOPMENT DEPARTMENT STAFF 🖘	
ZONE	Maximum coverage of lot by structures	
SETBACKS: Front from property line (PL) or from center of ROW, whichever is greater	Parking Req'mt	
Side 35 from PL Rear 35 from P	Special Conditions DRIVEWay Permit region	
Maximum Height	CENSUS TRAFFIC ANNX#	
Modifications to this Planning Clearance must be approved, in writing, by the Community Development Department. The structure authorized by this application cannot be occupied until a final inspection has been completed and a Certificate of Occupancy has been issued, if applicable, by the Building Department (Section 305, Uniform Building Code).		
	the information is correct; I agree to comply with any and all codes, to the project. I understand that failure to comply shall result in legal to non-use of the building(s).	
Applicant Signature Waw Move	Date 3 2-99	
Department Approval Justo Hoth	16 Date 3-5-99	
Additional water and/or sewer tap fee(s) are required: Y	ES _NO W/O NO. # 11998 TR 88895	
Utility Accounting  VALID FOR SIX MONTHS FROM DATE OF ISSUANCE	Date 3-5-99 (Section 9-3-2C Grand Junction Zoning & Development Code)	
	nk: Building Department) (Goldenrod: Utility Accounting)	

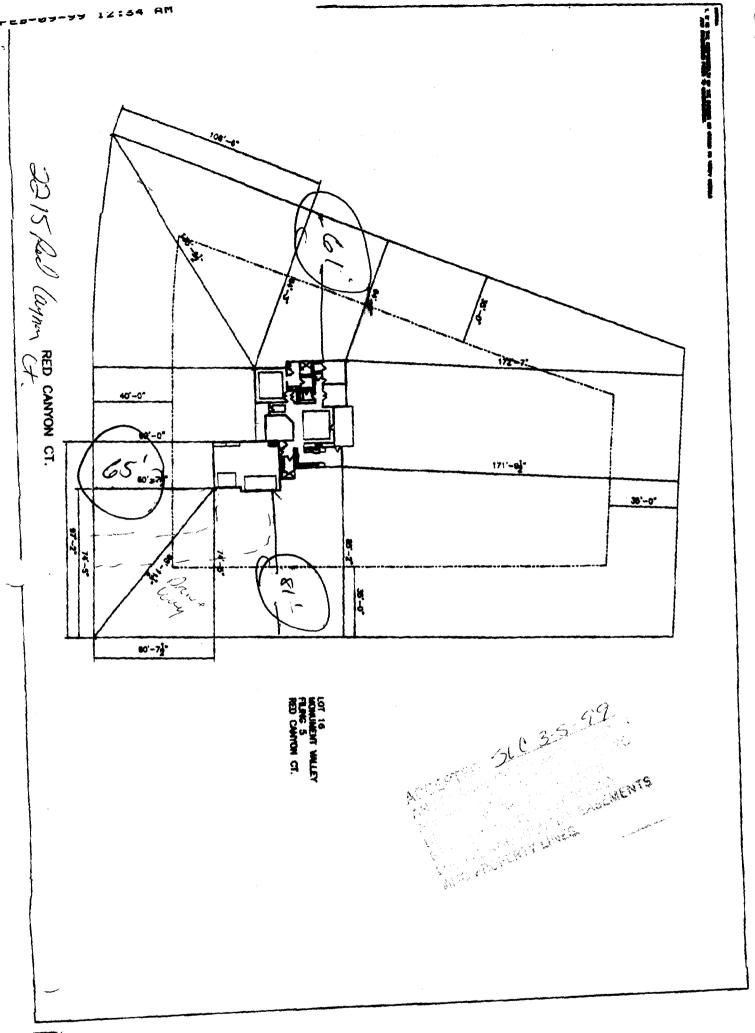

## PERMIT FOR ACCESS OR SURFACE ALTERATION WITHIN PUBLIC RIGHT OF WAY

y Distribution Mite-Contractor Canary-Office File Green-Inspector Pink-Street Supt

## CITY OF GRAND JUNCTION 250 North Fifth Street Grand Junction, CO 81501

Department of Public Works Engineering Division Phone (970) 244-1555 Fax (970) 244-1599

6033

	0000	
Application For: Access Surface Alteration	Responsible Charge	
mpany Mares Const.  General Contractor 2980/96  Concrete Curbing/Sidewalk License No.  Address 1813 L NJ	In accepting this permit the undersigned, representing the Permittee, verifies that he has read and understands all the provisions and requirements of this permit; that he has authority to sign for and bind the Permittee; and by virtue of his signature the Permittee is bound by and agrees to comply with all City ordinances, standards and specifications regulating construction.	
City Fruite State Co Zip Code 8152/	Responsible, Construction Supervisor Phone No.	
Application Date $3-2-99$ Date Work to Begin $3-5-99$	Responsible Construction Supervisor  Phone No.  Alternate Responsible Person  Phone No.  Phone No.	
Date Work to Begin	After Working Hours Contact Phone No.	
Job Address or Location 2215 Red Caynon Ct.	Type of Performance/Warrantee Guarantee	
Type of Work 1 Remove Existing 2 Repair Existing 3 Replace	Existing 4 New Installation If Utility Work	
1234       Sanitary Sewer       1234       Irrigation       1234       D         1234       Storm Sewer       1234       Curb & Gutter       1234       To         1234       Water       1234       Sidewalk       1234       C	elephone	
Estimated	Quantities	
Curb, Gutter & SidewalkLineal Feet	Sidewalk Crossing Drain Each	
Curb & GutterLineal Feet	Storm Drain Inlet Each	
SidewalkLineal Feet	Asphalt PavementSquare Yards	
Driveway SectionSquare Yards	Concrete Pavement Square Yards	
in PanLineal Feet	Pipe size, type, length 12 2014 Lineal Feet	
Execution Volume Cubic Yards	Other	
Requirements	leted By City) <u>Testing Requirements</u> •	
Yes No Performance Guaranty	Backfill Compaction Test(s) AASHTO T-99	
Traffic Control Plan	Roadbase Compaction Test(s) AASHTO T-180	
Pedestrian Safety Plan	Bituminous Pavement Compaction Test(s) AASHTO T-230	
Inspection of Concrete Forms & Base	Concrete Slump/Air Test(s) AASHTO T-119, T-152	
Inspection of Facilities Prior to Back-Fill		
	Concrete Compressive Strength AASHTO T-22, T-23	
Inspection of Subgrade After Back-Fill	Other Testing:	
Final Inspection Upon Completion of Work		
Community Development Department Approval •		
End of day surface restoration required. (Surfacing material to be used)		
*All compliance testing shall be performed by a qualified independent labor	atory. Frequency of testing shall be in accordance with city specifications.	
(Water Conservancy Districts Exempt) Permit Fee		
Curbing/Sidewalk/Driveway Permit (\$60)	Preconstruction Inspection by: Date	
Pavement Cut/Excavation Permit (\$60)		
Plus \$0.10 per linear foot of trench over 100' in length \$	1 W /	
,, ,	Public Works Permit Approval by Date	
Other 1	Public Works Permit Approval by 3-3-99	
	3-3-99	
Other S	Public Works Permit Approval by 3-3-99  Final Inspection by:  Date	
Other Total Permit Fees	3-3-99	