	10639
FEE\$ 10 Roupt	BLDG PERMIT NO. 72/88
TCP\$ - Paro	
FEE\$ 10 TCP\$ $0$ $0$ $0$ $0$ $0$ $0$ $0$ $0$ $0$ $0$	
My Brent Grand Junction Community Development Department	
* () ノギ ス W THIS SECTION TO BE COMPLETED BY APPLICANT 知	
BLDG ADDRESS 2207 Ron. BLUD	TAX SCHEDULE NO. 2945-183 - 00-062
SUBDIVISION Renaissance	SQ. FT. OF PROPOSED BLDG(S)/ADDITION
FILING BLK LOT	SQ. FT. OF EXISTING BLDG(S)
(1) OWNER PAN Sounders	NO. OF DWELLING UNITS BEFORE:AFTER:THIS CONSTRUCTION
(1) ADDRESS <u>1540 Codap ct.</u> (1) TELEPHONE <u>256-9496</u>	NO. OF BLDGS ON PARCEL BEFORE: AFTER: THIS CONSTRUCTION
<sup>(2)</sup> APPLICANT <u>Schafep</u> const.	USE OF EXISTING BLDGS
2 ADDRESS 478 W. ChUKAP WAY	DESCRIPTION OF WORK AND INTENDED USE:
2) TELEPHONE 434-7502	Single Family posidonce
REQUIRED: Two (2) plot plans, on 8 1/2" x 11" paper, showing all existing and proposed structure location(s), parking, setbacks to all property lines, ingress/egress to the property, and all easements and rights-of-way which abut the parcel.	
THIS SECTION TO BE COMPLETED BY COMMUNITY DEVELOPMENT DEPARTMENT STAFF 18	
ZONE RSF-4	Maximum coverage of lot by structures
SETBACKS: Front from property line (PL)	Parking Req'mt
or 50 from center of ROW, whichever is greater	Special Conditions
Side from PL Rear from F	
Maximum Height 32'	CENS.T. <u>[40]</u> T.ZONE <u>63</u> ANNX#
Modifications to this Planning Clearance must be approved, in writing, by the Director of the Community Development Department. The structure authorized by this application cannot be occupied until a final inspection has been completed and a Certificate of Occupancy has been issued by the Building Department (Section 305, Uniform Building Code).	
I hereby acknowledge that I have read this application and the information is correct; I agree to comply with any and all codes, ordinances, laws, regulations or restrictions which apply to the project. I understand that failure to comply shall result in legal action, which may include but not necessarily be limited to non-use of the building(s).	
Applicant Signature Miltor Schope Date 9-29-99	
Department Approval Julia Reputa - King Ree Date 10/4/99	
Additional water and/or sewer tap fee(s) are required: YES NO W/O No 11452	
Utility Accounting VAINCC	Date 10449


Utility Accounting \_\_\_\_\_\_ Date \_\_\_\_\_ Date \_\_\_\_\_ Date \_\_\_\_\_\_ Date \_\_\_\_\_\_ VALID FOR SIX MONTHS FROM DATE OF ISSUANCE (Section 9-3-2C Grand Junction Zoning & Development Code)

(White: Planning)

(Yellow: Customer)

(Pink: Building Department)

(Goldenrod: Utility Accounting)

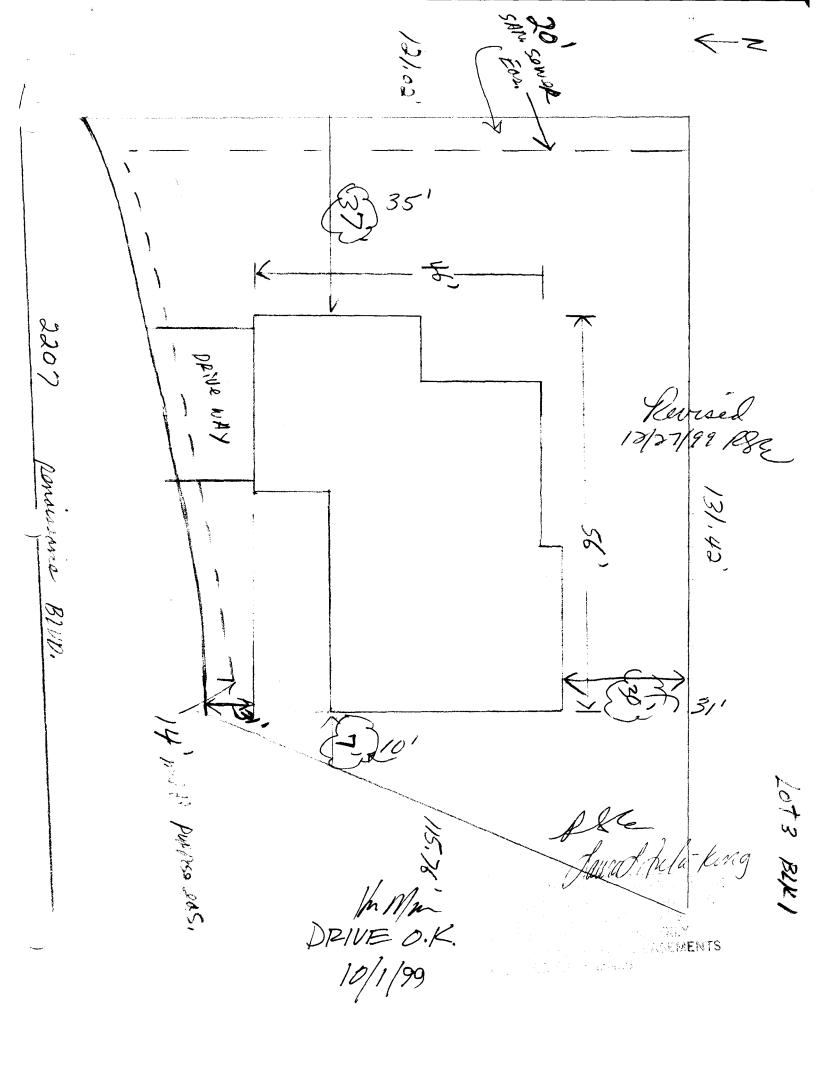

· .