

FEE \$	10
TCP \$	500
SIF \$	0



BLDG PERMIT NO. 72580

**PLANNING CLEARANCE**

(Single Family Residential and Accessory Structures)  
**Community Development Department**

*(Handwritten mark)*

BLDG ADDRESS 372 Ridge Circle Dr SCHEDULE NO. 2945-201-05-027  
 SUBDIVISION Ridges SQ. FT. OF PROPOSED BLDG(S)/ADDITION 2,162  
 FILING 4 BLK 12 LOT 27 & SQ. FT. OF EXISTING BLDG(S) —  
 (1) OWNER Terrance & Riba Taylor NO. OF DWELLING UNITS  
 BEFORE: 0 AFTER: 1 THIS CONSTRUCTION  
 (1) ADDRESS 4609 Toad Stool Ln  
 NO. OF BLDGS ON PARCEL  
 BEFORE: 0 AFTER: 1 THIS CONSTRUCTION  
 (1) TELEPHONE 702-453-4636  
 (2) APPLICANT / USE OF EXISTING BLDGS —  
 (2) ADDRESS / Same DESCRIPTION OF WORK AND INTENDED USE:  
 (2) TELEPHONE / new homes

**REQUIRED: One plot plan, on 8 1/2" x 11" paper, showing all existing & proposed structure location(s), parking, setbacks to all property lines, ingress/egress to the property, driveway location & width & all easements & rights-of-way which abut the parcel.**

**THIS SECTION TO BE COMPLETED BY COMMUNITY DEVELOPMENT DEPARTMENT STAFF**

ZONE PR4 Maximum coverage of lot by structures \_\_\_\_\_  
 SETBACKS: Front 20' from property line (PL) Parking Req'mt 2  
 or \_\_\_\_\_ from center of ROW, whichever is greater  
 Side 10' from PL Rear 10' from PL Special Conditions Acco Req'd  
 Maximum Height 25' excludes chimney INSUS \_\_\_\_\_ TRAFFIC \_\_\_\_\_ ANNEX# \_\_\_\_\_

Modifications to this Planning Clearance must be approved, in writing, by the Community Development Department. The structure authorized by this application cannot be occupied until a final inspection has been completed and a Certificate of Occupancy has been issued, if applicable, by the Building Department (Section 305, Uniform Building Code).

I hereby acknowledge that I have read this application and the information is correct; I agree to comply with any and all codes, ordinances, laws, regulations or restrictions which apply to the project. I understand that failure to comply shall result in legal action, which may include but not necessarily be limited to non-use of the building(s).

Applicant Signature Riba Taylor Date 6-3-99  
 Department Approval Ronnie Edwards Date 6-3-99

Additional water and/or sewer tap fee(s) are required: YES X NO \_\_\_\_\_ W/O No. 12263

Utility Accounting / Date 4/3/99


VALID FOR SIX MONTHS FROM DATE OF ISSUANCE (Section 9-3-2C Grand Junction Zoning & Development Code)

(White: Planning) (Yellow: Customer) (Pink: Building Department) (Goldenrod: Utility Accounting)

**IN THE SPACE BELOW PLEASE NEATLY DRAW A SITE PLAN SHOWING THE FOLLOWING:**


- 1 - An outline of the PROPERTY LINES with dimensions.
- 2 - An outline of the PROPOSED STRUCTURE with its dimensions.
- 3 - The DISTANCE from existing and/or proposed structure(s) to the front, rear and side property lines.
- 4 - All EASEMENTS or RIGHTS - OF - WAY on the property
- 5 - All other STRUCTURES on the property.
- 6 - All STREETS and ALLEYS adjacent to the property and street names.
- 7 - All existing and proposed DRIVEWAYS.
- 8 - An arrow indicating North.

**FAILURE TO PROVIDE COMPLETE INFORMATION MAY RESULT IN A DELAY IN ISSUANCE OF A PLANNING CLEARANCE.**

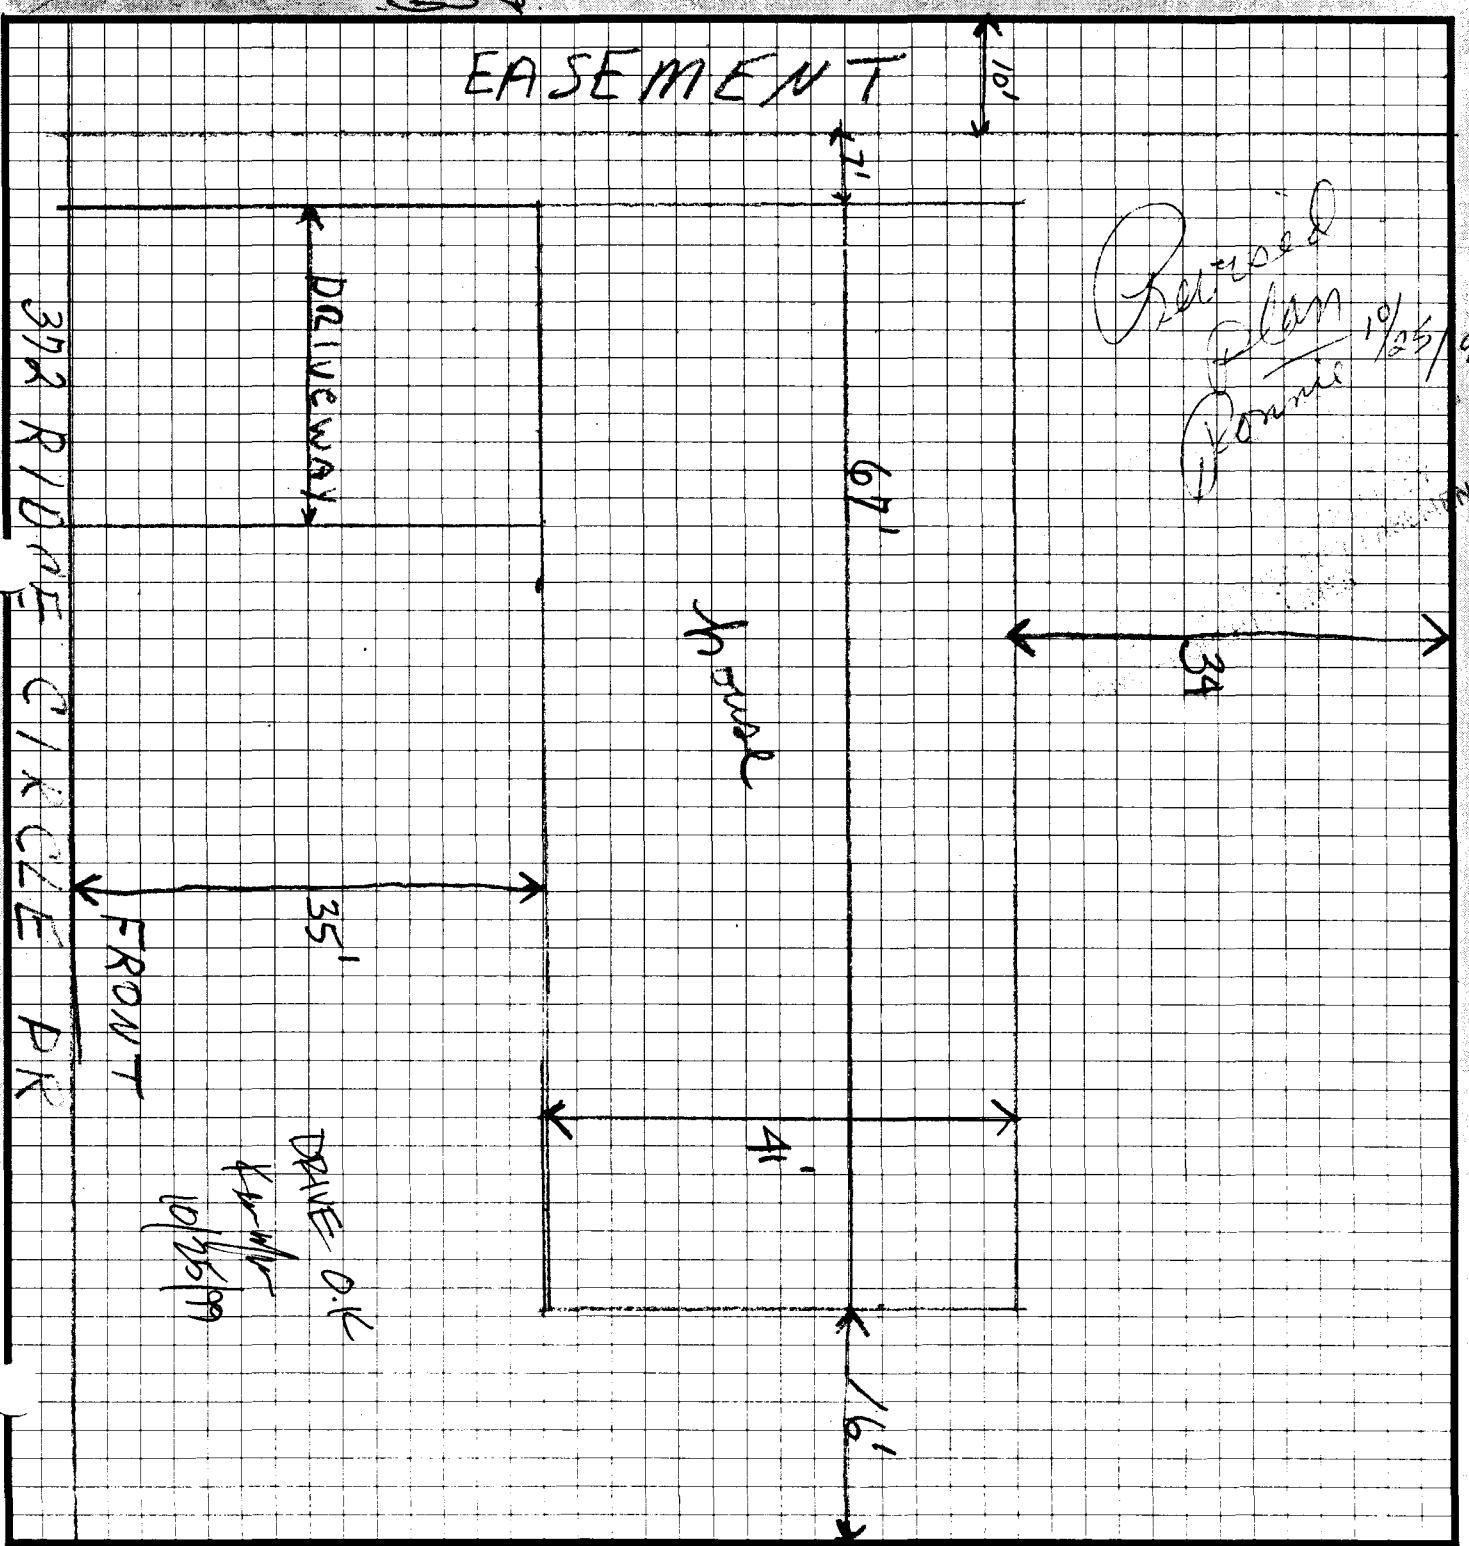

**IN THE SPACE BELOW PLEASE NEATLY DRAW A SITE PLAN SHOWING THE FOLLOWING:**

- 1- An outline of the PROPERTY LINES with dimensions.
- 2- An outline of the PROPOSED STRUCTURE with its dimensions.
- 3- The DISTANCE from existing and/or proposed structure(s) to the front, rear and side property lines.
- 4- All EASEMENTS or RIGHTS - OF - WAY on the property
- 5- All other STRUCTURES on the property.
- 6- All STREETS and ALLEYS adjacent to the property and street names.
- 7- All existing and proposed DRIVEWAYS.
- 8- An arrow indicating North.

**FAILURE TO PROVIDE COMPLETE INFORMATION MAY RESULT IN A DELAY IN ISSUANCE OF A PLANNING CLEARANCE.**

