
FEE \$ 10 <sup></sup> PLANNING CL   TCP \$ 181 <sup></sup> (Single Family Residential and Community Developed on the second on the seco	d Accessory Structures)
	Your Bridge to a Better Community
BLDG ADDRESS 2814 Ridge Dr TAX SCHEDULE NO. 2943-662-22-014	SQ. FT. OF PROPOSED BLDGS/ADDITION/FT
TAX SCHEDULE NO. 2943-662-22-014	SQ. FT. OF EXISTING BLDGS
SUBDIVISION Grand View	TOTAL SQ. FT. OF EXISTING & PROPOSED 1984 4 FT
	NO. OF DWELLING UNITS:
"OWNER Concept Builders	Before: <u>O</u> After: <u>I</u> this Construction NO. OF BUILDINGS ON PARCEL
(1) ADDRESS 2616 H34 Rd	Before: After: this Construction
(1) TELEPHONE 241-1050	USE OF EXISTING BUILDINGS <u>New Home</u>
	DESCRIPTION OF WORK & INTENDED USE
<sup>(2)</sup> ADDRESS SAME	TYPE OF HOME PROPOSED: Site Built Manufactured Home (UBC) Manufactured Home (HUD)
	Other (please specify)
	Il existing & proposed structure location(s), parking, setbacks to all ation & width & all easements & rights-of-way which abut the parcel.
- Real THIS SECTION TO BE COMPLETED BY CO	MMUNITY DEVELOPMENT DEPARTMENT STAFF 📨
ZONE <u><i>RSF-5</i></u>	Maximum coverage of lot by structures
SETBACKS: Front <b>2</b> <sup>3</sup> / from property line (PL) or <u>15</u> from center of ROW, whichever is greater	Permanent Foundation Required: YESNO
Side <u>5</u> from PL, Rear <u>25</u> from PL	Parking Regimt
Maximum Height 32	Special Conditions
Maximum Height $3 J$	CENSUS 10 TRAFFIC 22 ANNX#

Modifications to this Planning Clearance must be approved, in writing, by the Community Development Department. The structure authorized by this application cannot be occupied until a final inspection has been completed and a Certificate of Occupancy has been issued, if applicable, by the Building Department (Section 305, Uniform Building Code).

I hereby acknowledge that I have read this application and the information is correct; I agree to comply with any and all codes, ordinances, laws, regulations or restrictions which apply to the project. I understand that failure to comply shall result in legal action, which may include but not necessarily be limited to non-use of the building(s).

Applicant Signature Department Approval _	Ponnte Ed	wards	Date	9-28-99 9-29-99	
Additional water and/or	r sewer tap fee(s) are require	d: YES	NO	W/O NO. 12597	
Utility Accounting	lara Man	200 Cale	Date 9 -	29. 99	
VALID FOR SIX MONTHS FROM DATE OF ISSUANCE (Section 9-3-2C Grand Junction Zoning & Development Code)					
(White: Planning)	ر (Yellow: Customer)	(Pink: Building Dep	oartment)	(Goldenrod: Utility Accounting)	

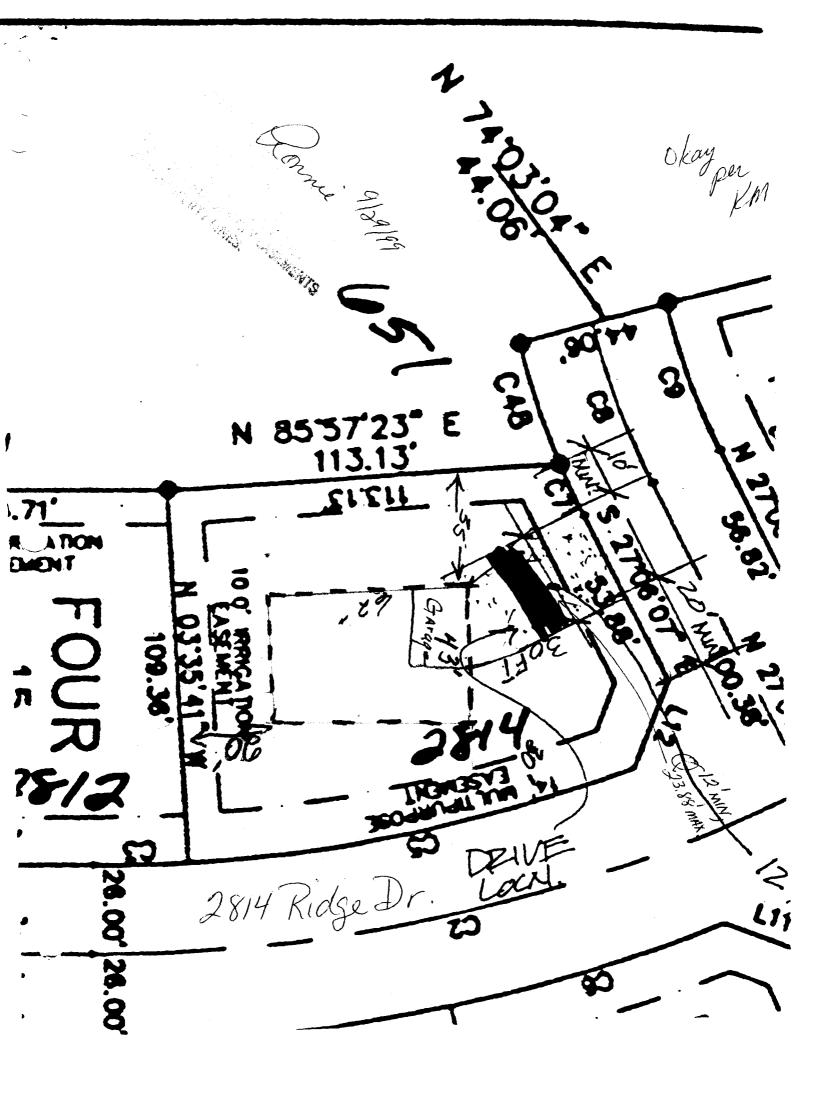

Charles Rec Level Rec 9) of and

